
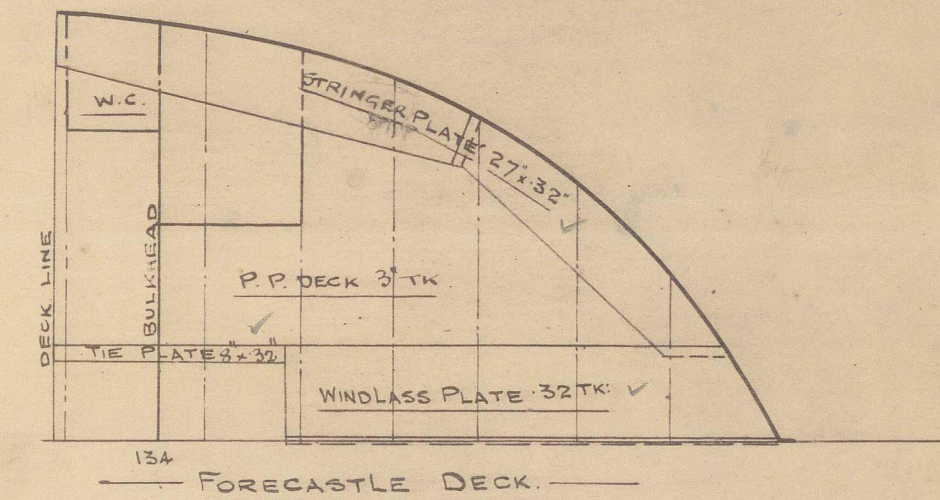
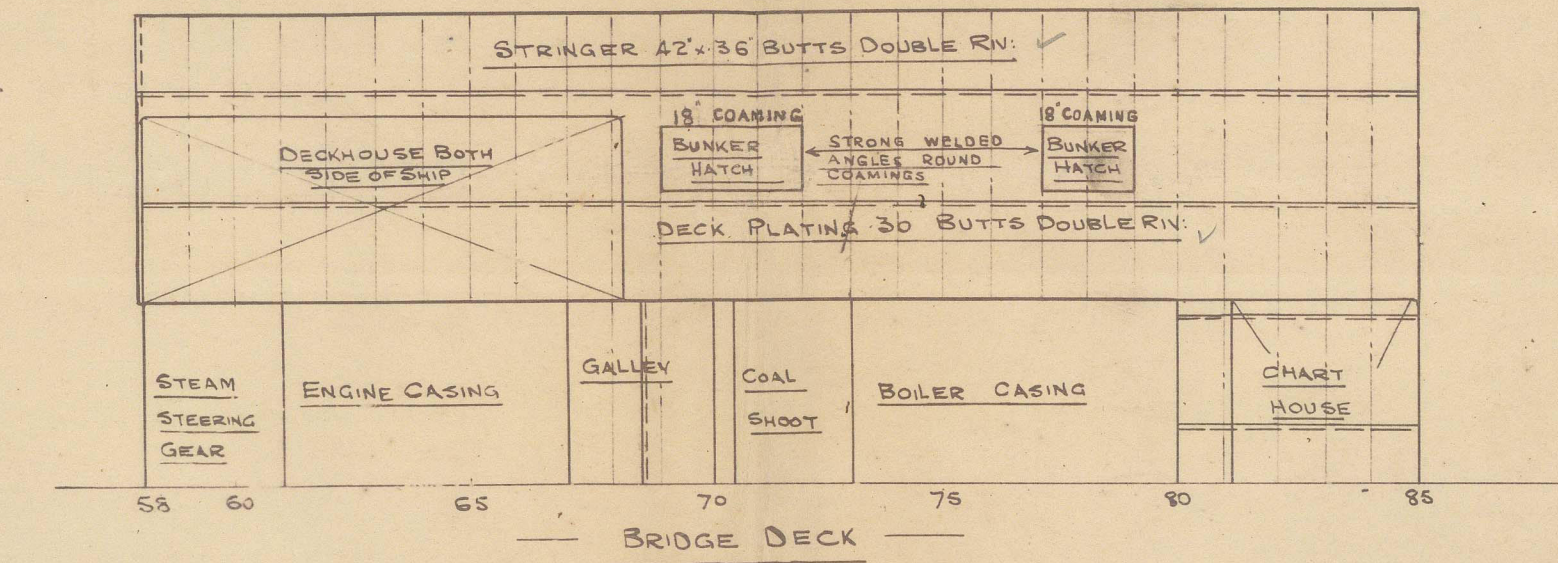



# DECK PLANS NO. 243 5/8.

SCALE 1/8" = ONE FOOT.

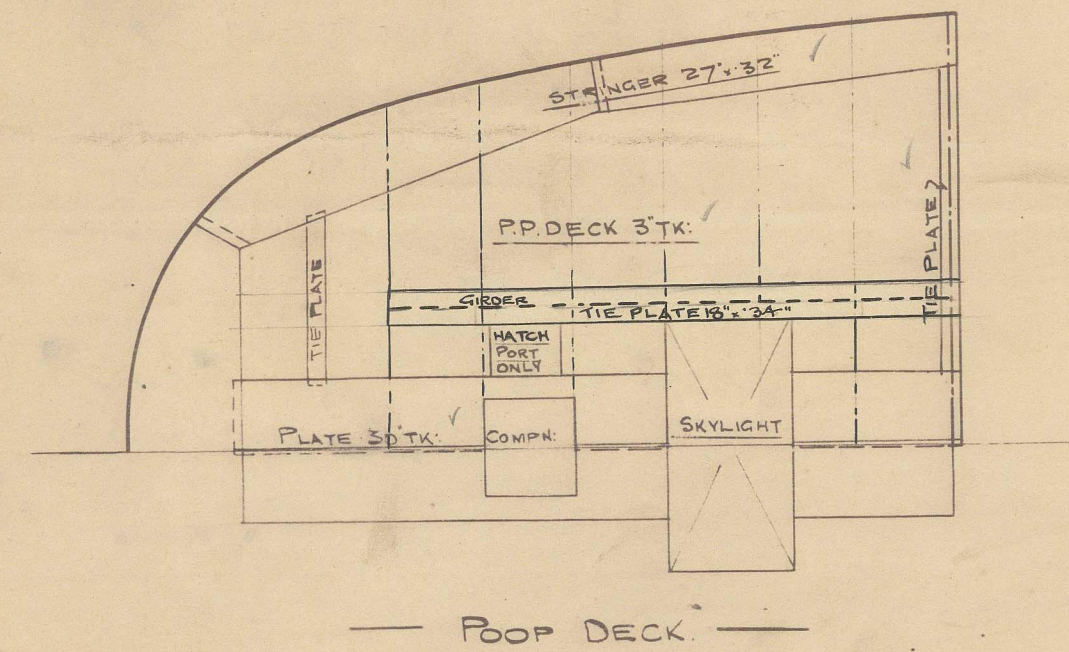

JOHN PRIESTMAN & CO.,  
SHIPBUILDERS,  
SUNDERLAND.

*20/8-13*

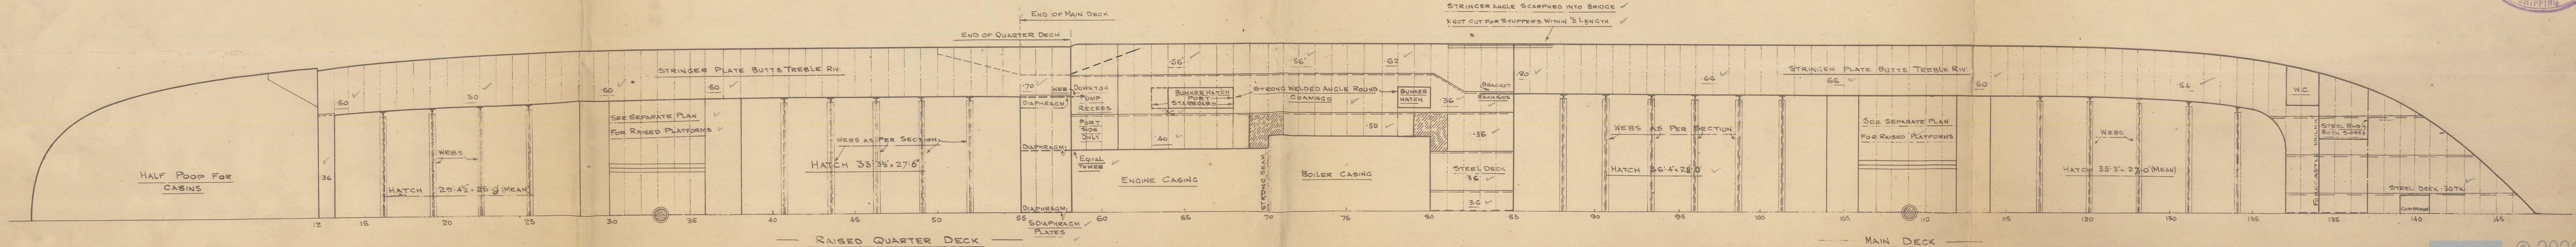



1600-SEEM

S.S. SATRAP

PRIESTMANS N<sup>o</sup> 243

DECK PLAN (AS FITTED)

SLD. RPT. N<sup>o</sup> 25858

RECEIVED

RECEIVED



© 2021

Lloyd's Register  
Foundation