
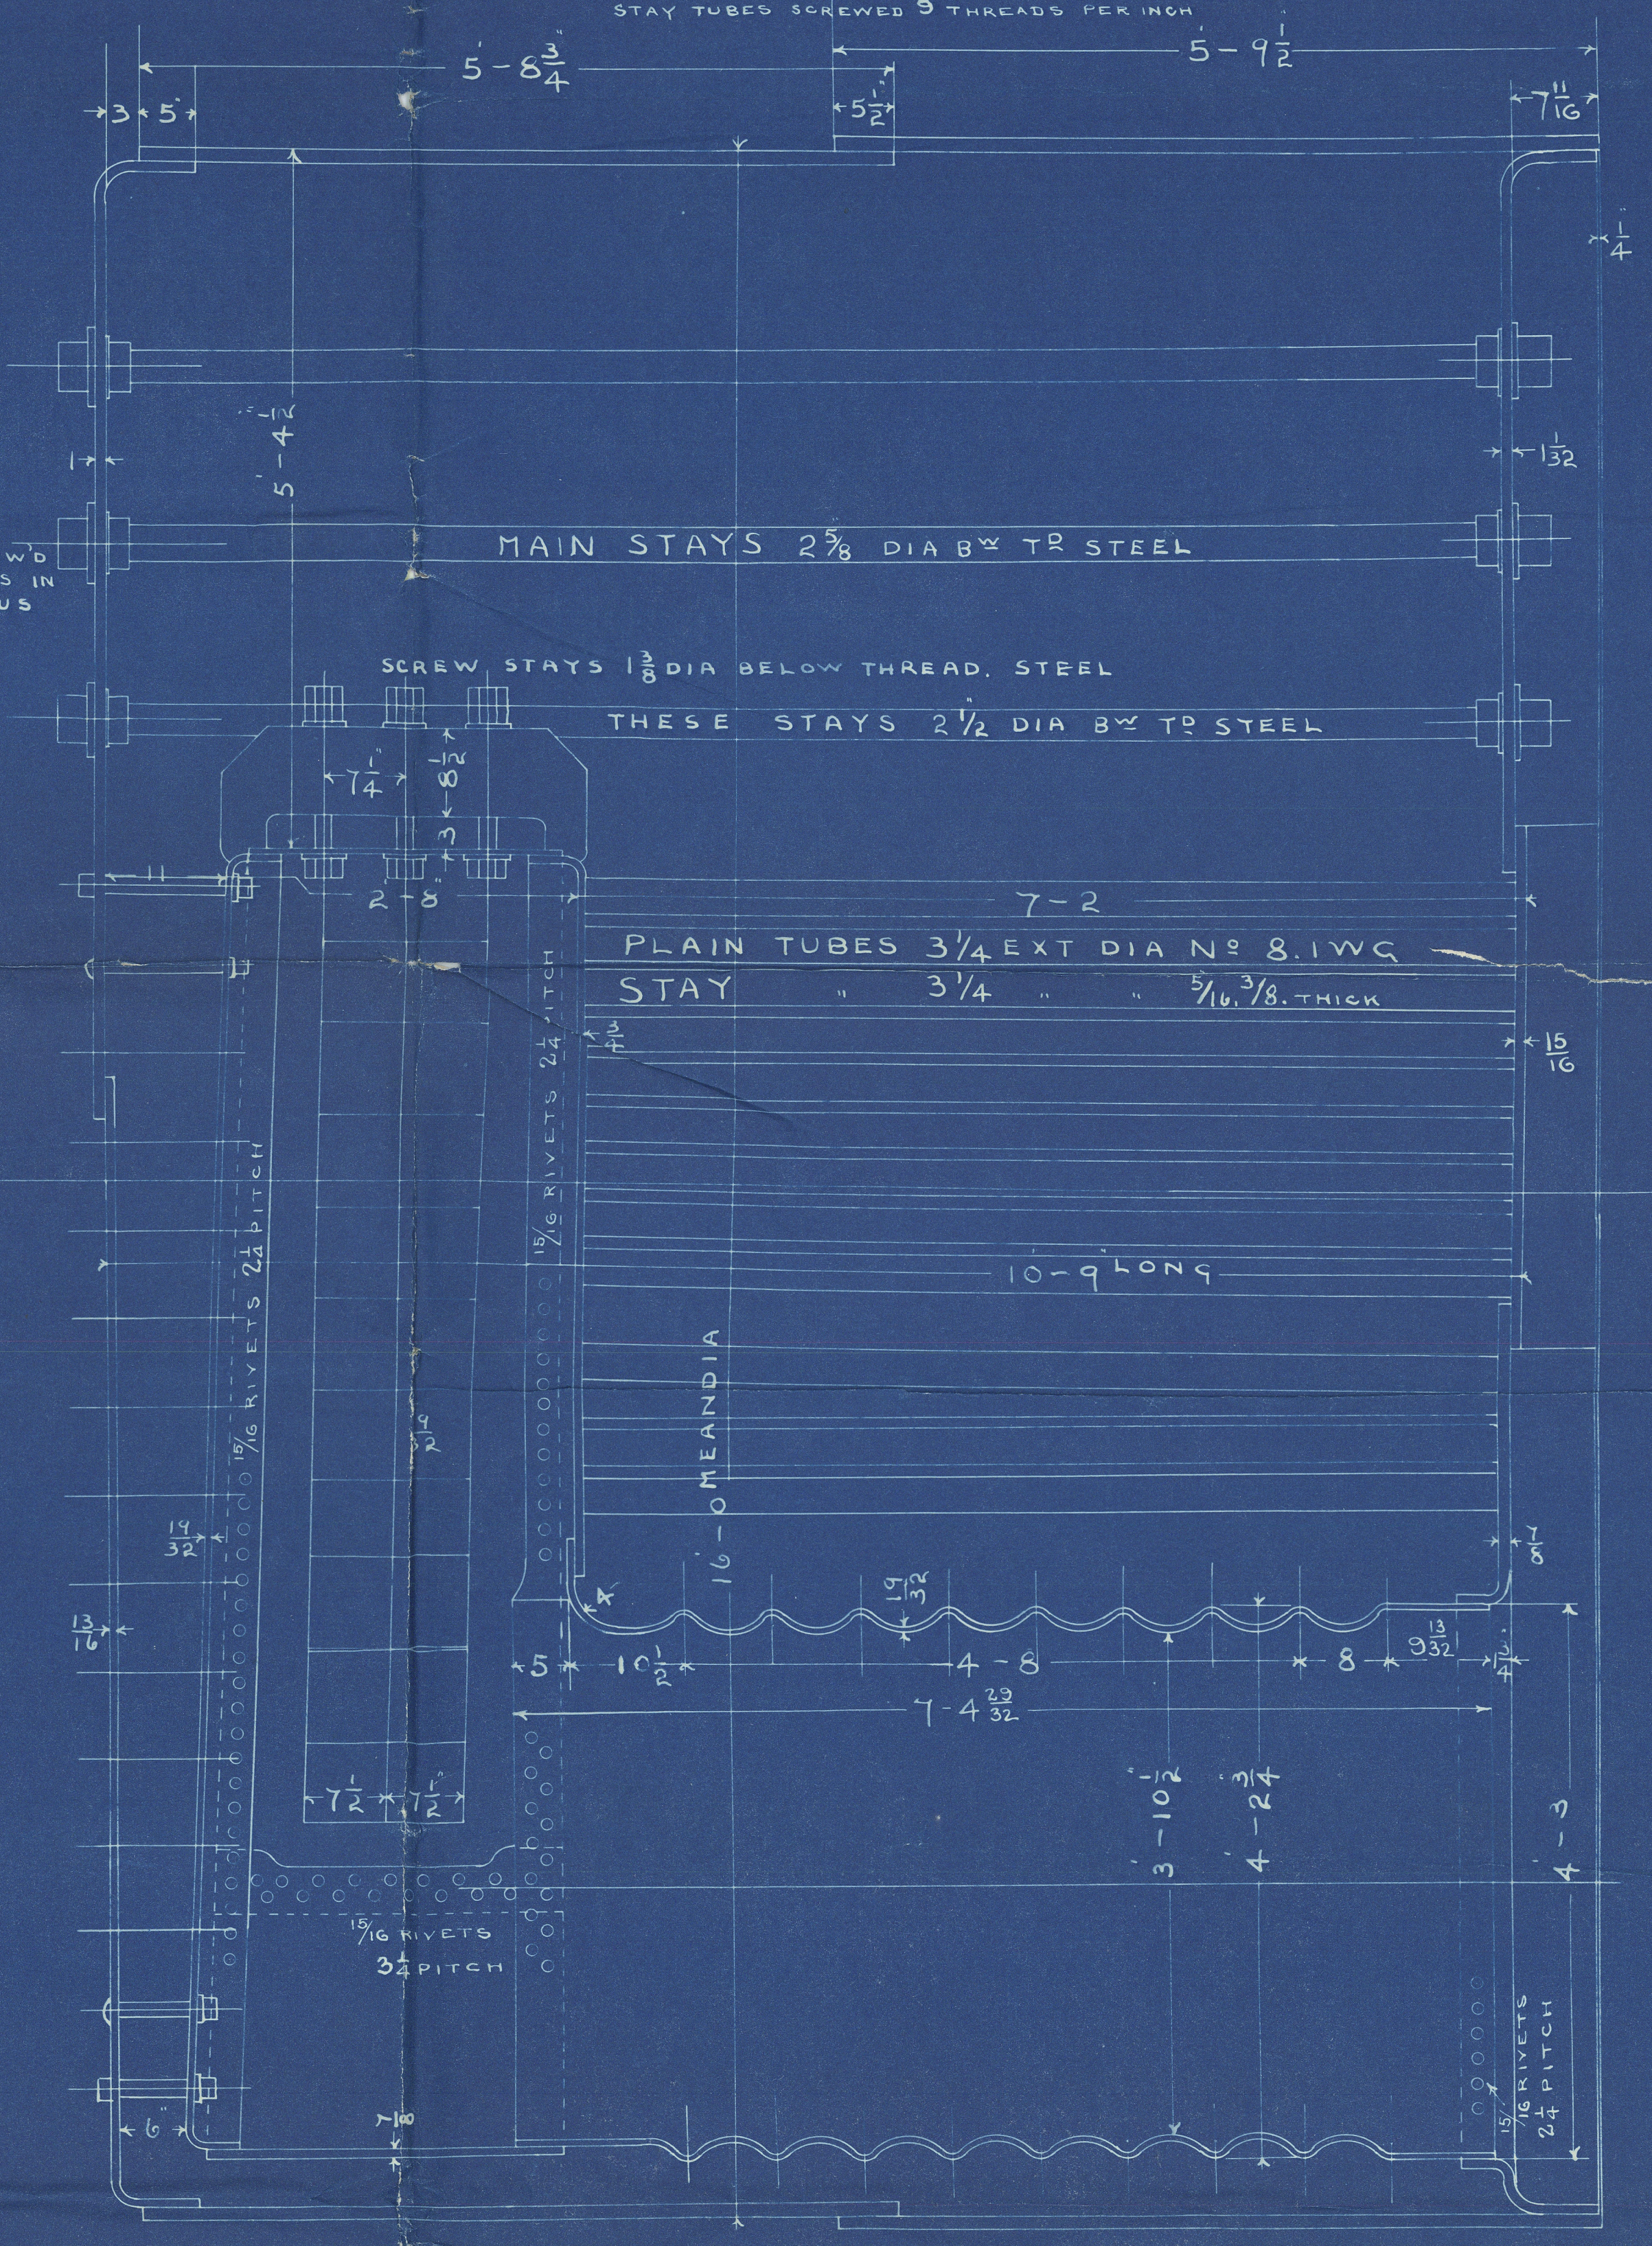
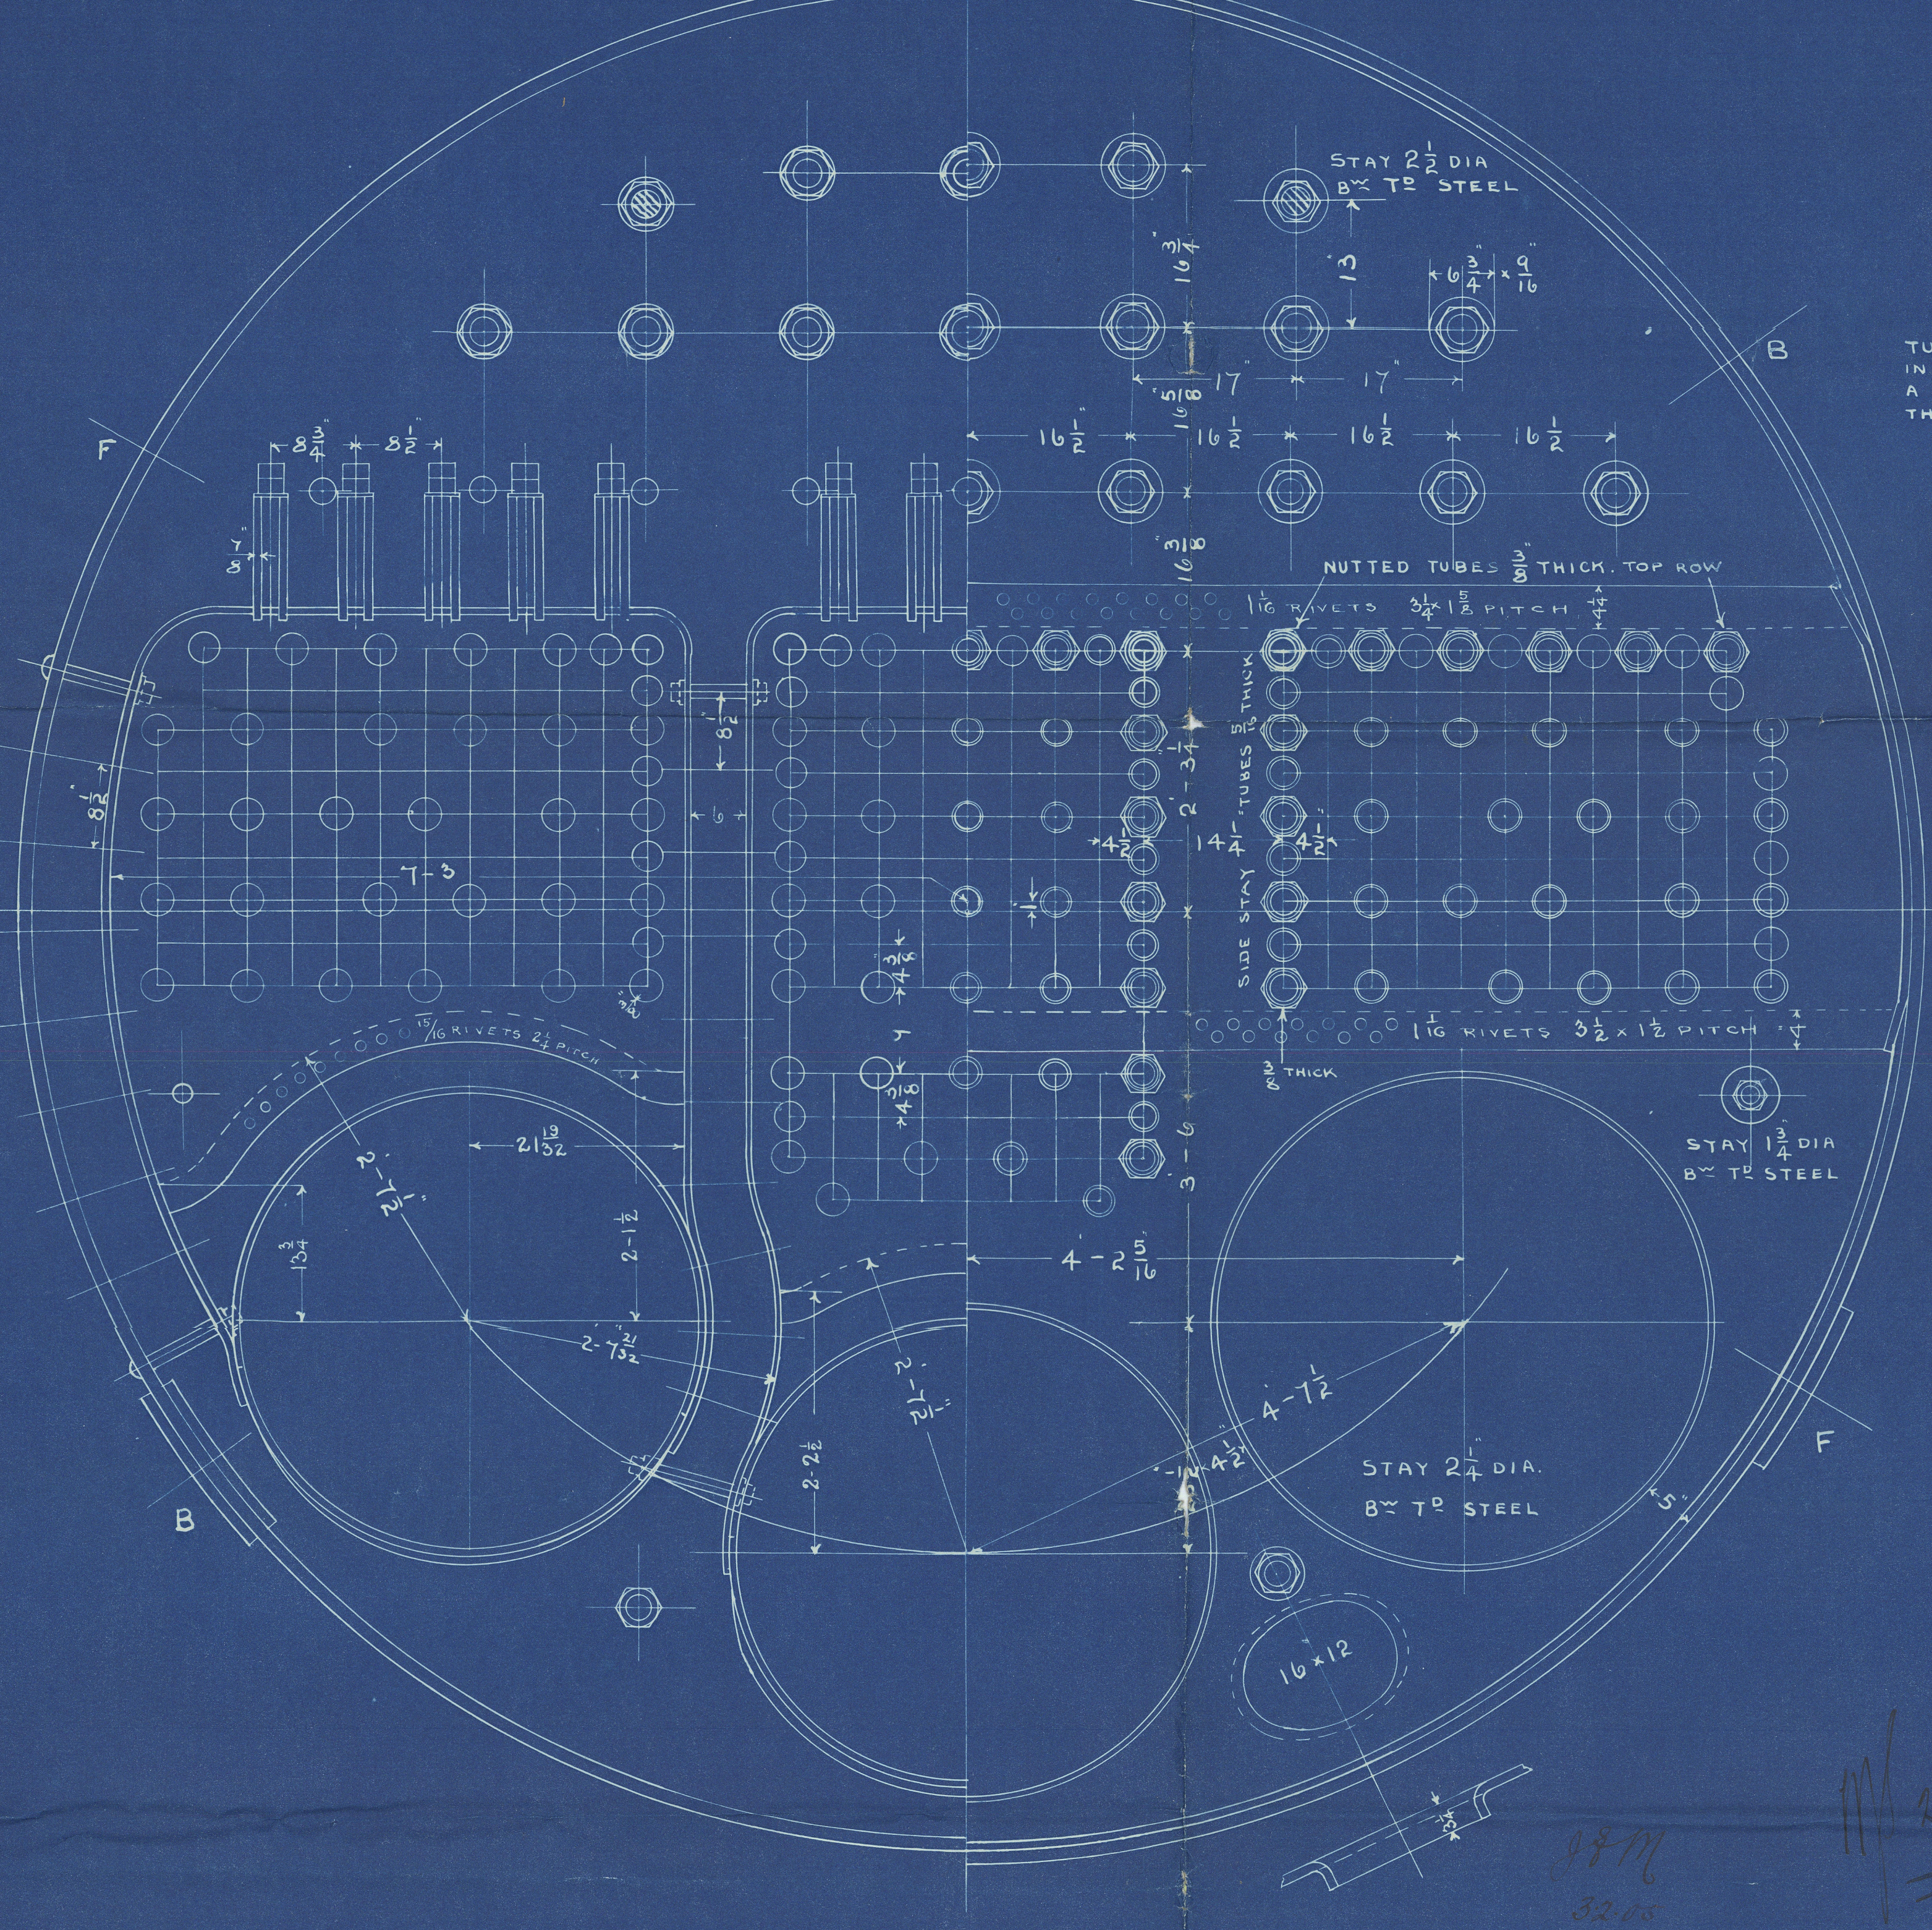
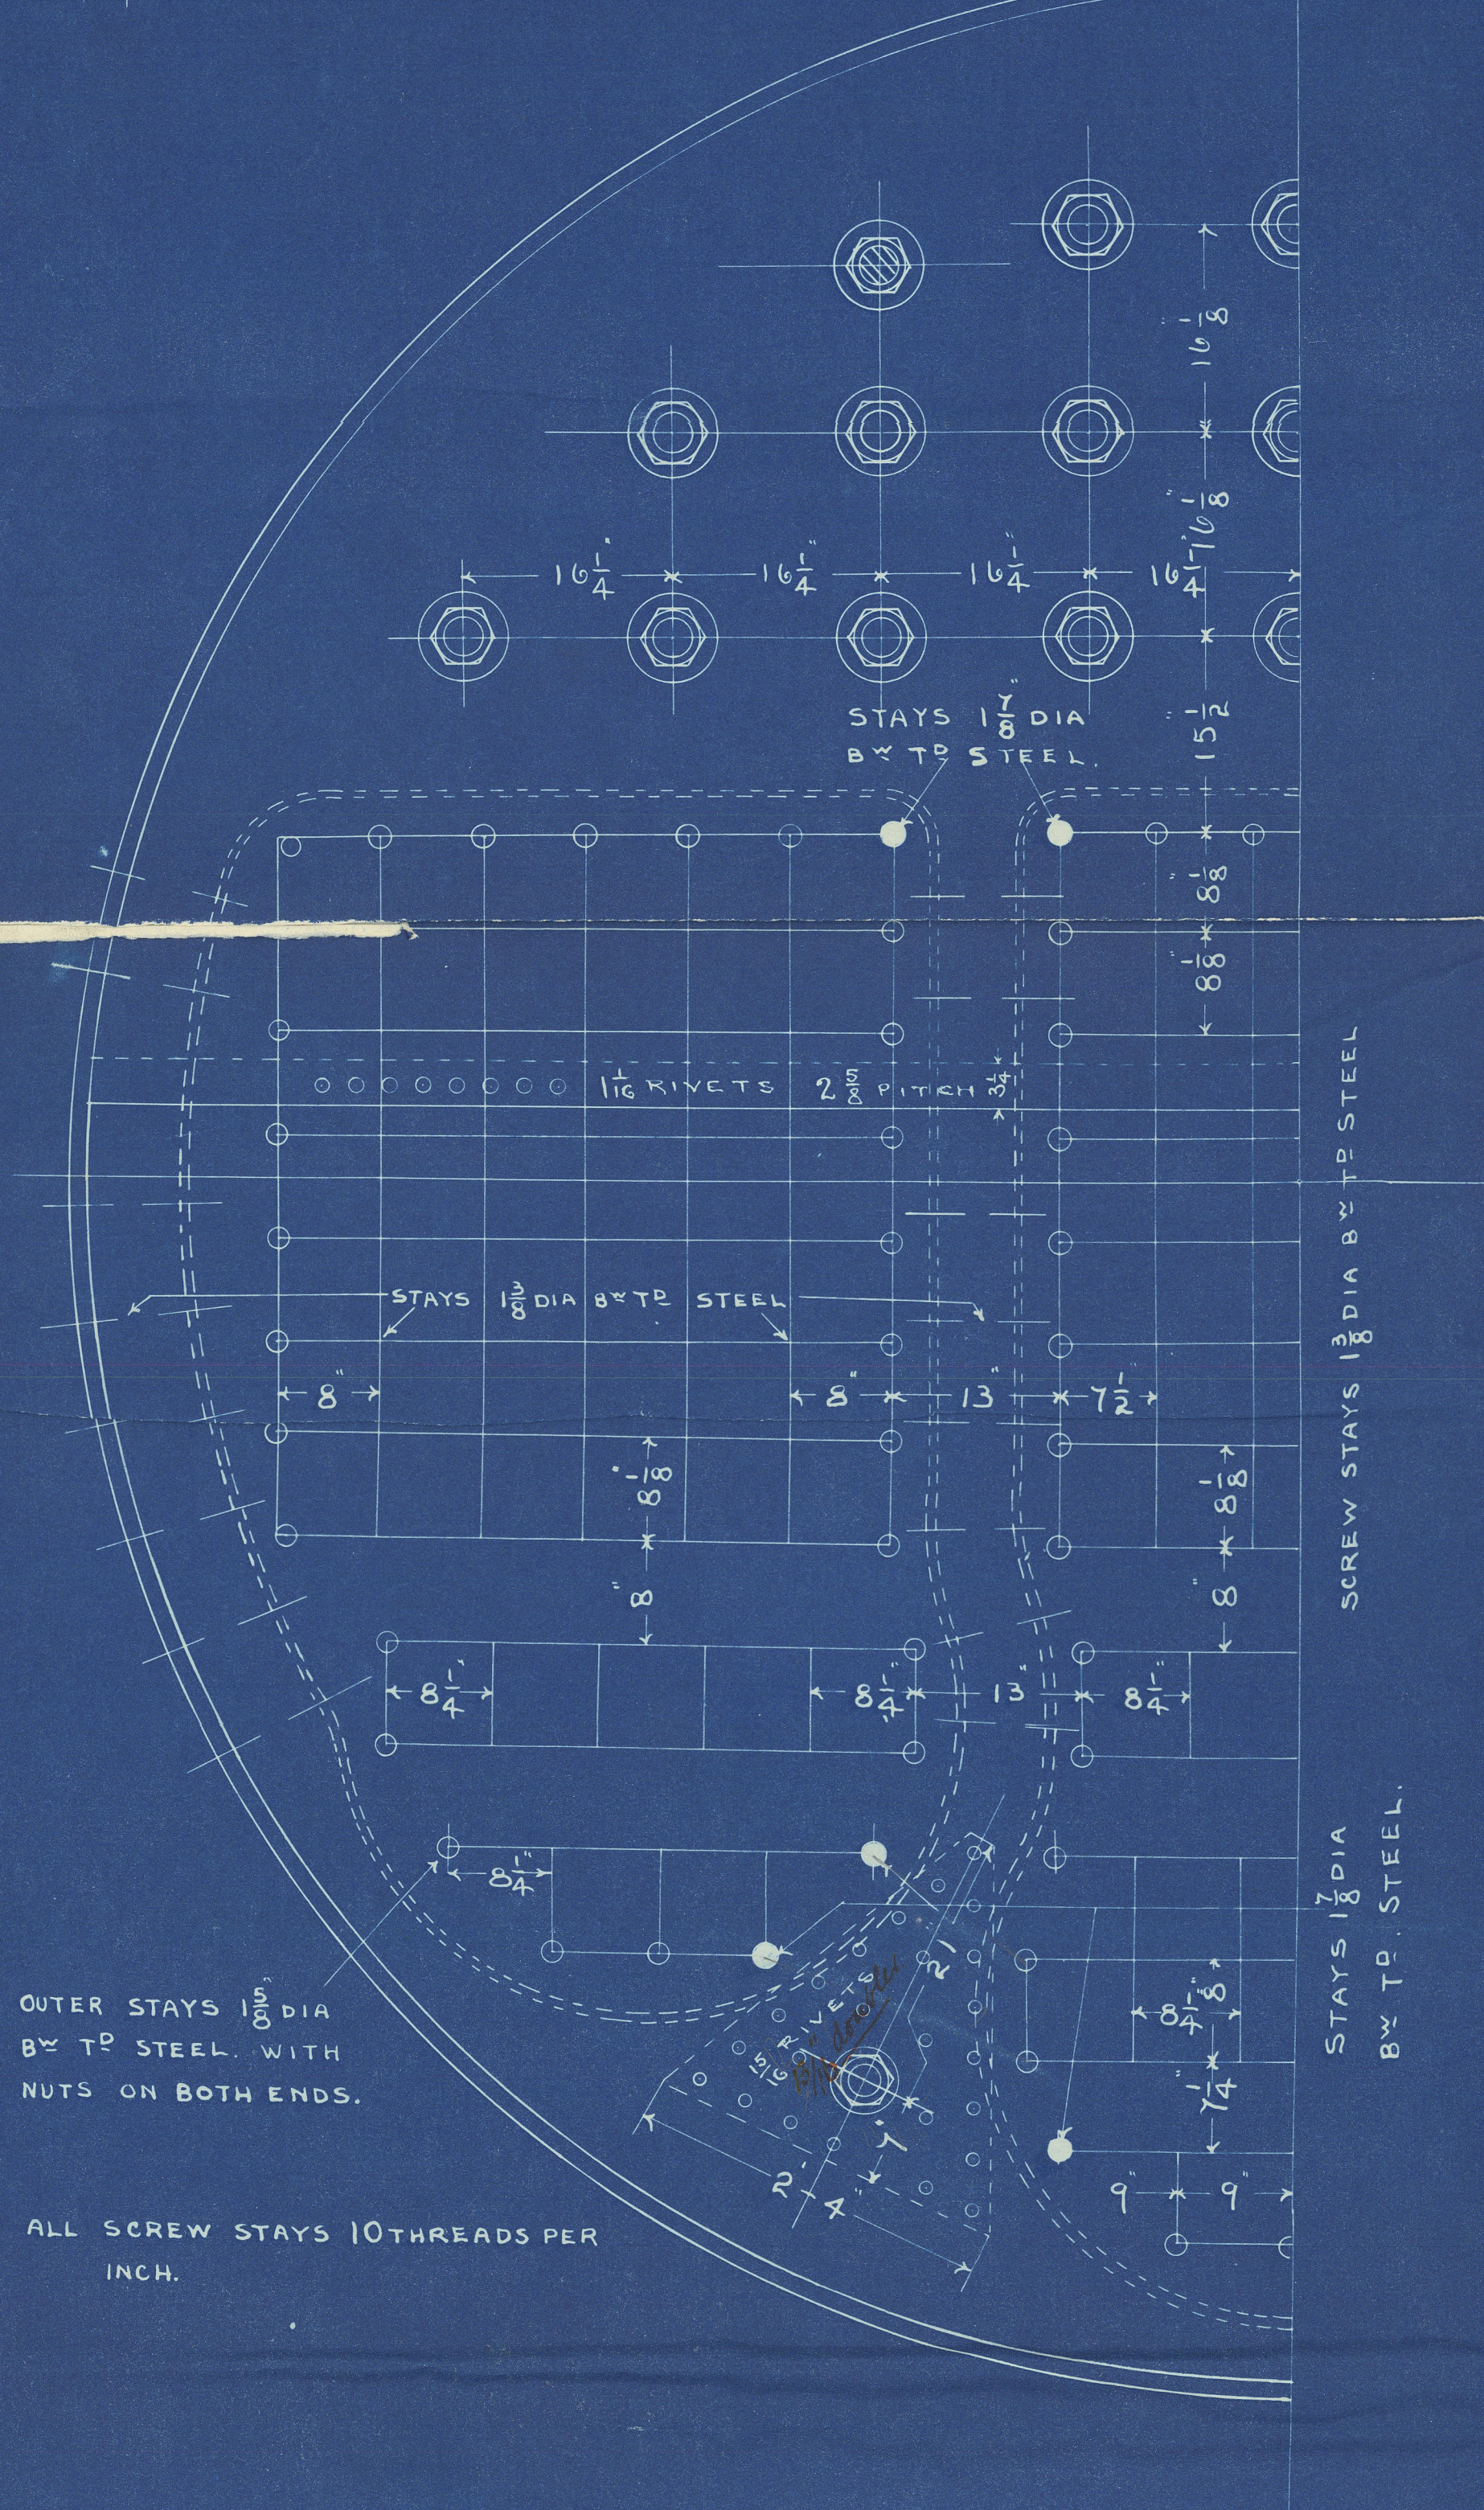



TO BE FITTED TO MESS^{RS} FURNESS, WITHEY & CO'S S.S NOS **284**.
 TO PASS "LLOYDS" SURVEY FOR A WORKING PRESSURE OF 180 LBS. PER SQ.
 TO BE TESTED IN THE PRESENCE OF "LLOYDS" & OWNERS SURVEYORS

*Tensile of shell plate - 28.5 to 32 tons per sq. in.
 " Main stays 27.0 to 32 " " "*

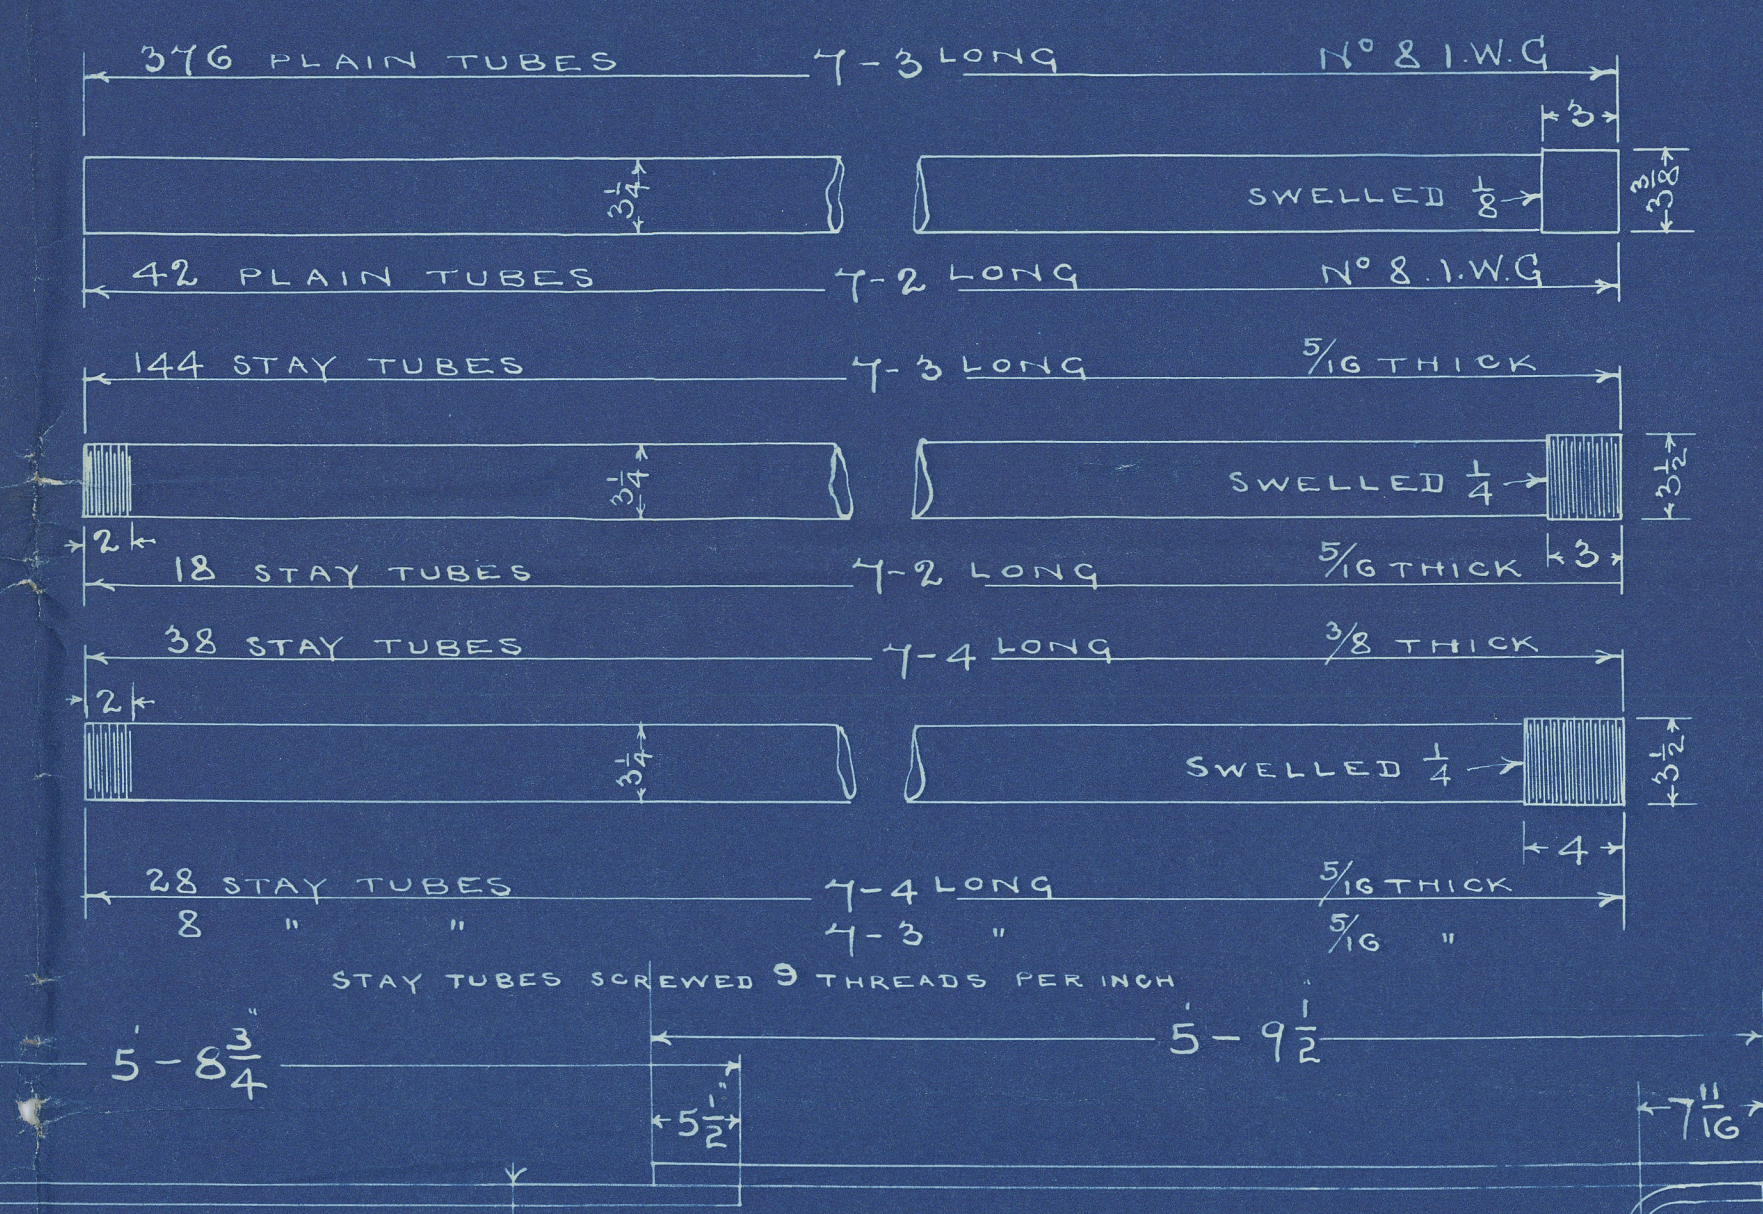

| | |
|--|--------------|
| RICHARDSONS, WESTGARTH & CO. LIMITED. HARTLEPOOL. | |
| NO. OF DRAWING - - | B 1191 |
| NO. OF TRADING - - | 214 82 |
| WHERE SENT - - | Lloyds |
| EXAMINED BY - - | 20/5 |
| DATE - - - - | 31 Jan. 1905 |

BOILERS N° 1199

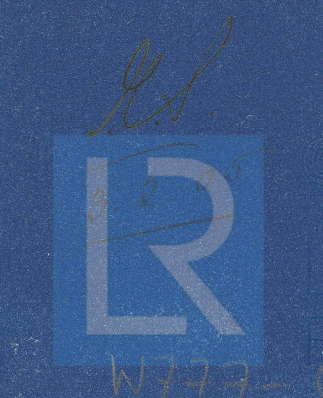


Main Boilers
Furness Mithy & Co
No 284 Vessel

Richardson Westgarth & Co.
(Liverpool)

No 1199 180 lbs
SS "Apollo"

Hpl Rpt. No. 12697

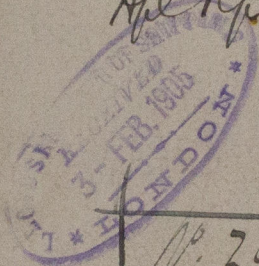

No. 2999
Lloyd's Est
36 lbs
W.S. 29.6.05

RETAIL



© 2020

Lloyd's Register
Foundation