

250. 220. 220. 220. 220.
 250. 220. 220. 220. 220.
 250. 220. 220. 220. 220.



PLAN No. 2232
FOR ENCLOSURE TO
Messrs Lloyds Surveyors
Hull FROM
COCHRANE & SONS, LTD.
SHIPBUILDERS, SELBY.
DATE Nov 18th 1912. R.R.

PROFILE & DECKPLAN

N^{os} 558-9-67-9-70

SCALE $\frac{1}{4}$ " = ONE FOOT

✓ PILLARS THROUGHOUT TO SURVEYOR'S SATISFACTION

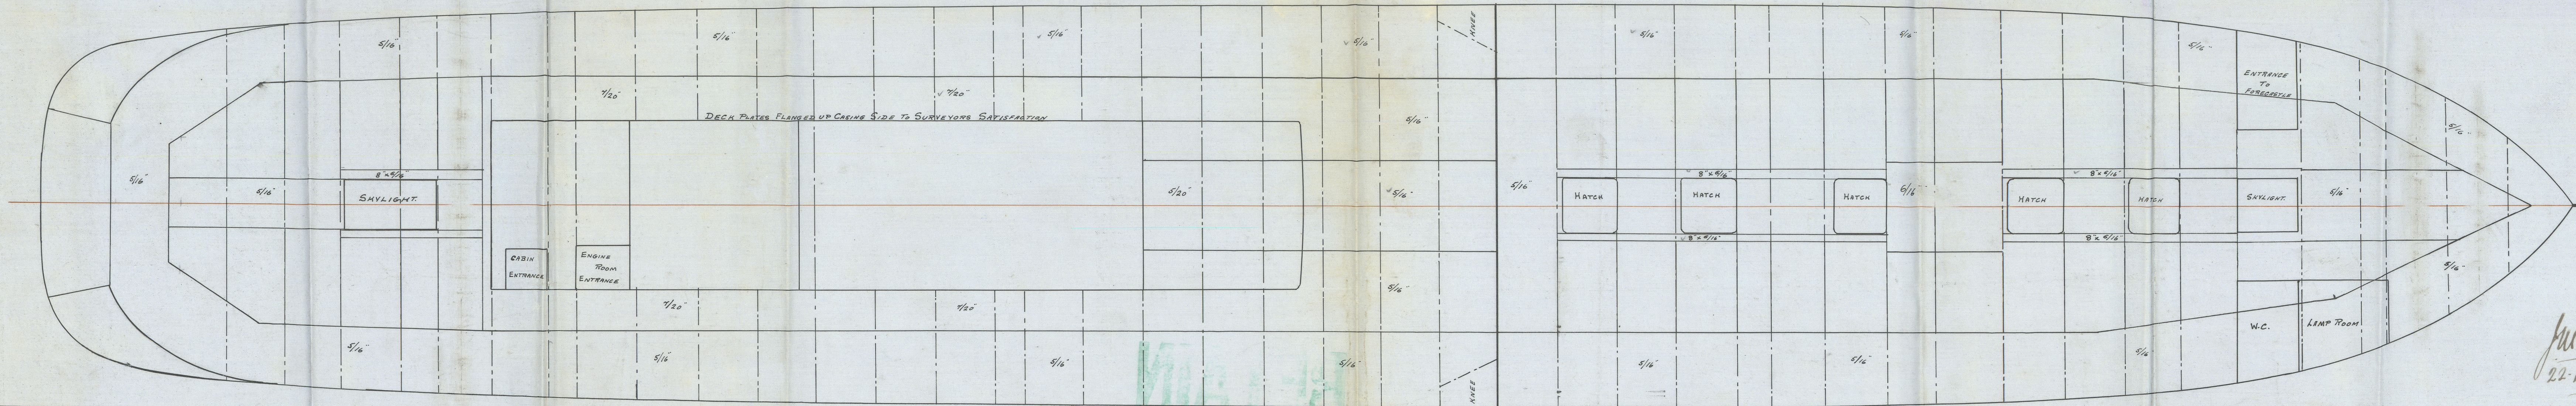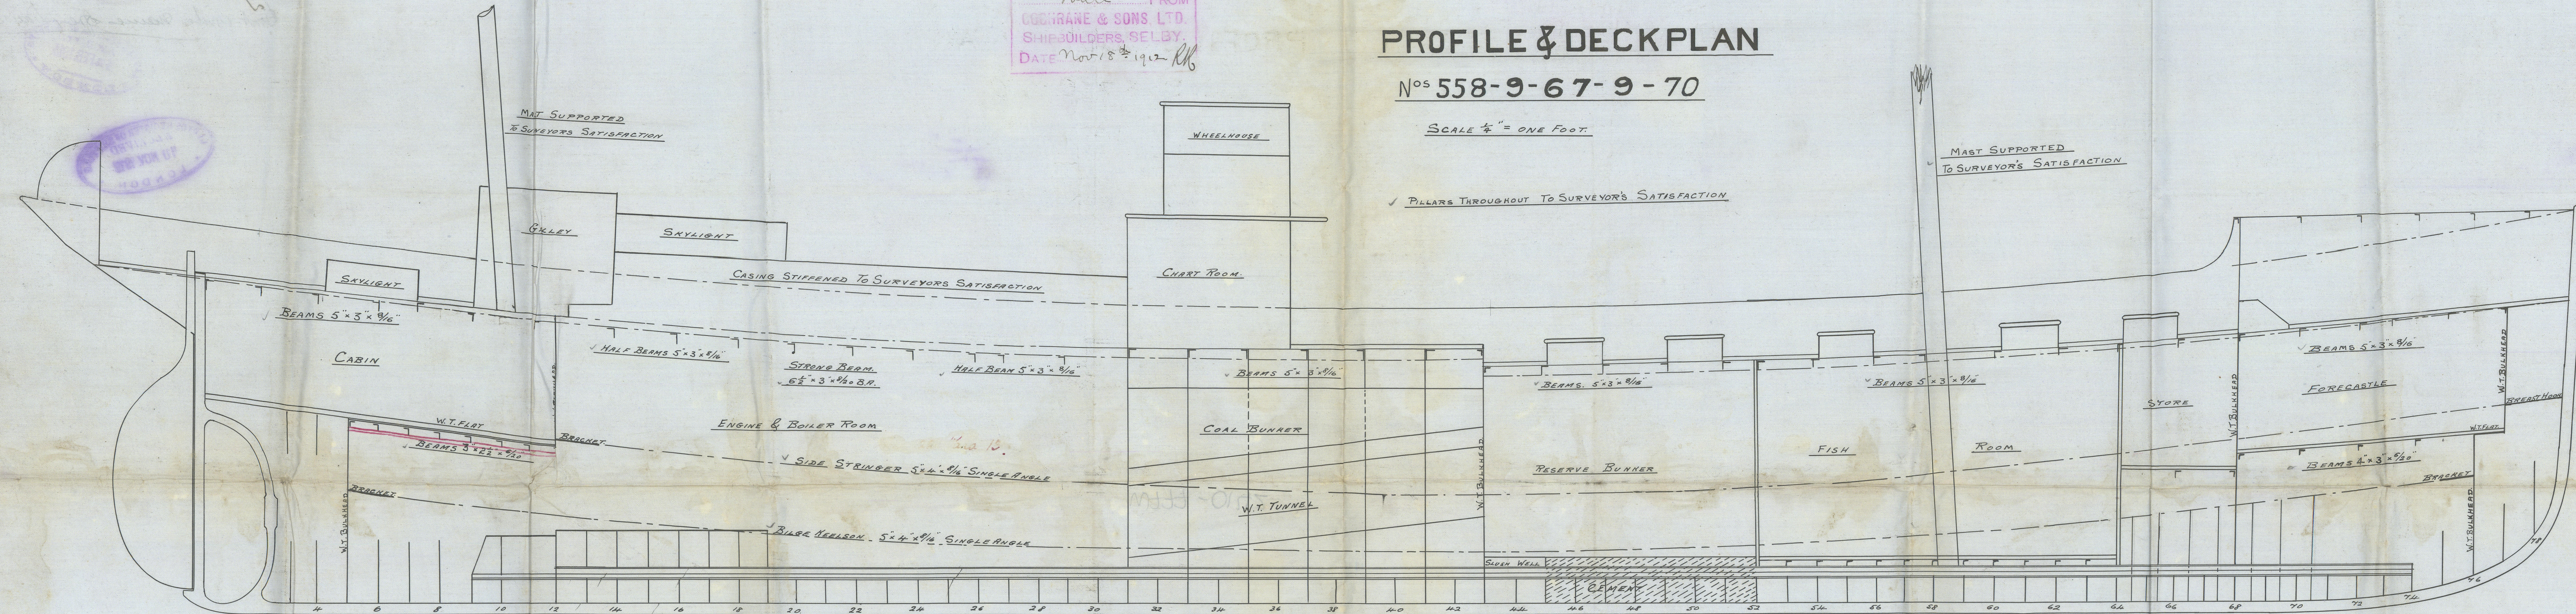

LLOYD'S REGISTER
OF SHIPPING
19 NOV 1912
HULL, ENG

ful.
22-11-12

Cochrane & Sons

No 558. 559. 567.

569 and 570.

Profile and Decks.

Scott's Mill Rpt No: 26336


Shackleton - - - 26380

Lord Lansdown - - - 26457

Elf King - - - 26824

Peary - - - 26888

Can write names of any other.

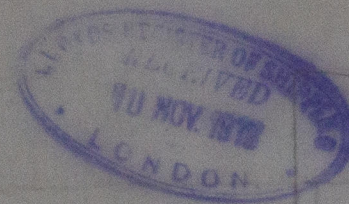

© 2020

Lloyd's Register
Foundation

Lloyd's Register

W777-0142