


22.11.12

PLAN No. 2231
FOR ENCLOSURE TO
Messrs Lloyd's Surveyors
Hull FROM
COCHRANE & SONS, LTD
SHIPBUILDERS, SELBY
DATE Nov 18th 1912 R.R.

MIDSHIP SECTION
STEEL SCREW TRAWLERS
N^os 558-9-67-9-70
DIM^s LEN 133'-4" x 23'-0" E^x x 12'-9" DEPTH MOULDED
SCALE 1/2" = ONE FOOT

TO CLASS 100 AL. FOR FISHING PURPOSES. DECK PLATED OVER IN WAY OF
MACHINERY SPACE. ENGINE & BOILER CASING AS PREVIOUSLY APPROVED

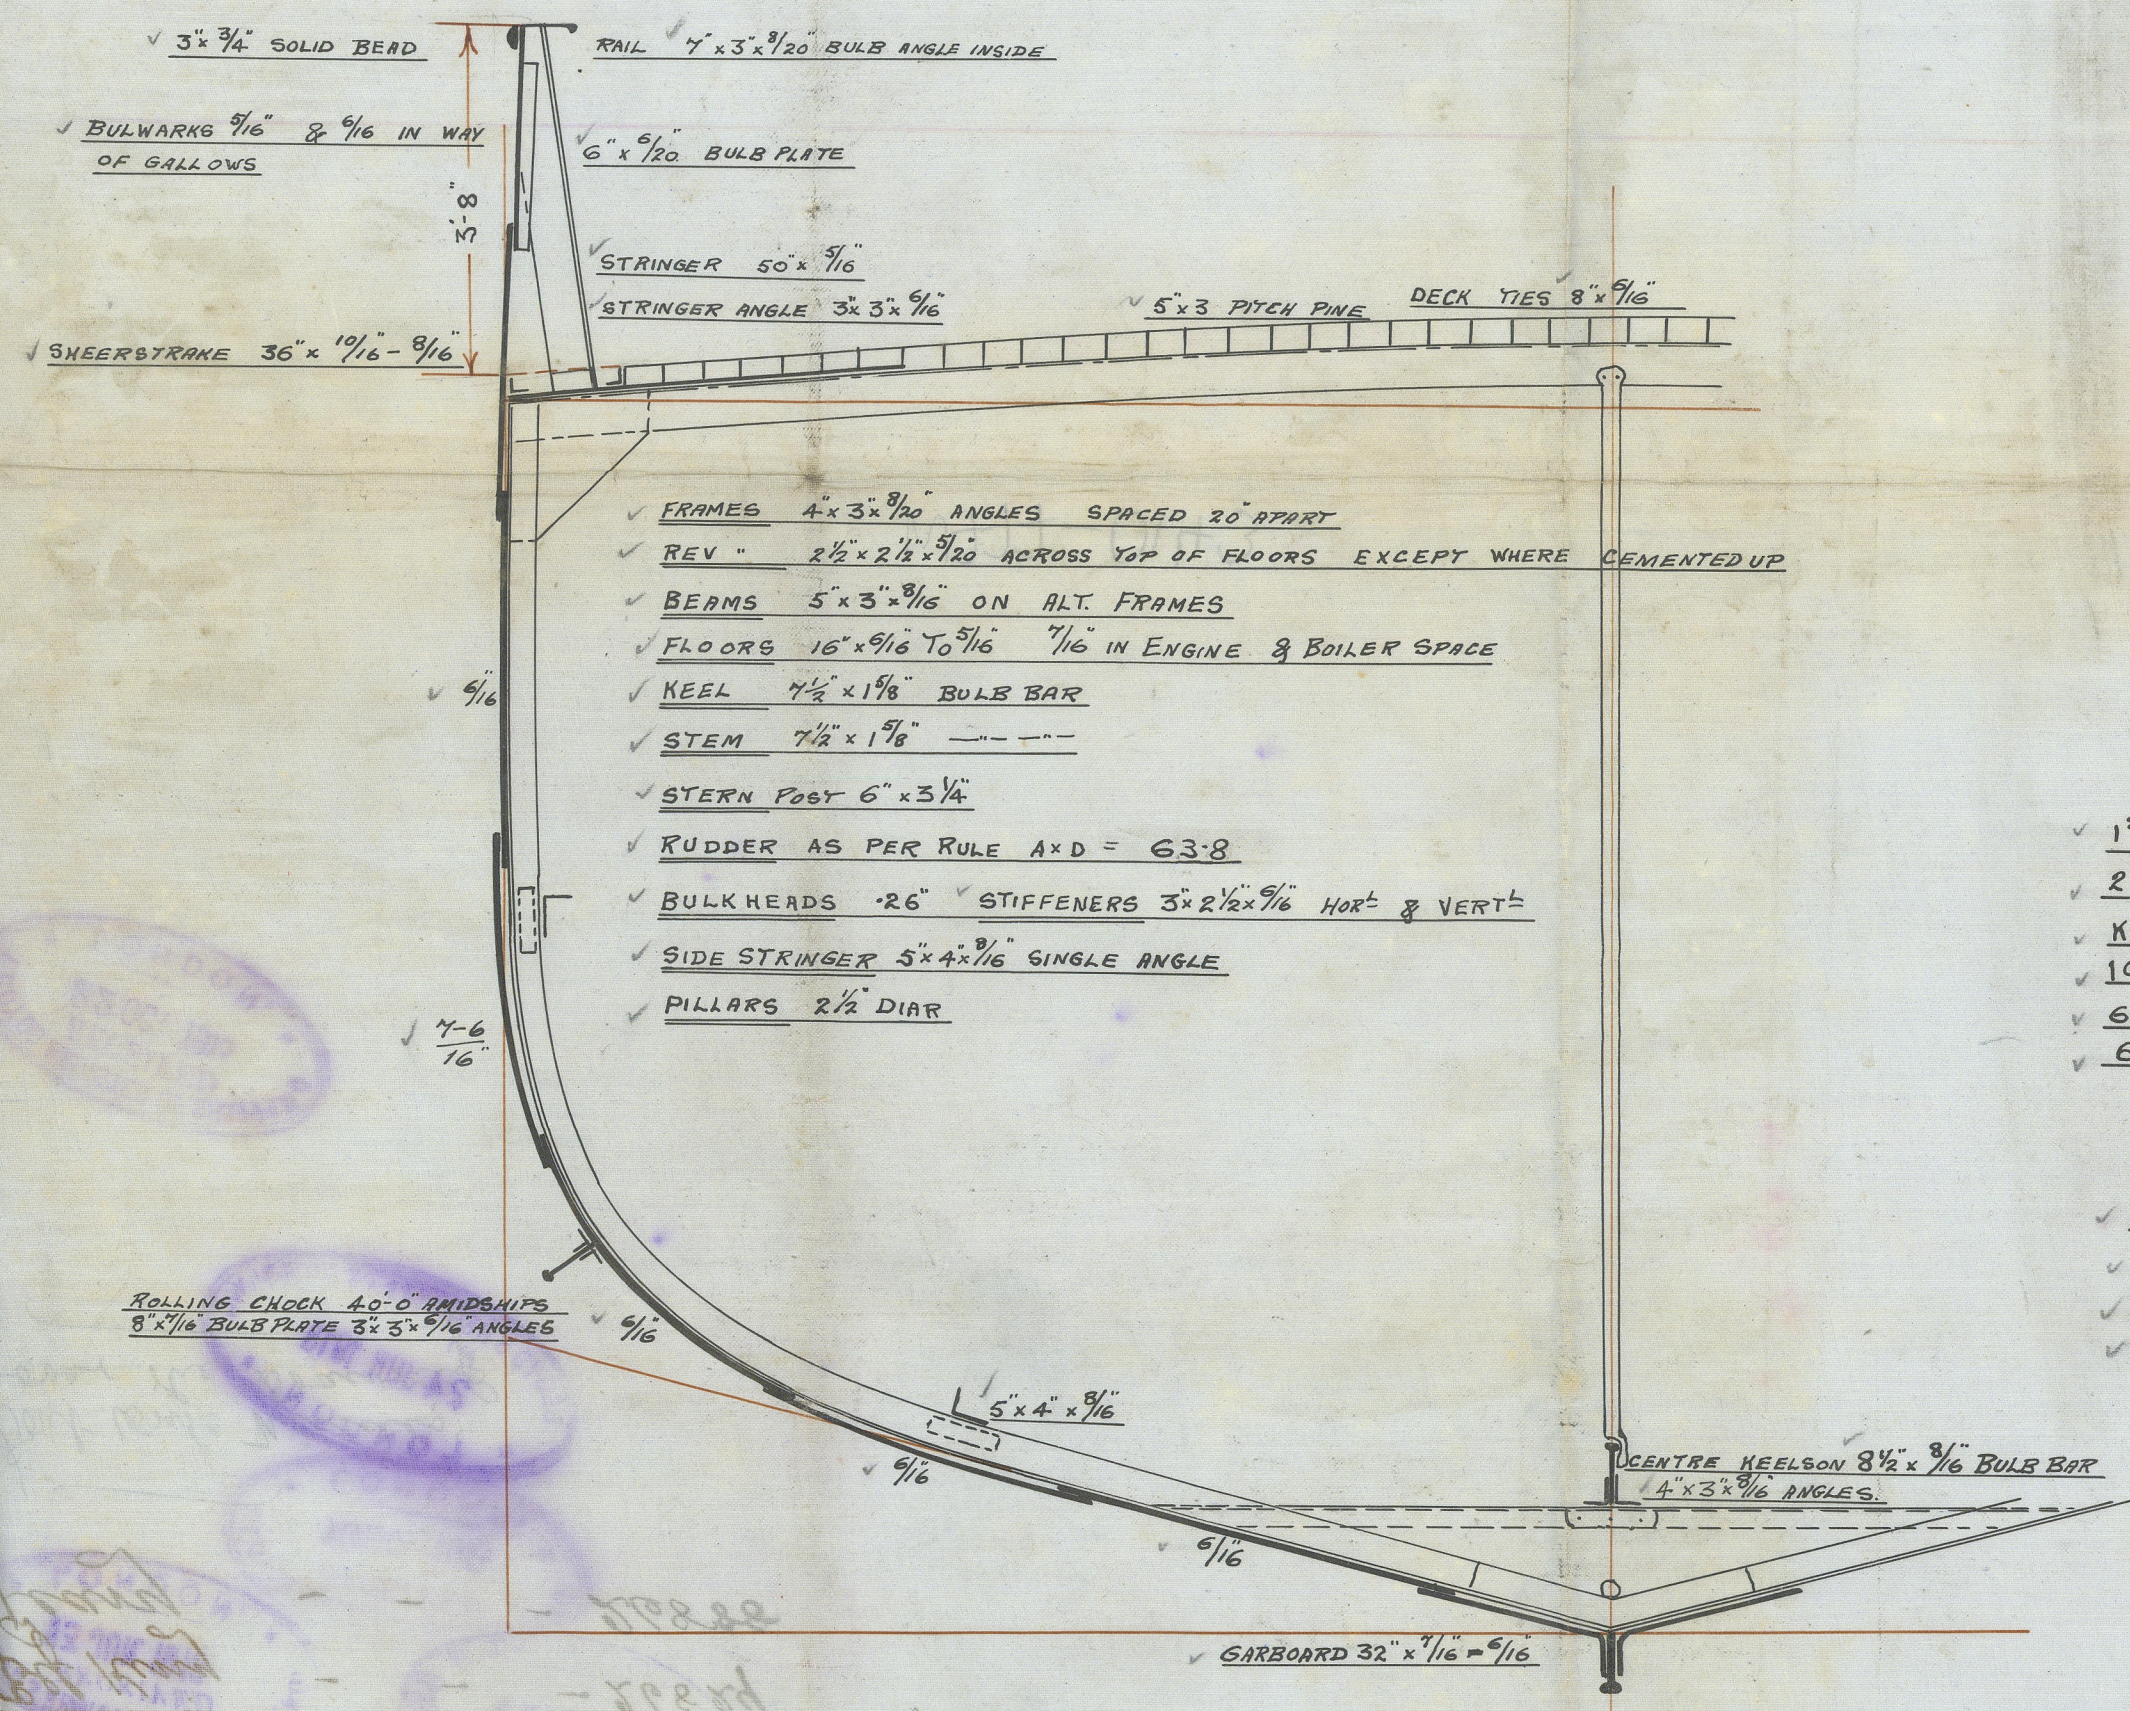

NUMERALS

B+D = 35.63
L x (B+D) = 4750.55

PROPORTIONS

L/D = 10.45
L/B = 5.85

EQUIPMENT

1 ST BOWER ANCHOR	5 3/4 CWTs Ex Stock
2 ND ---	5 1/4 ---
KEDGE	3 ---
105 FATHOMS	1 1/16 CABLE
60 ---	6 HAWSER
60 ---	5 WARP

RIVETING

- BUTTS OF SHELL PLATING LAPPED & DOUBLE RIVETED
- EXCEPT GARBOARD & SHEERSTRAKE WHICH ARE TO BE
- STRAPPED & DOUBLE RIVETED LANDINGS DOUBLE RIVETED
- BULWARKS SINGLE RIVETED

Mr. J. H. G. G. G.
2 P.D. 2 J.O.
No 228. 22d. 2 P.J.

19 NOV 1912

№ 558. 559. 567.

569 and 570.

Midship Section

$\frac{1}{2}$ Scott Hull Report No. 26336

Shackles - 26380

Lord Lansdowne - - - 26457
21 & 211

"Elf King - - - 26824

Feary - - - 26888

Lloyd's Register
Foundation