



11/4/08


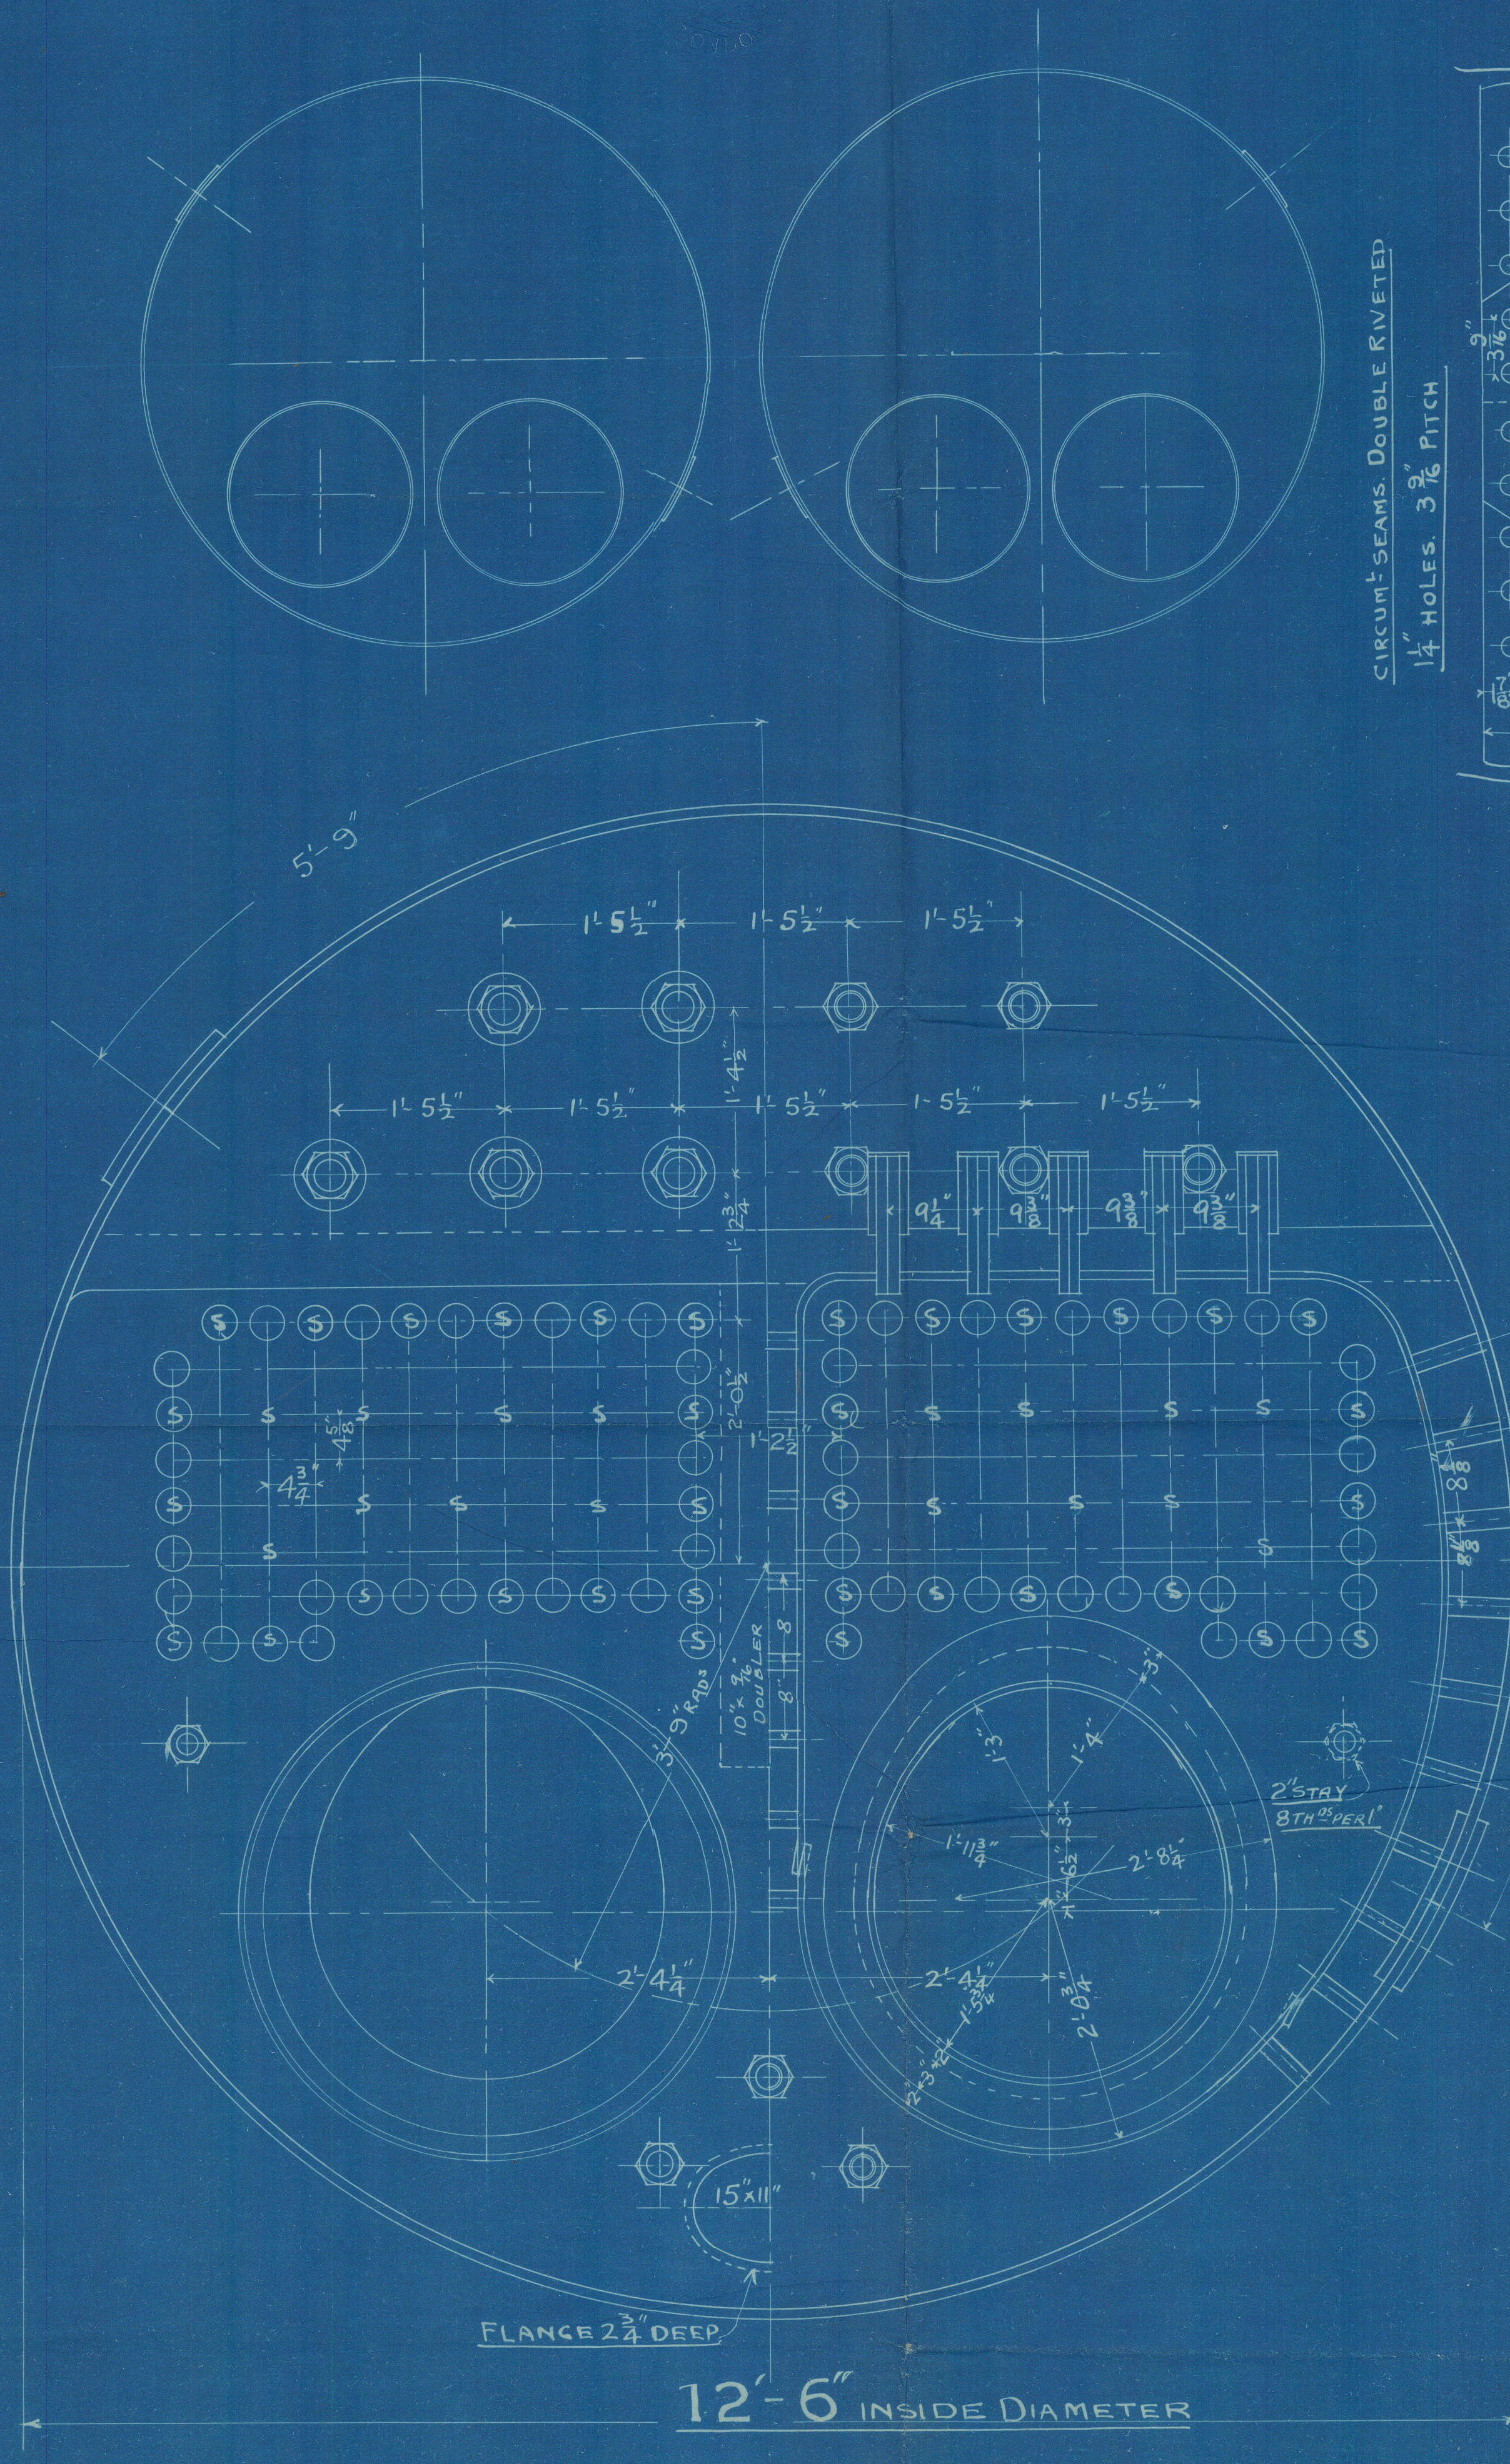


CIRCUMFERENCE DOUBLE RIVETED  
1 1/4" HOLES 3 3/8" PITCH

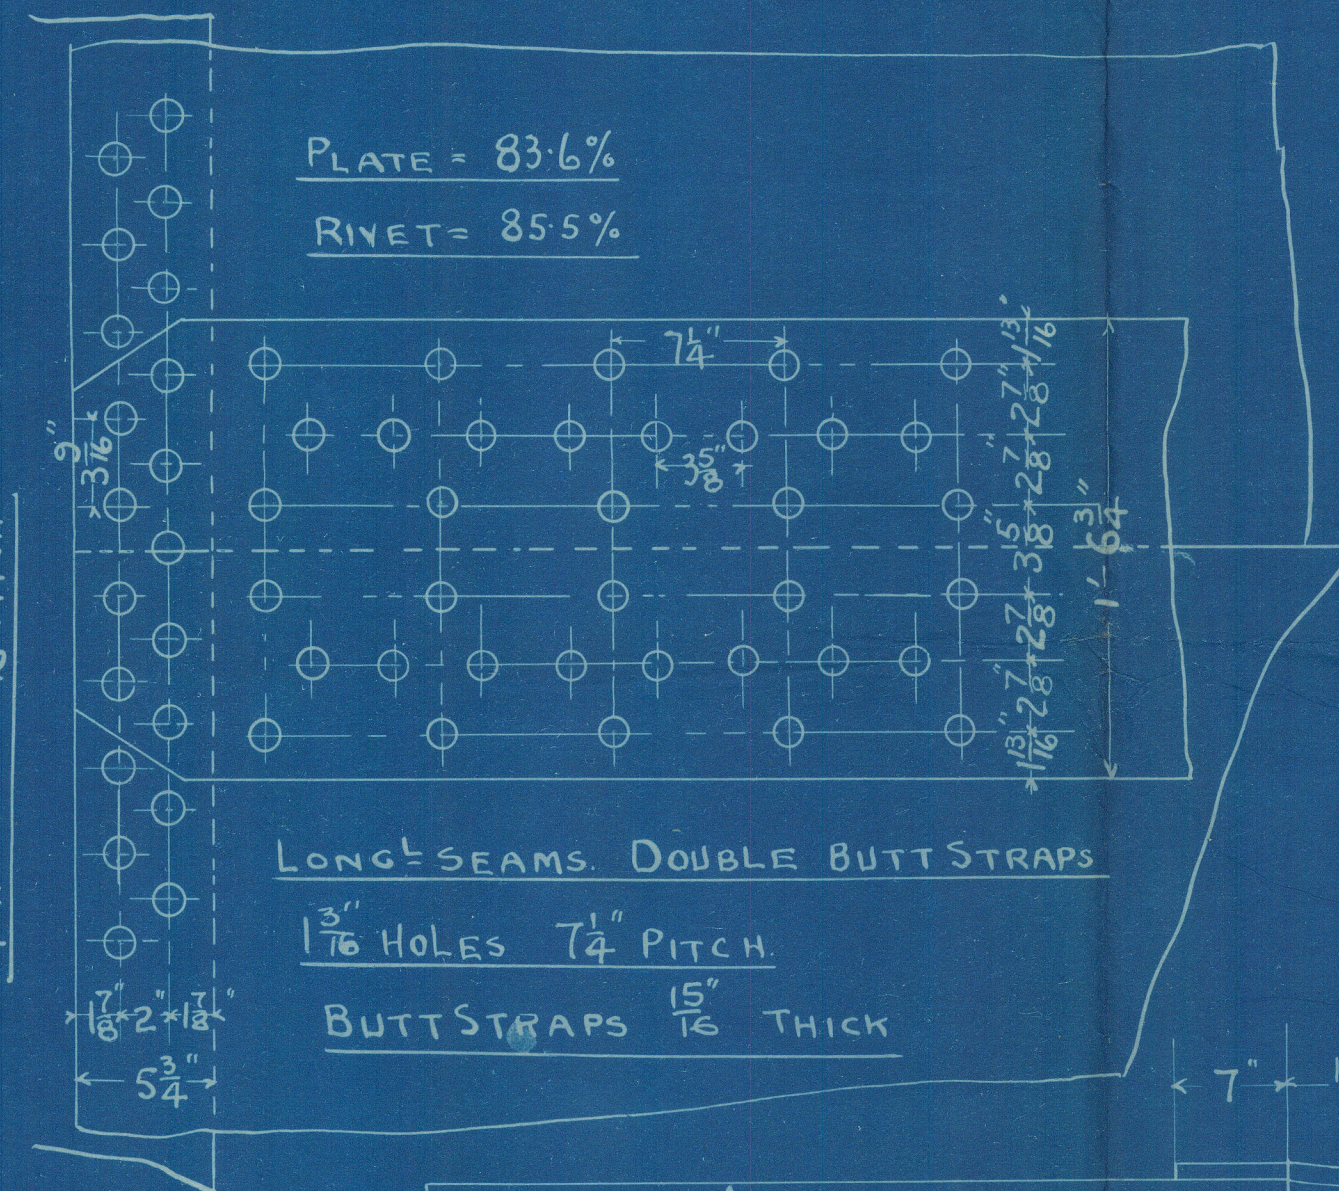

# STEEL PLATES - BARS AND RIVETS IRON TUBES AND GIRDERS

TENSILE STRENGTH OF SHELL-BUTT STRAPS  
AND MANHOLE RING 28 TO 32 TONS PER INCH.

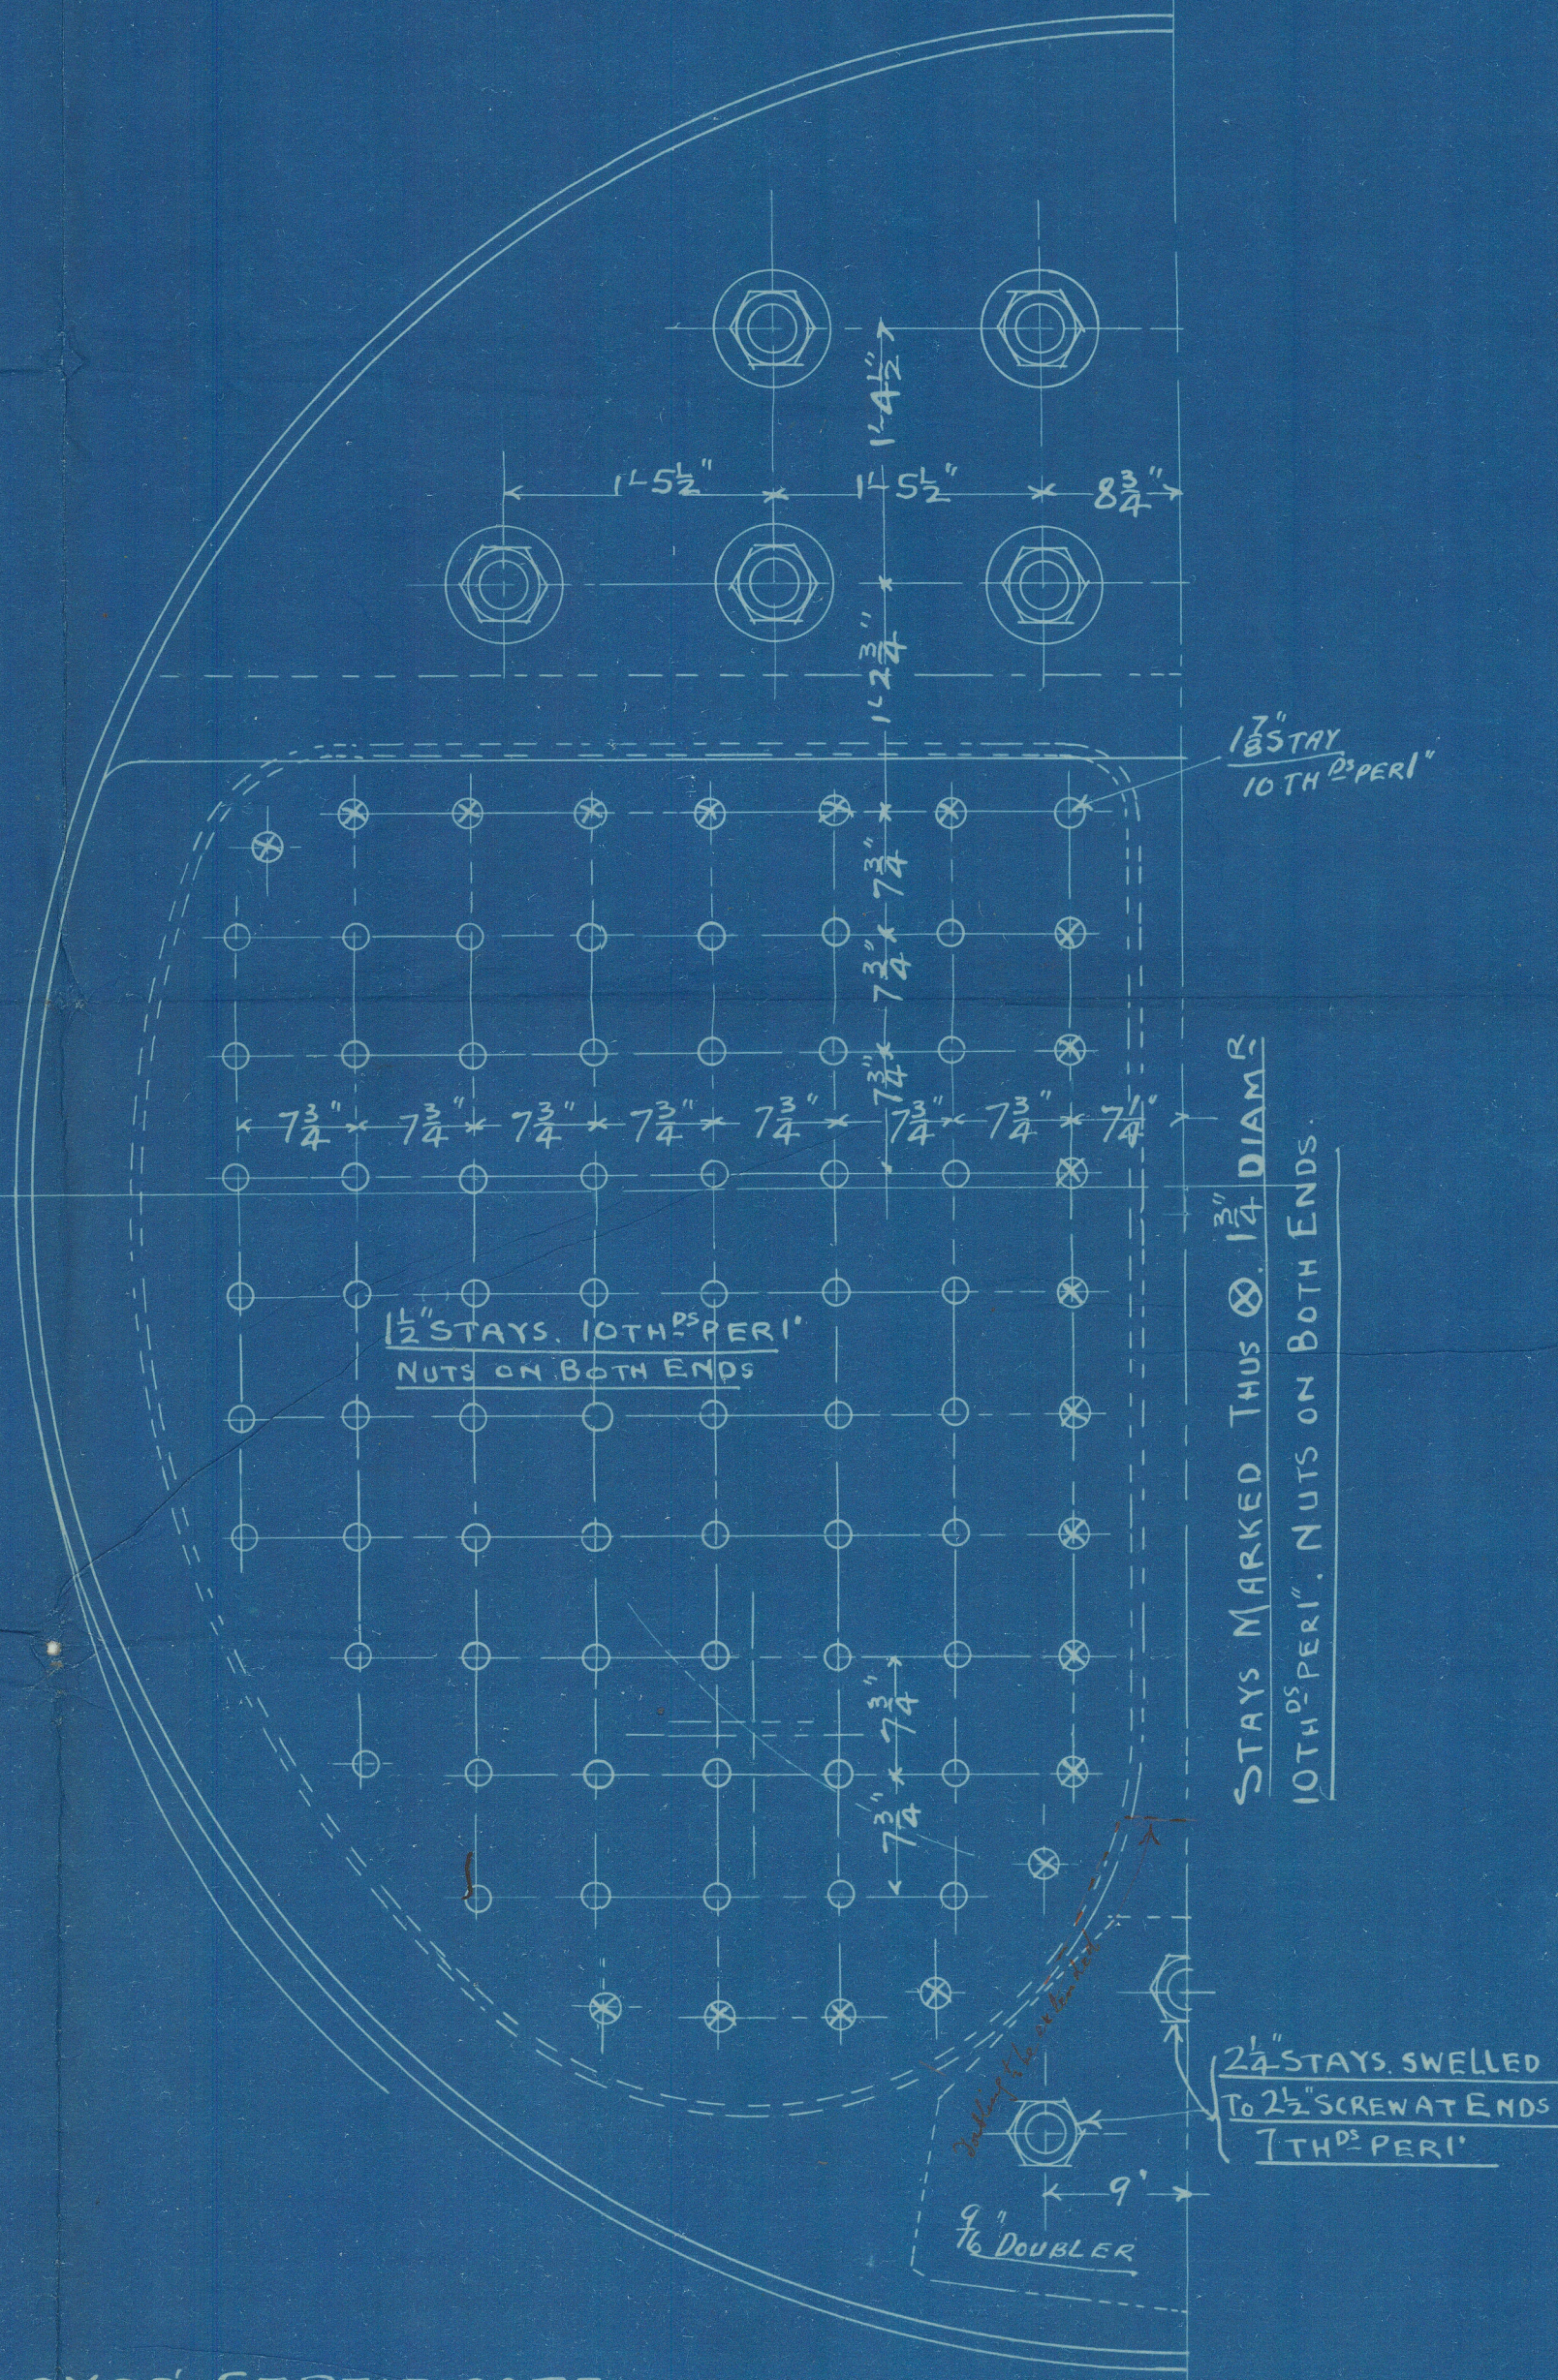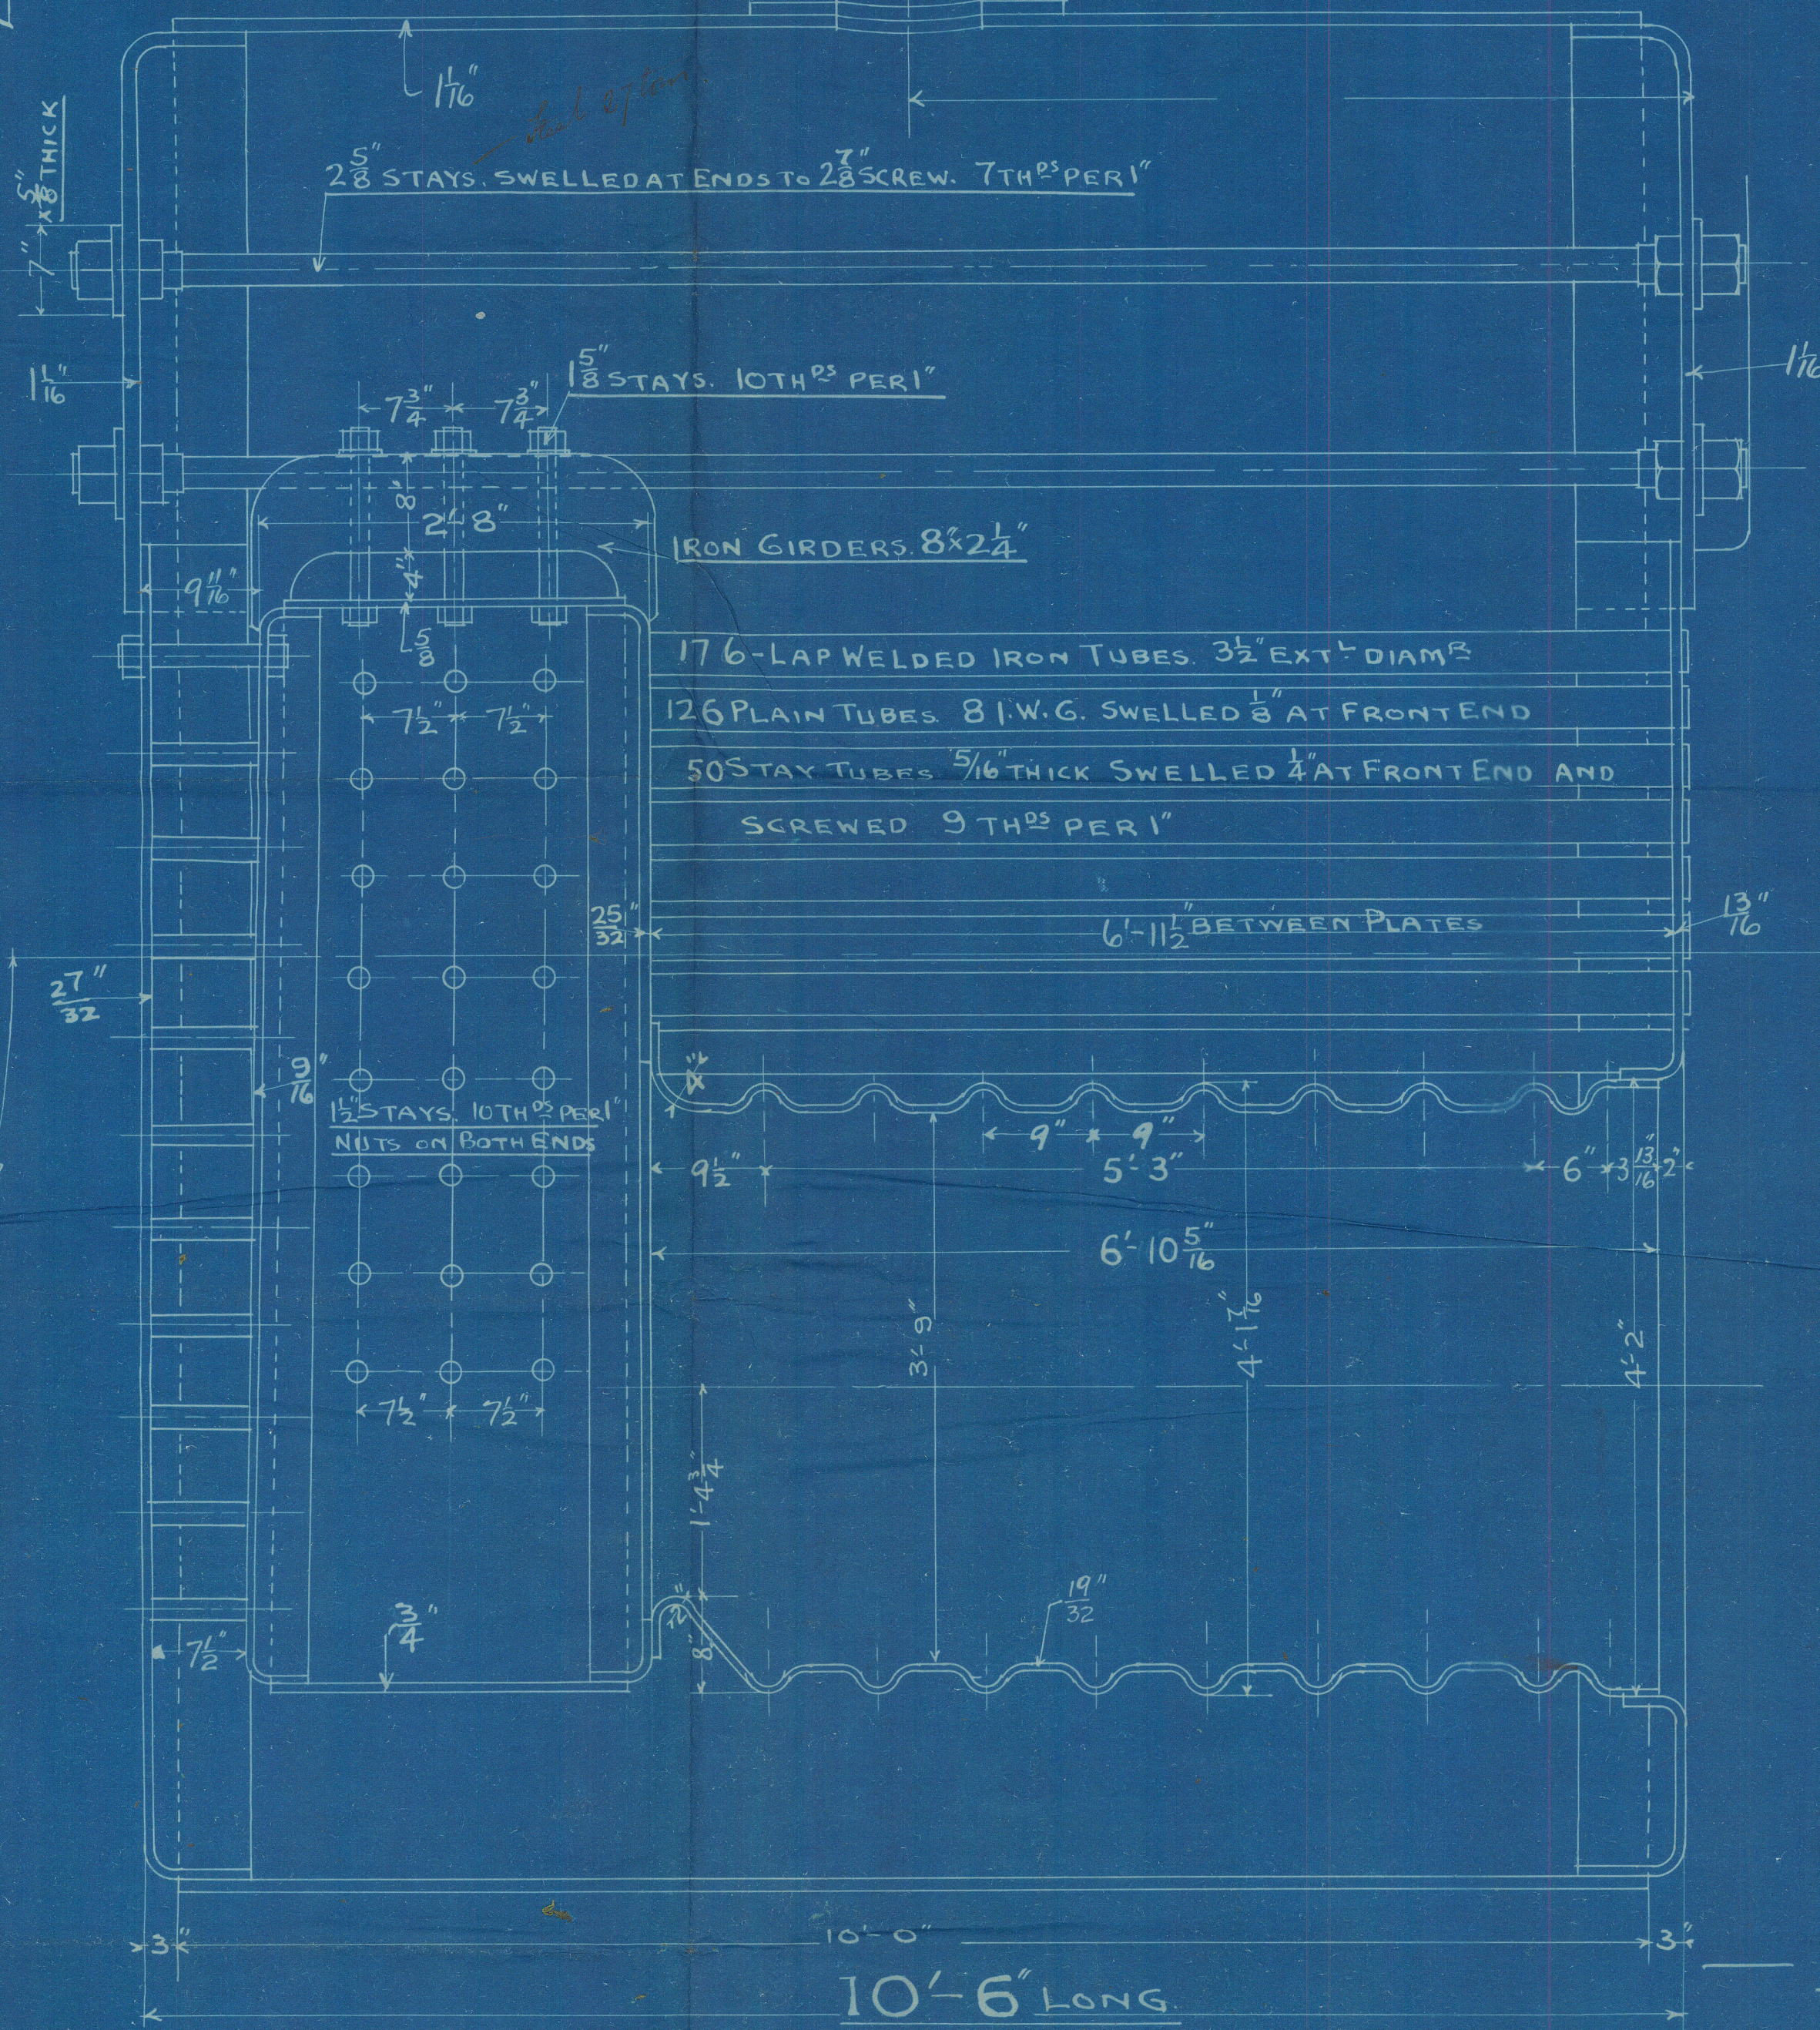

TO HAVE LLOYD'S CERTIFICATE  
BOILER NOS 1191 & 1192  
WORKING PRESSURE 180 LBS. PER INCH

SCALE INCH = 1 FOOT

|                           |            |
|---------------------------|------------|
| GRATE SURFACE (5'-6" BAR) | — 41.25 sq |
| TUBE HEATING SURFACE      | — 1121 sq  |
| OTHER "                   | — 265 sq   |
| TOTAL "                   | — 1386 sq  |

RATIO G.S. TO T.H.S. = 1:33.6





Ros & Duncan

N<sup>o</sup> 1191-2

180 lbs. W. P.

M. Remus

GLASGOW Report No. 27236

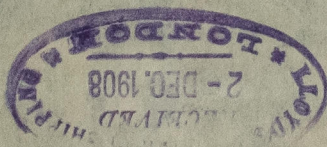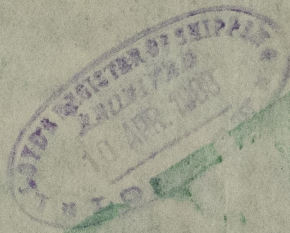

For Eng. N<sup>o</sup> 952

Amended Plan. 9/4/08.

Calcut. 53-4-08

W781 - 0016



© 2021

Lloyd's Register  
Foundation