



EXTENT OF DAMAGE M.V. VIOLETTE.

SCALES $\sim \frac{3}{8}$ & $\frac{1}{4}$ = 1 FOOT.


NOTE:- THIS PLAN SUBSTANTIALLY REPRESENTS DAMAGE TO CONCRETE STRUCTURE.

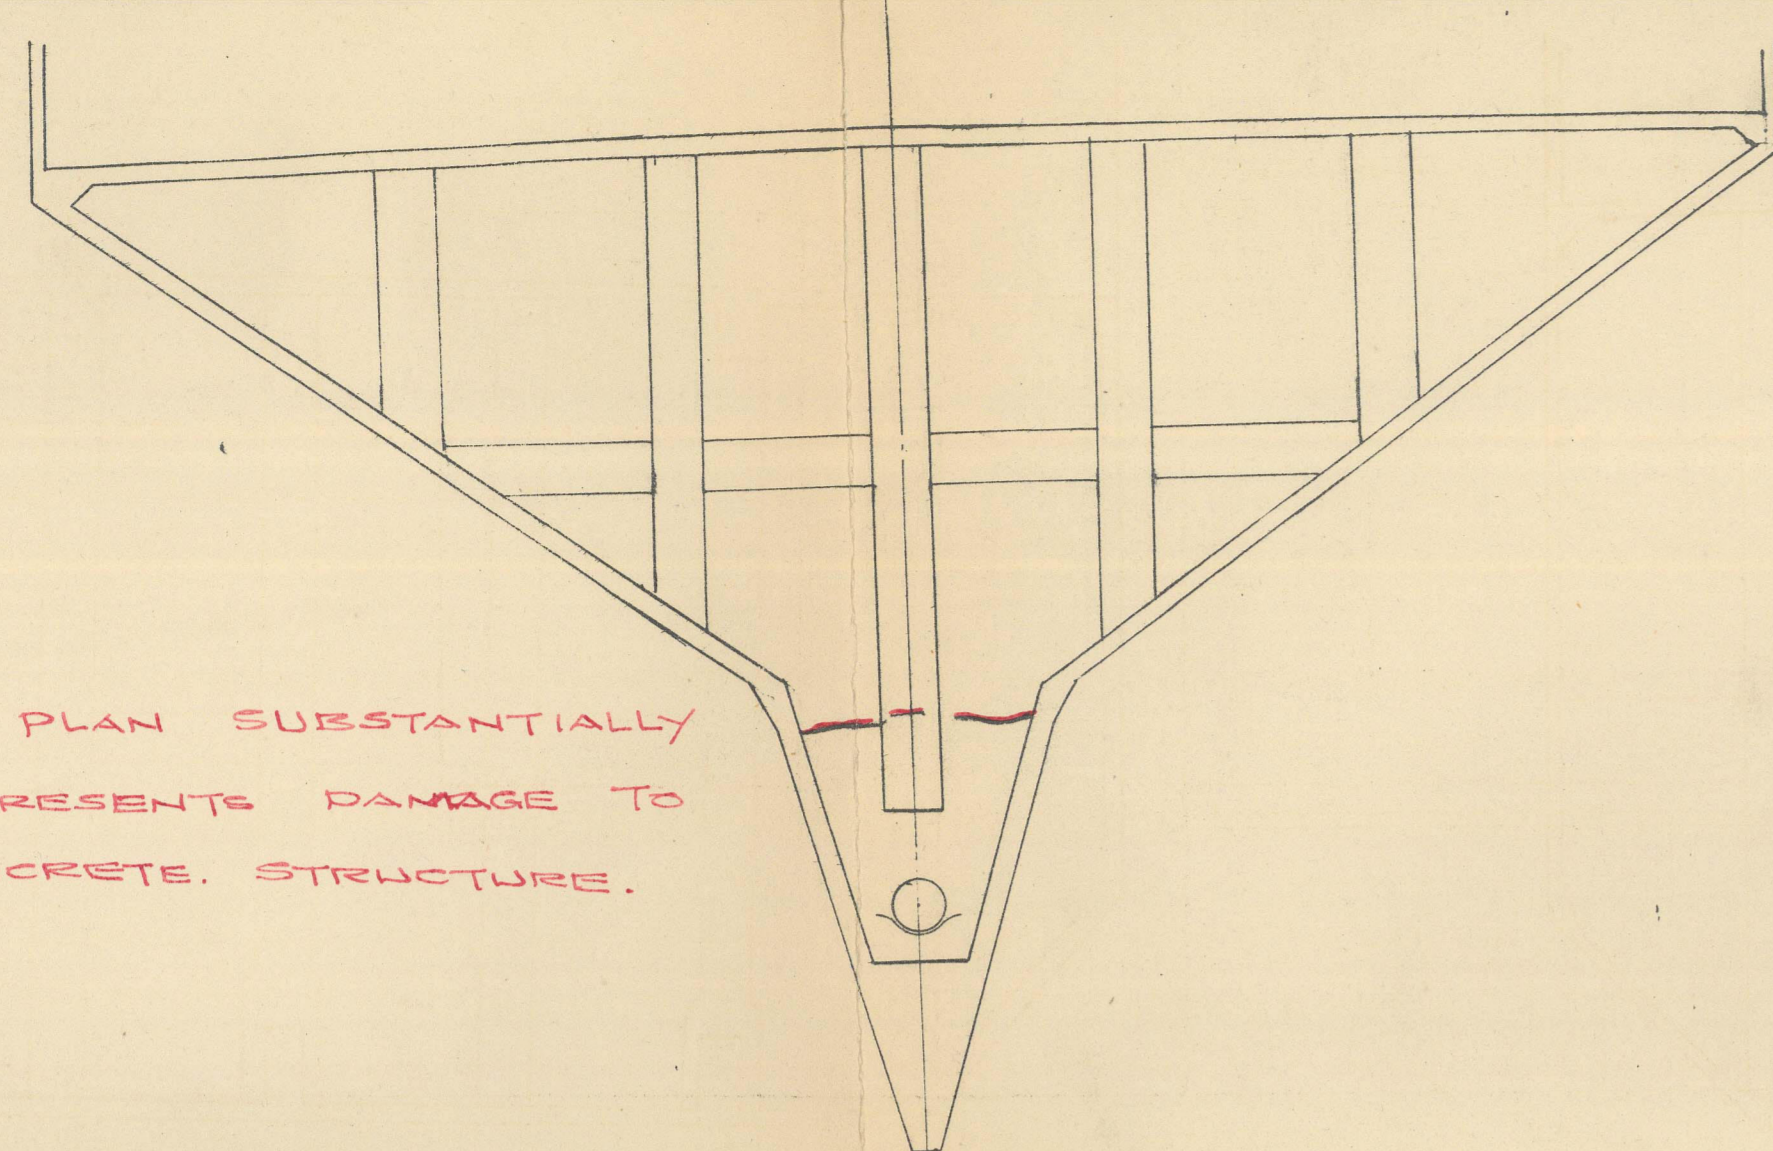


FORWD SIDE AFTER PEAK BULKHEAD.

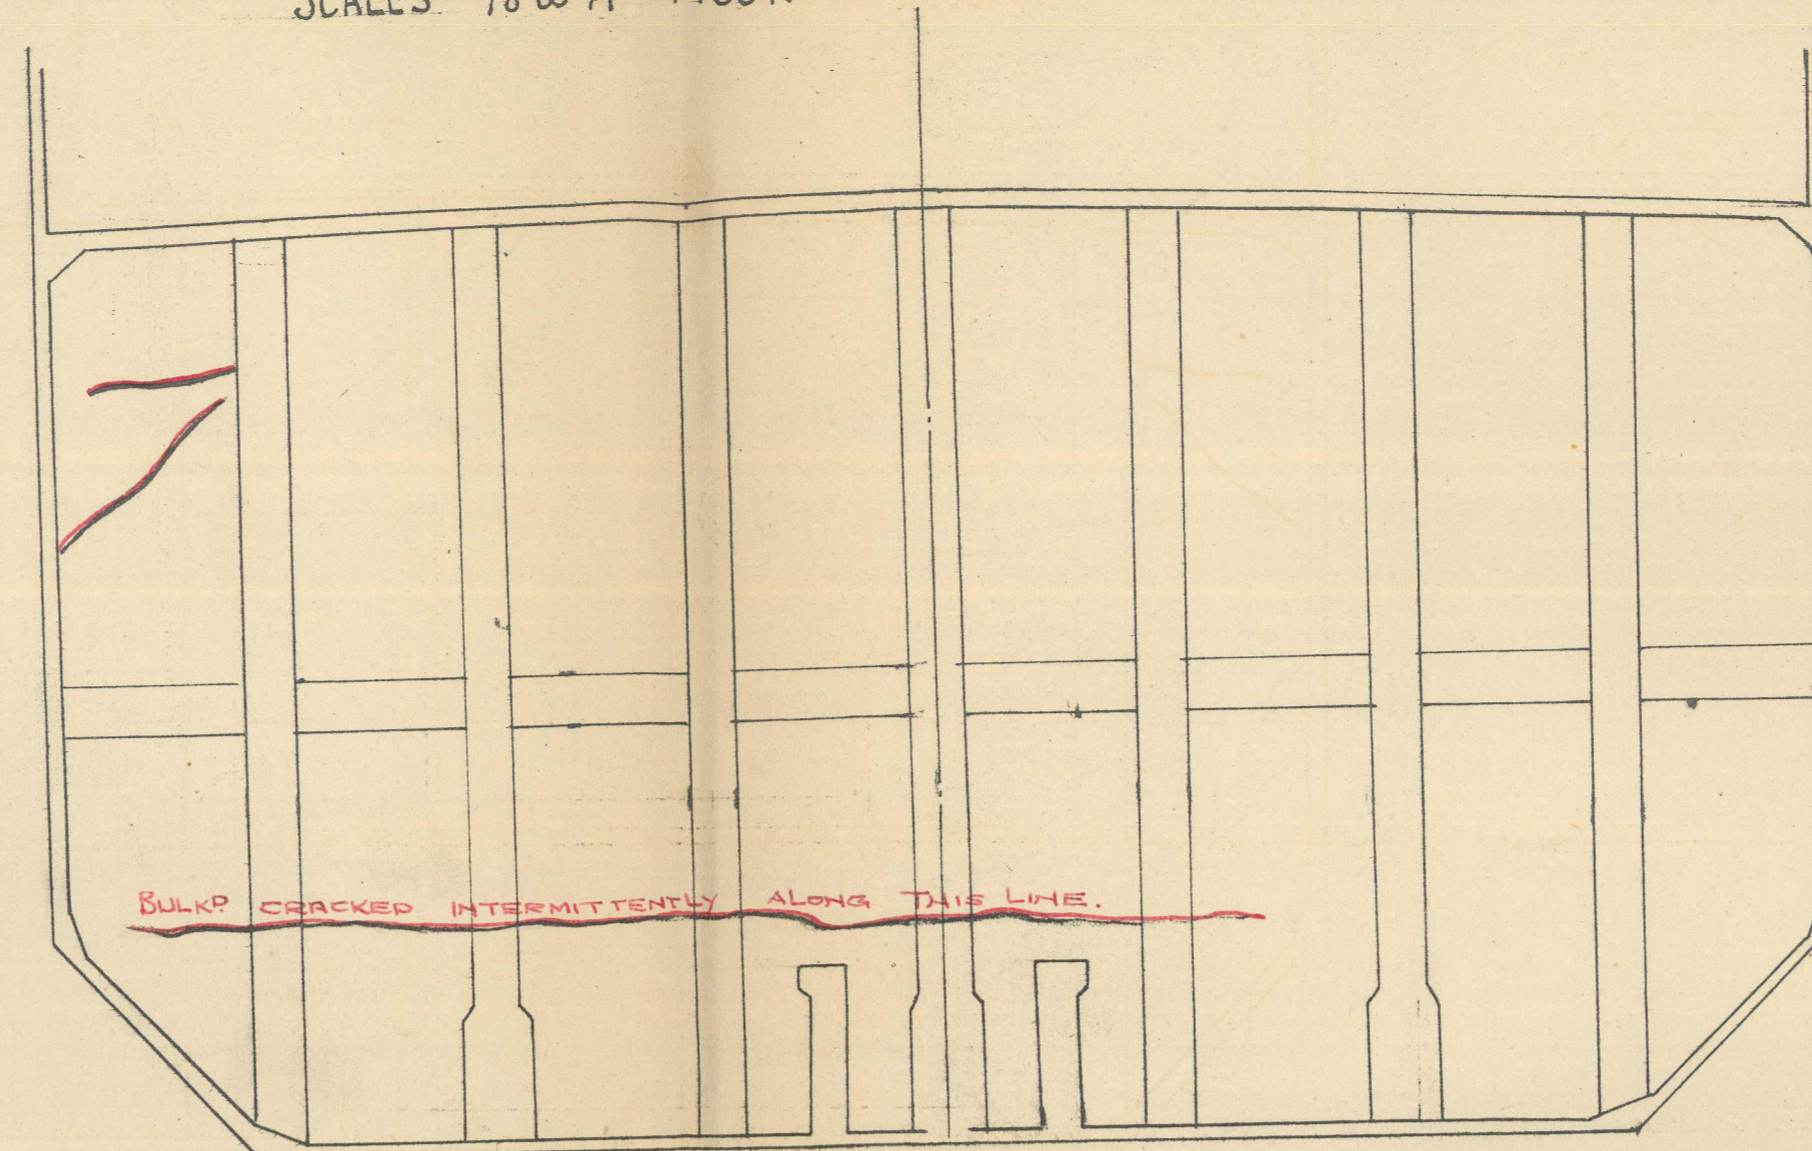


AFT HOLD BULK AFT SIDE.

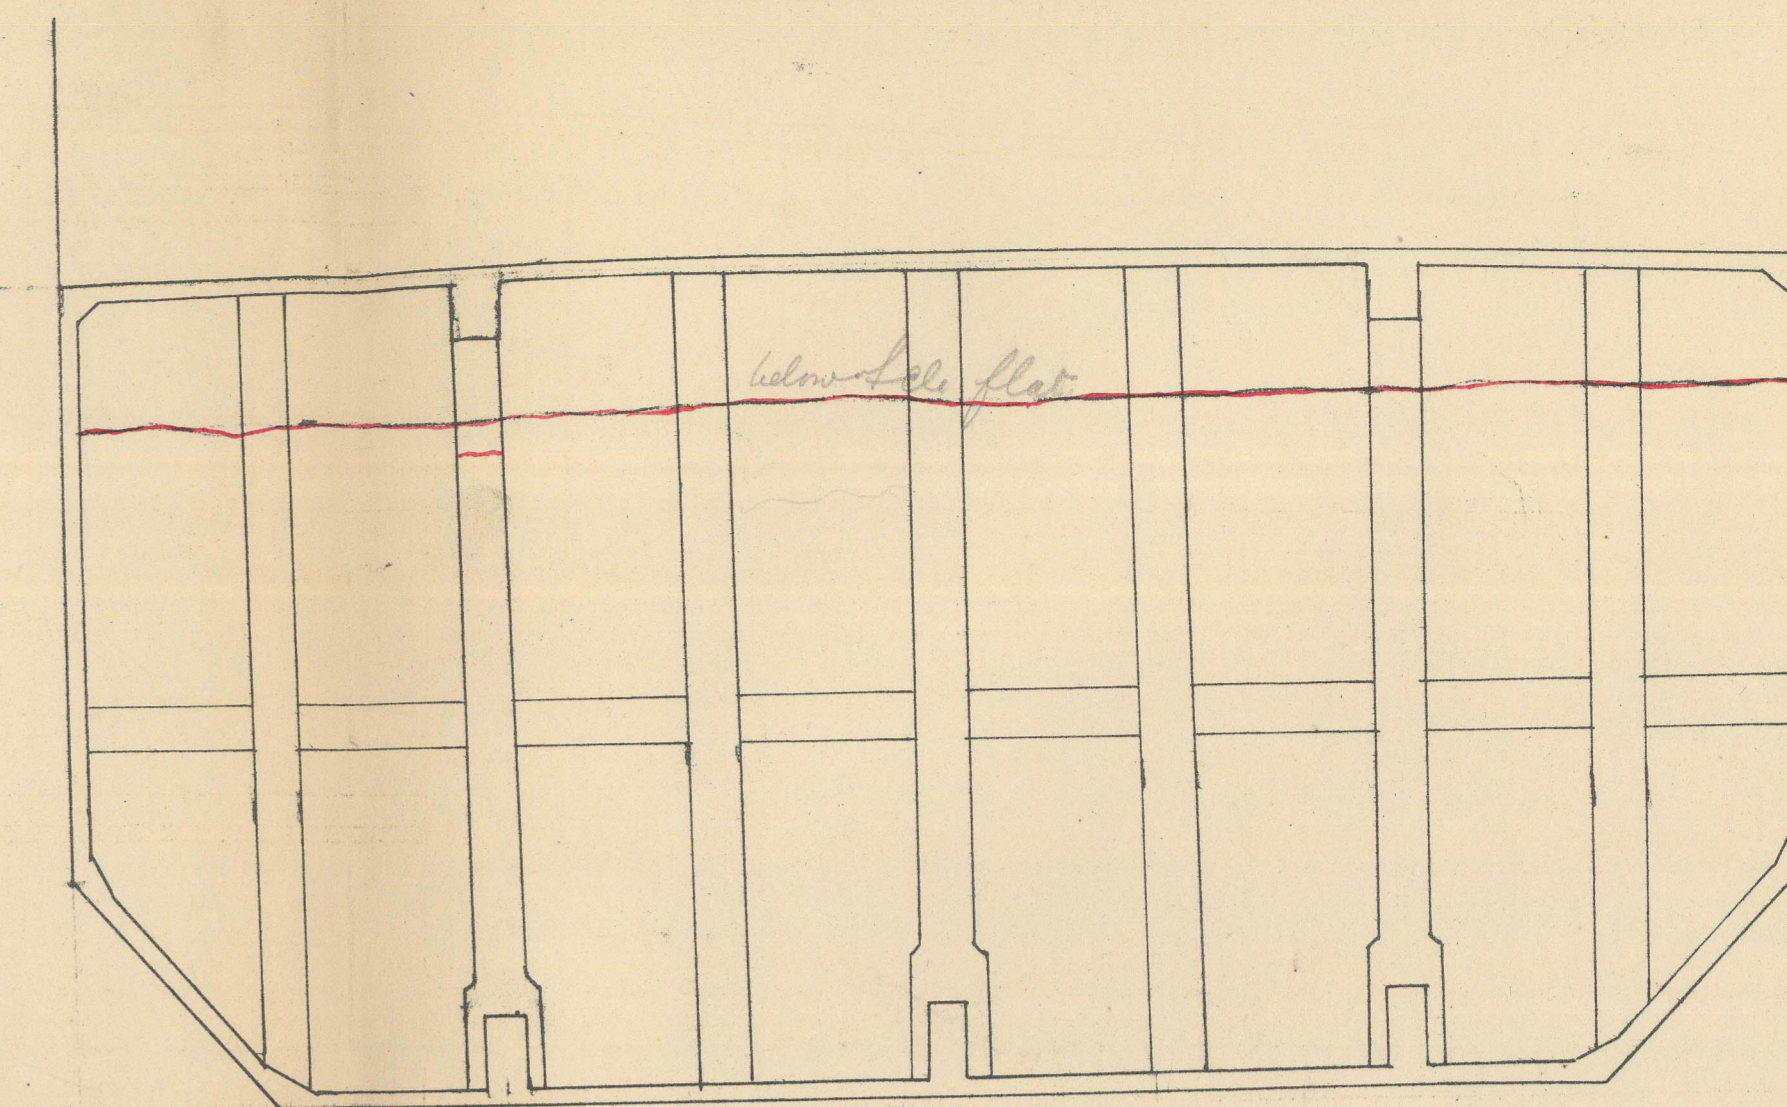

FORW HOLD BULK AFT SIDE.

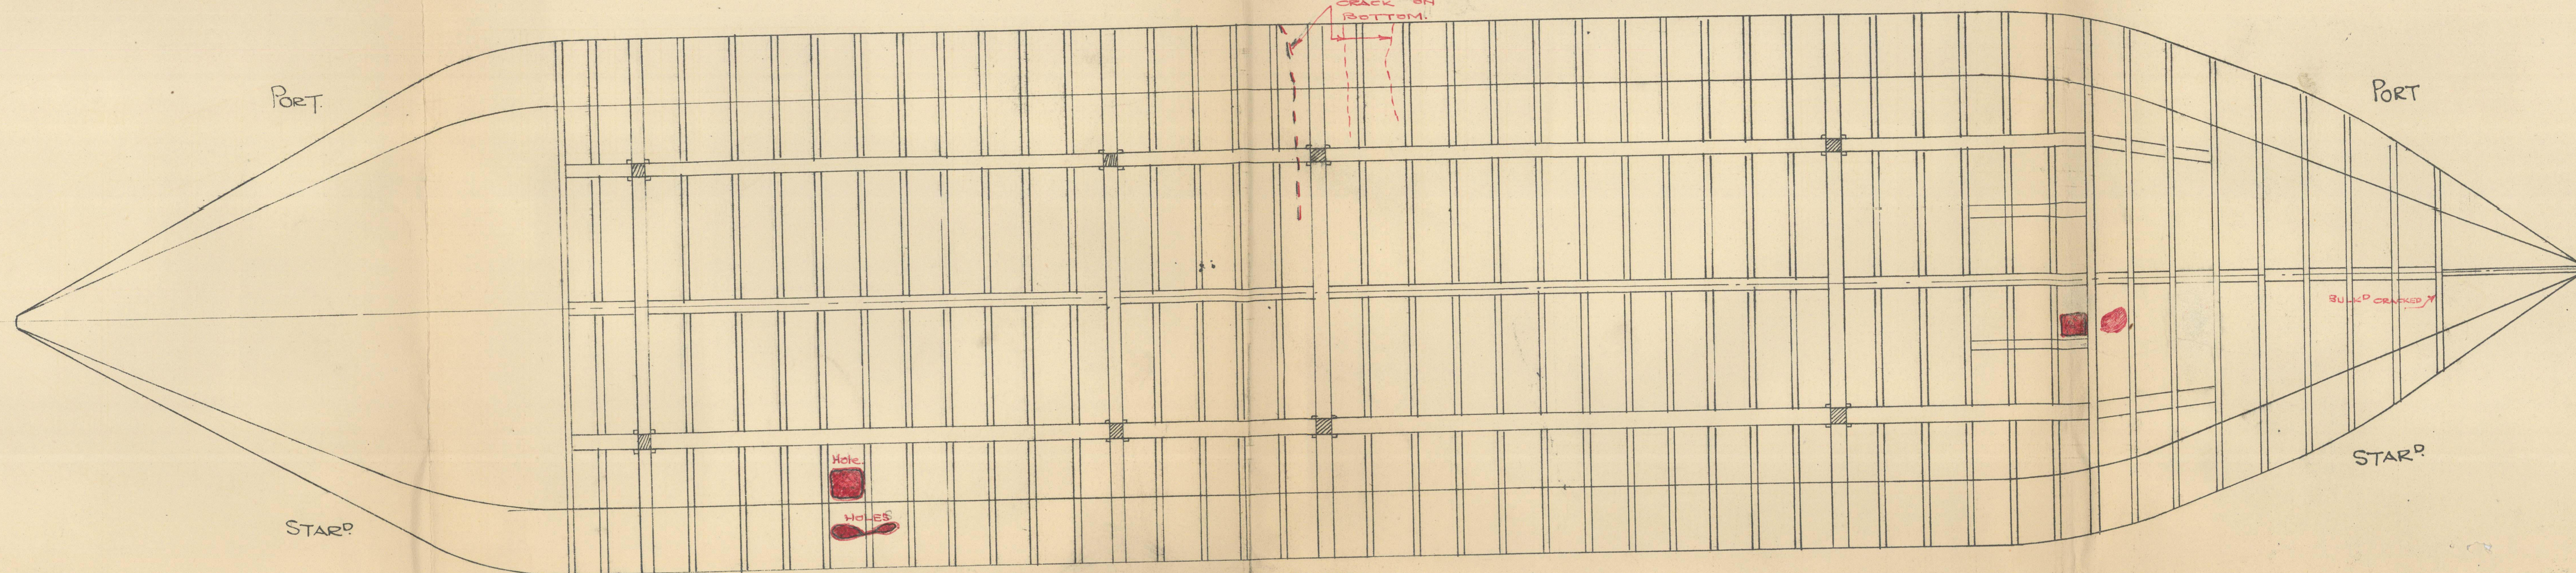


INSIDE BOTTOM

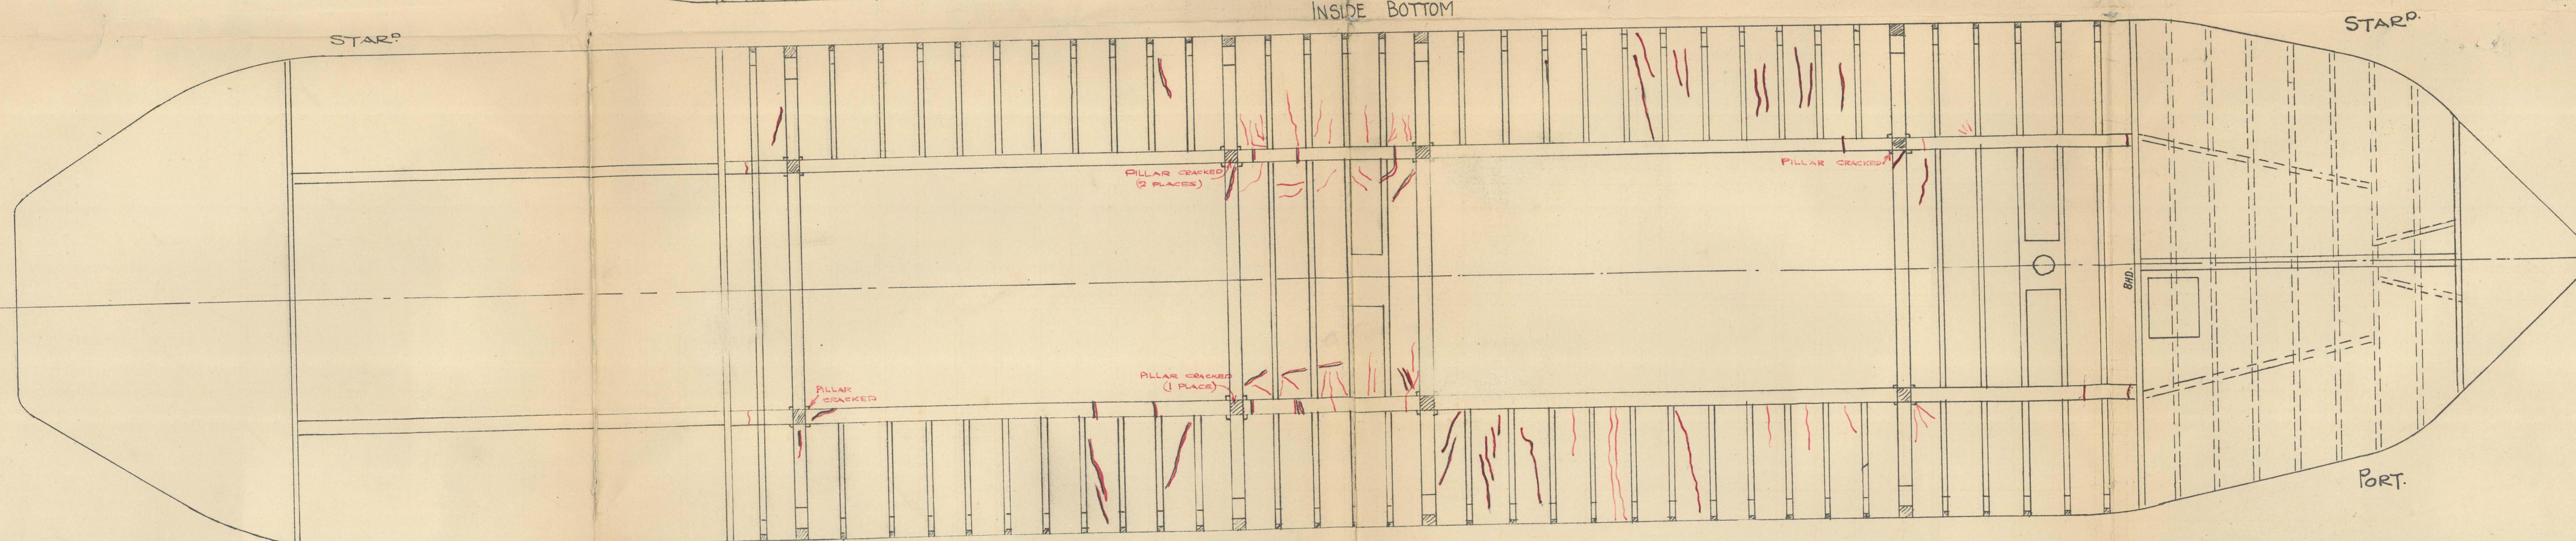

UNDERSIDE OF DECK

AT THESE POSITIONS THE DECK STRINGER (UPPER CHINE) APPARENTLY CRACKED THROUGH.

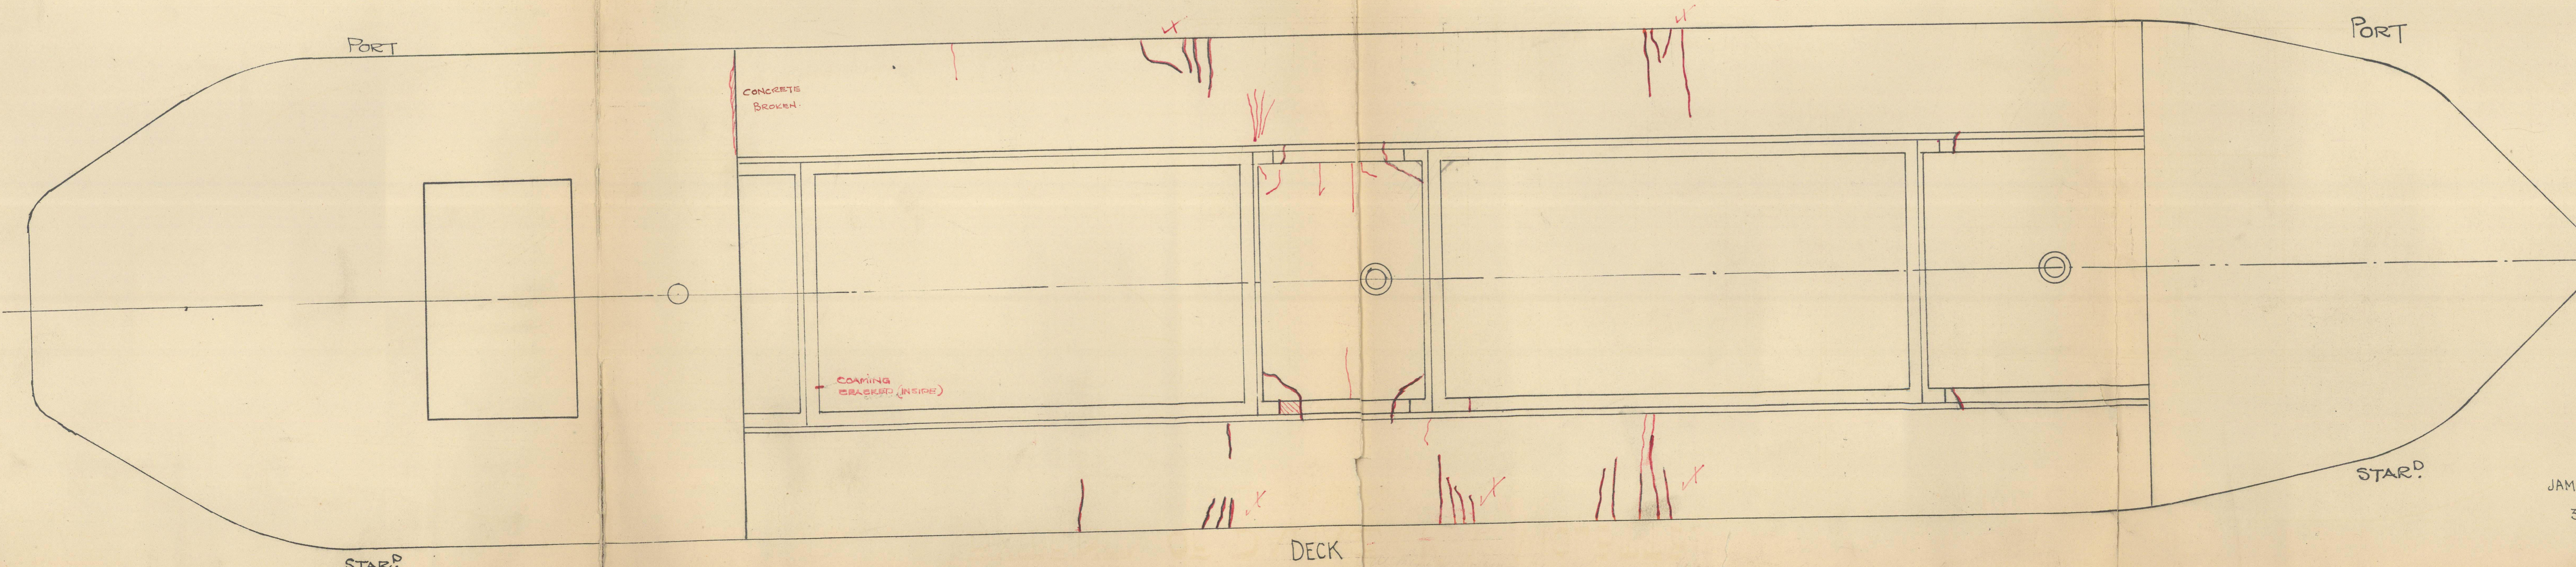

DECK

PLAN N° 10625
JAMES POLLOCK, SONS & CO. LTD.
SHIPBUILDERS & ENGINEERS
3 LLOYDS AVENUE,
LONDON, E.C.3.