



10.3.08

Nº 430

PROFILE & DECK PLAN

DIM^s 130'-0" B.P. x 23'-0" EX x 13'-0" MOULDED.

SCALE $\frac{1}{4}" = 1 \text{ FOOT}$.

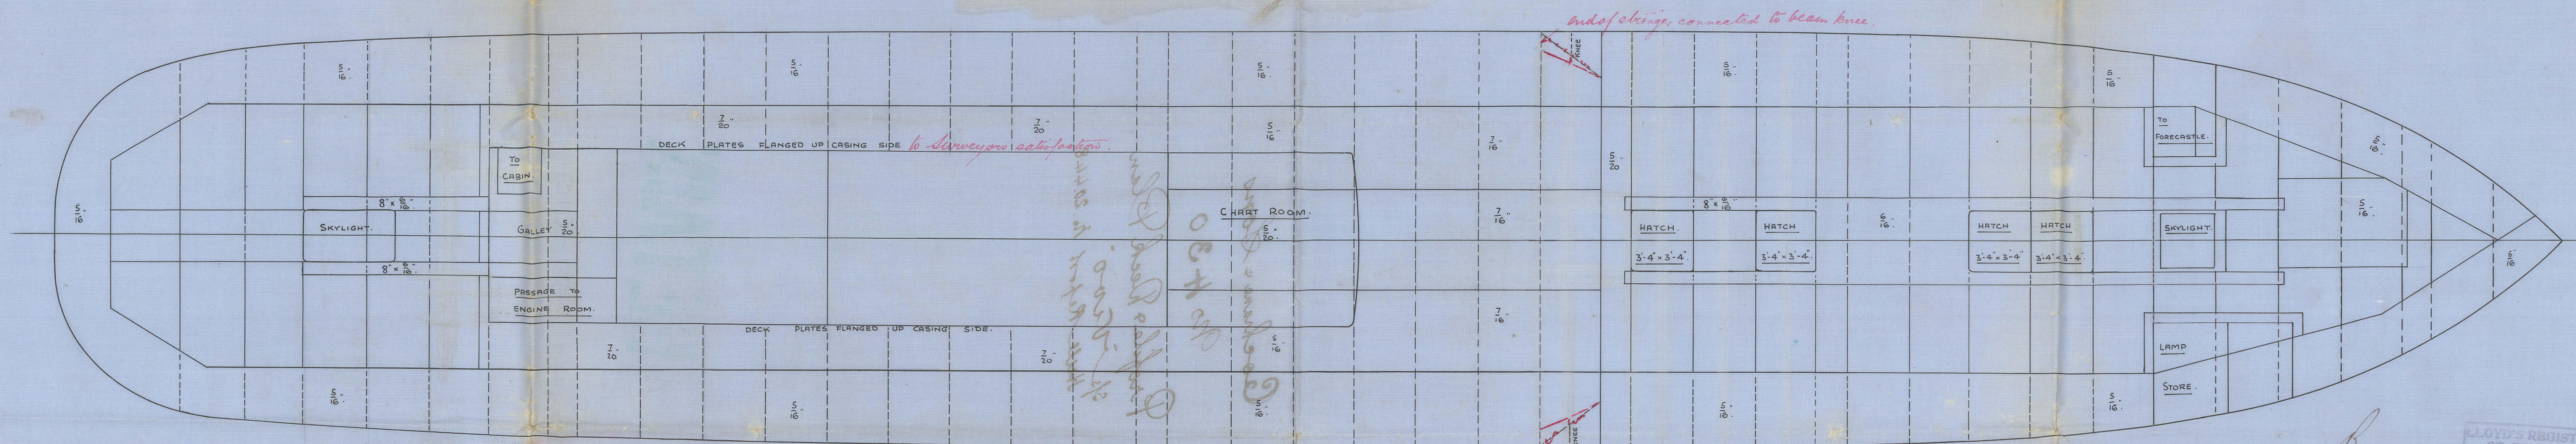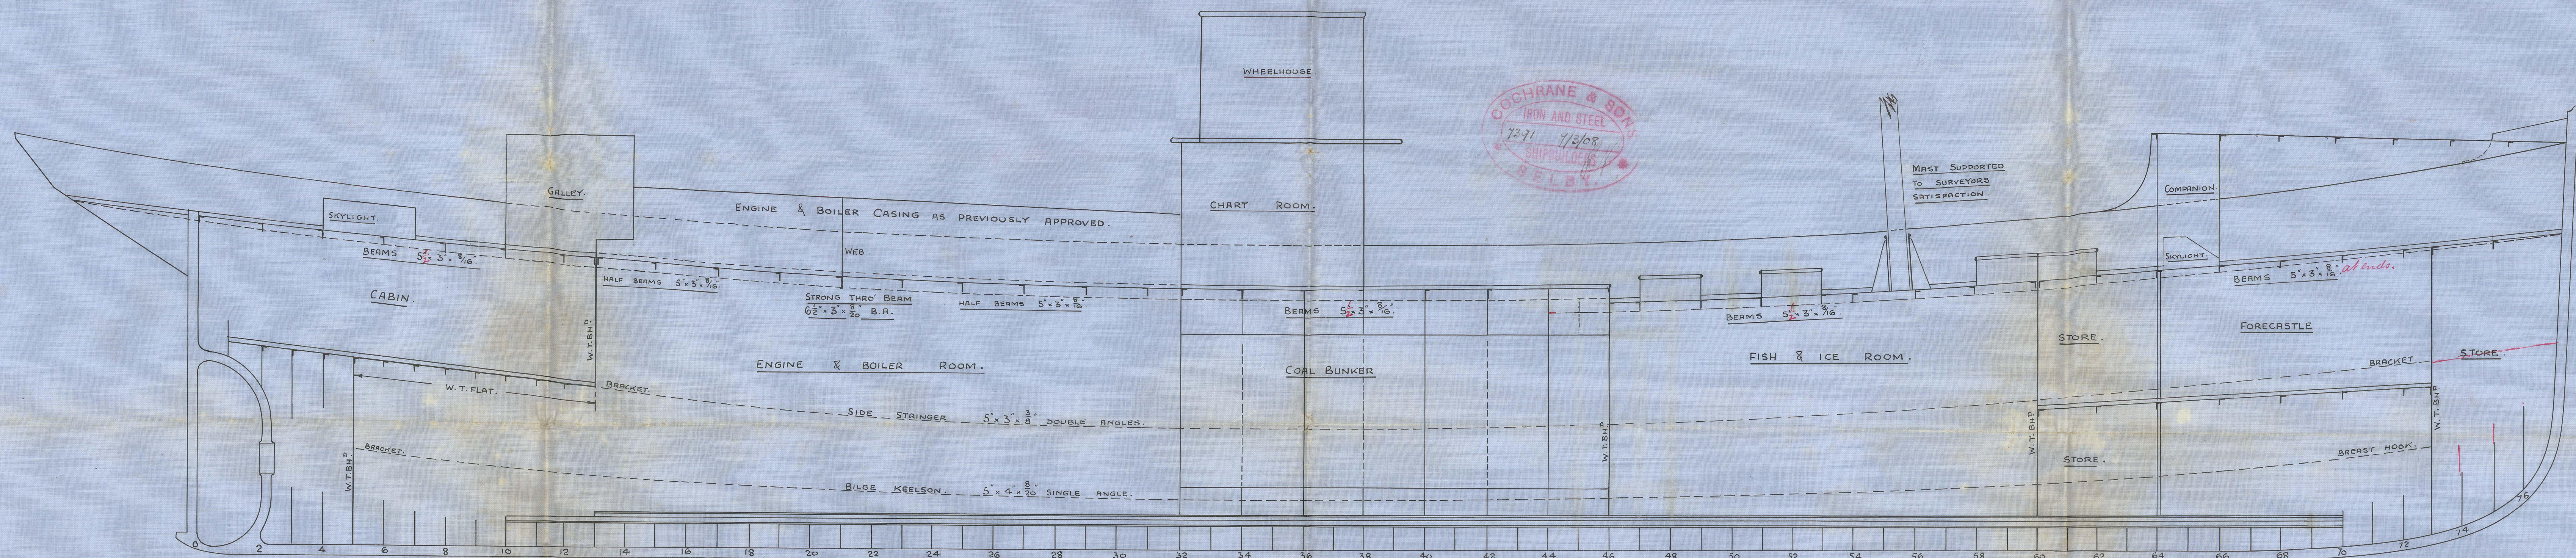

PILLARS THROUGHOUT TO SURVEYORS SATISFACTION.

C.B.
10.3.08

LLOYD'S REGISTER
OF SHIPPING
9 MAR. 1908
+ HULL +

Cochrane & Sons

No 430

Profile & Deck Plan

sp. Vivo

Hull Report No. 20.448



© 2021

Lloyd's Register
Foundation