
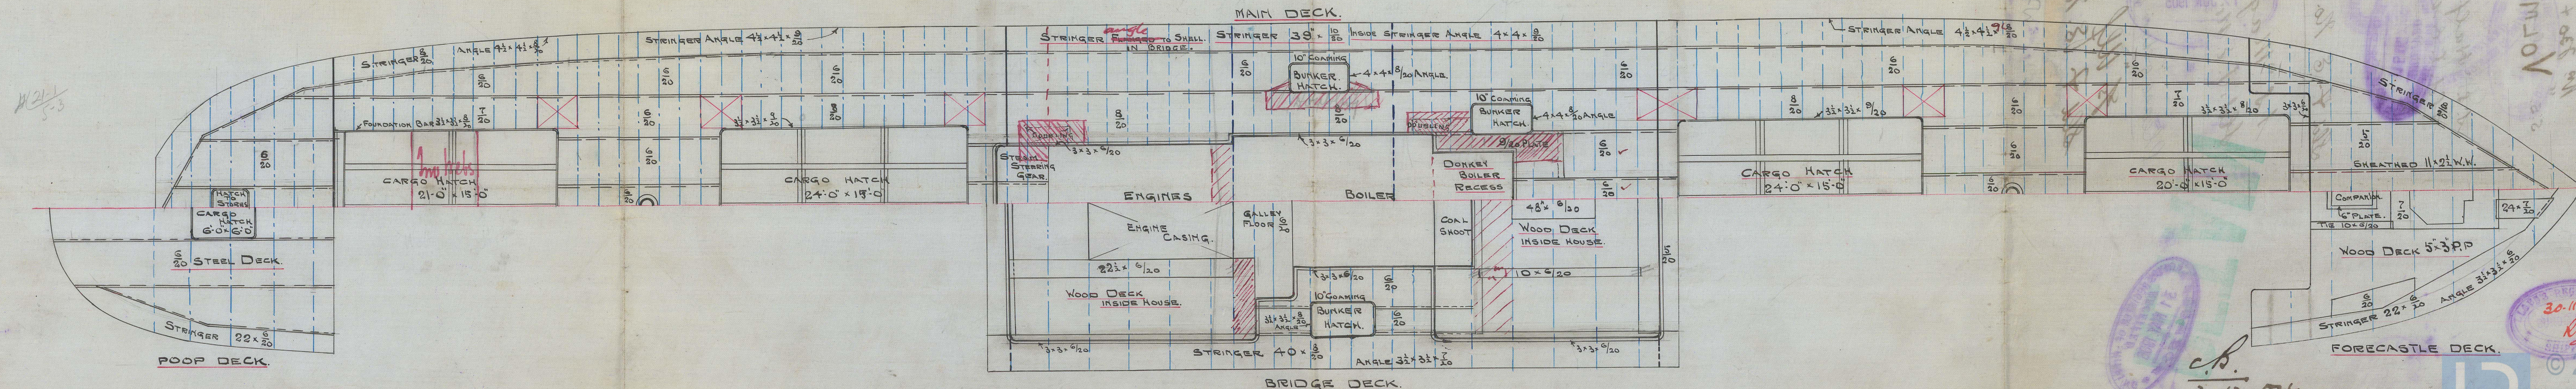


SUNDERLAND SHIPBUILDING CO. LTD.
DRAWING NO. 1137
No. 8593 26 NOV. 1904
SUNDERLAND.

-PROFILE-
S.S. No 230 & 231
SCALE 1/8" = 1 FOOT.

Alb. No 239 & 241
appd. 12/10/05

2. 12. 04
(No 239 & 241) 12. 10. 05
11. 12. 05

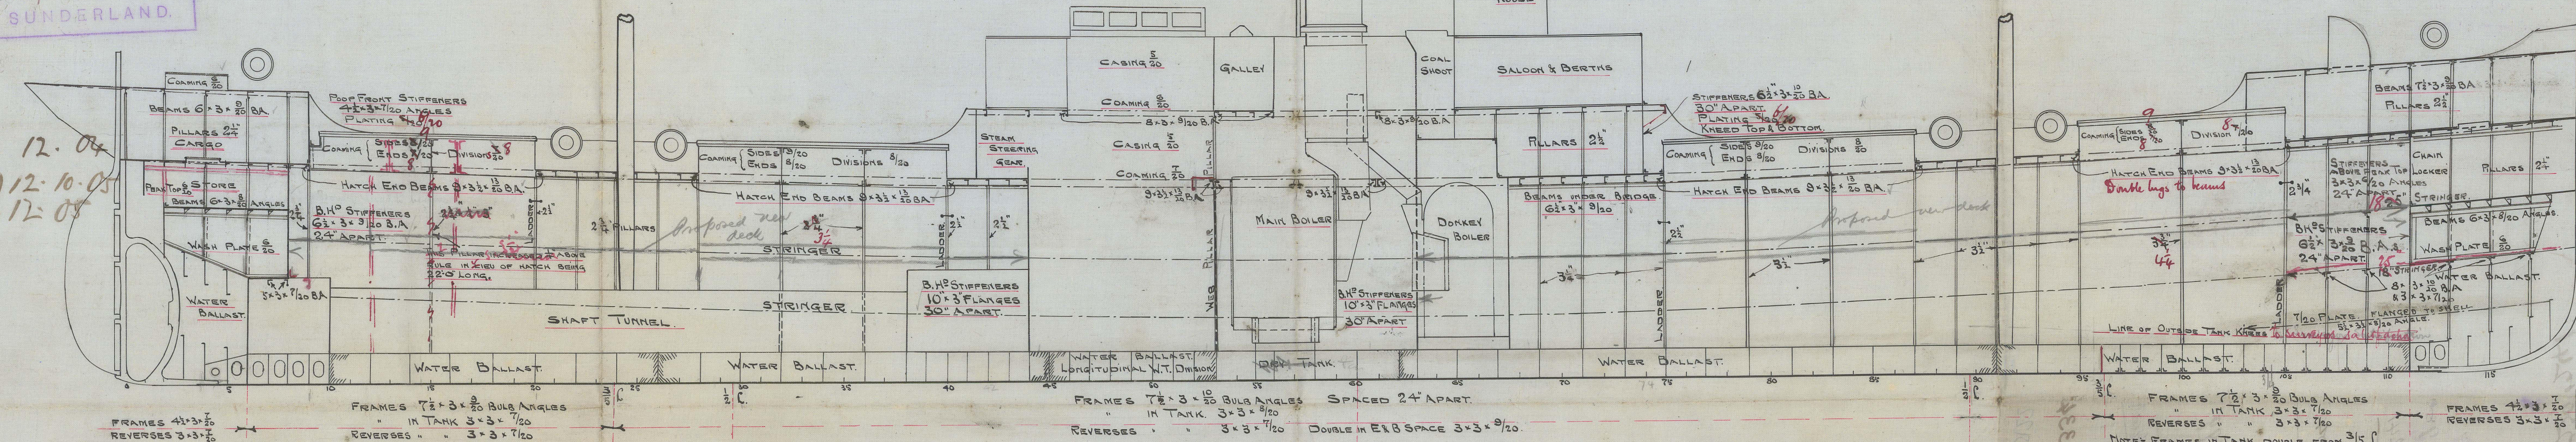

NOTES:
FRAMES IN TANK DOUBLE FROM 3/5 C TO COLLISION B.H.P. FLOORS ON EVERY FRAME.
30. 11. 04
R.H.
© 2021

Profile + deck plans
for

The Sunderland S.B. Co.

No 230 + 231 + 239

S.S. "VOLMER"

S. S. "Halfdan"

Sld. F. & No. 2298

No. 241

Sld. F. & No. 22304

S.S. "Magnus"
Sld. F. & No. 22799

Please return to duplicate

J. S. "Ulf"
Sld. F. & No. 22334

W781 - 022