




19.10.04  
21:3:05

# Screwsteamer L. 122' Br. 21,6' D. 12,5'


Scale 1:50

**M. vander Ruijl**  
Fabrick van  
SCHEEPSBOUW, CASHOUDERS & CONSTRUCTIES  
Slikkerveer bij Rotterdam.

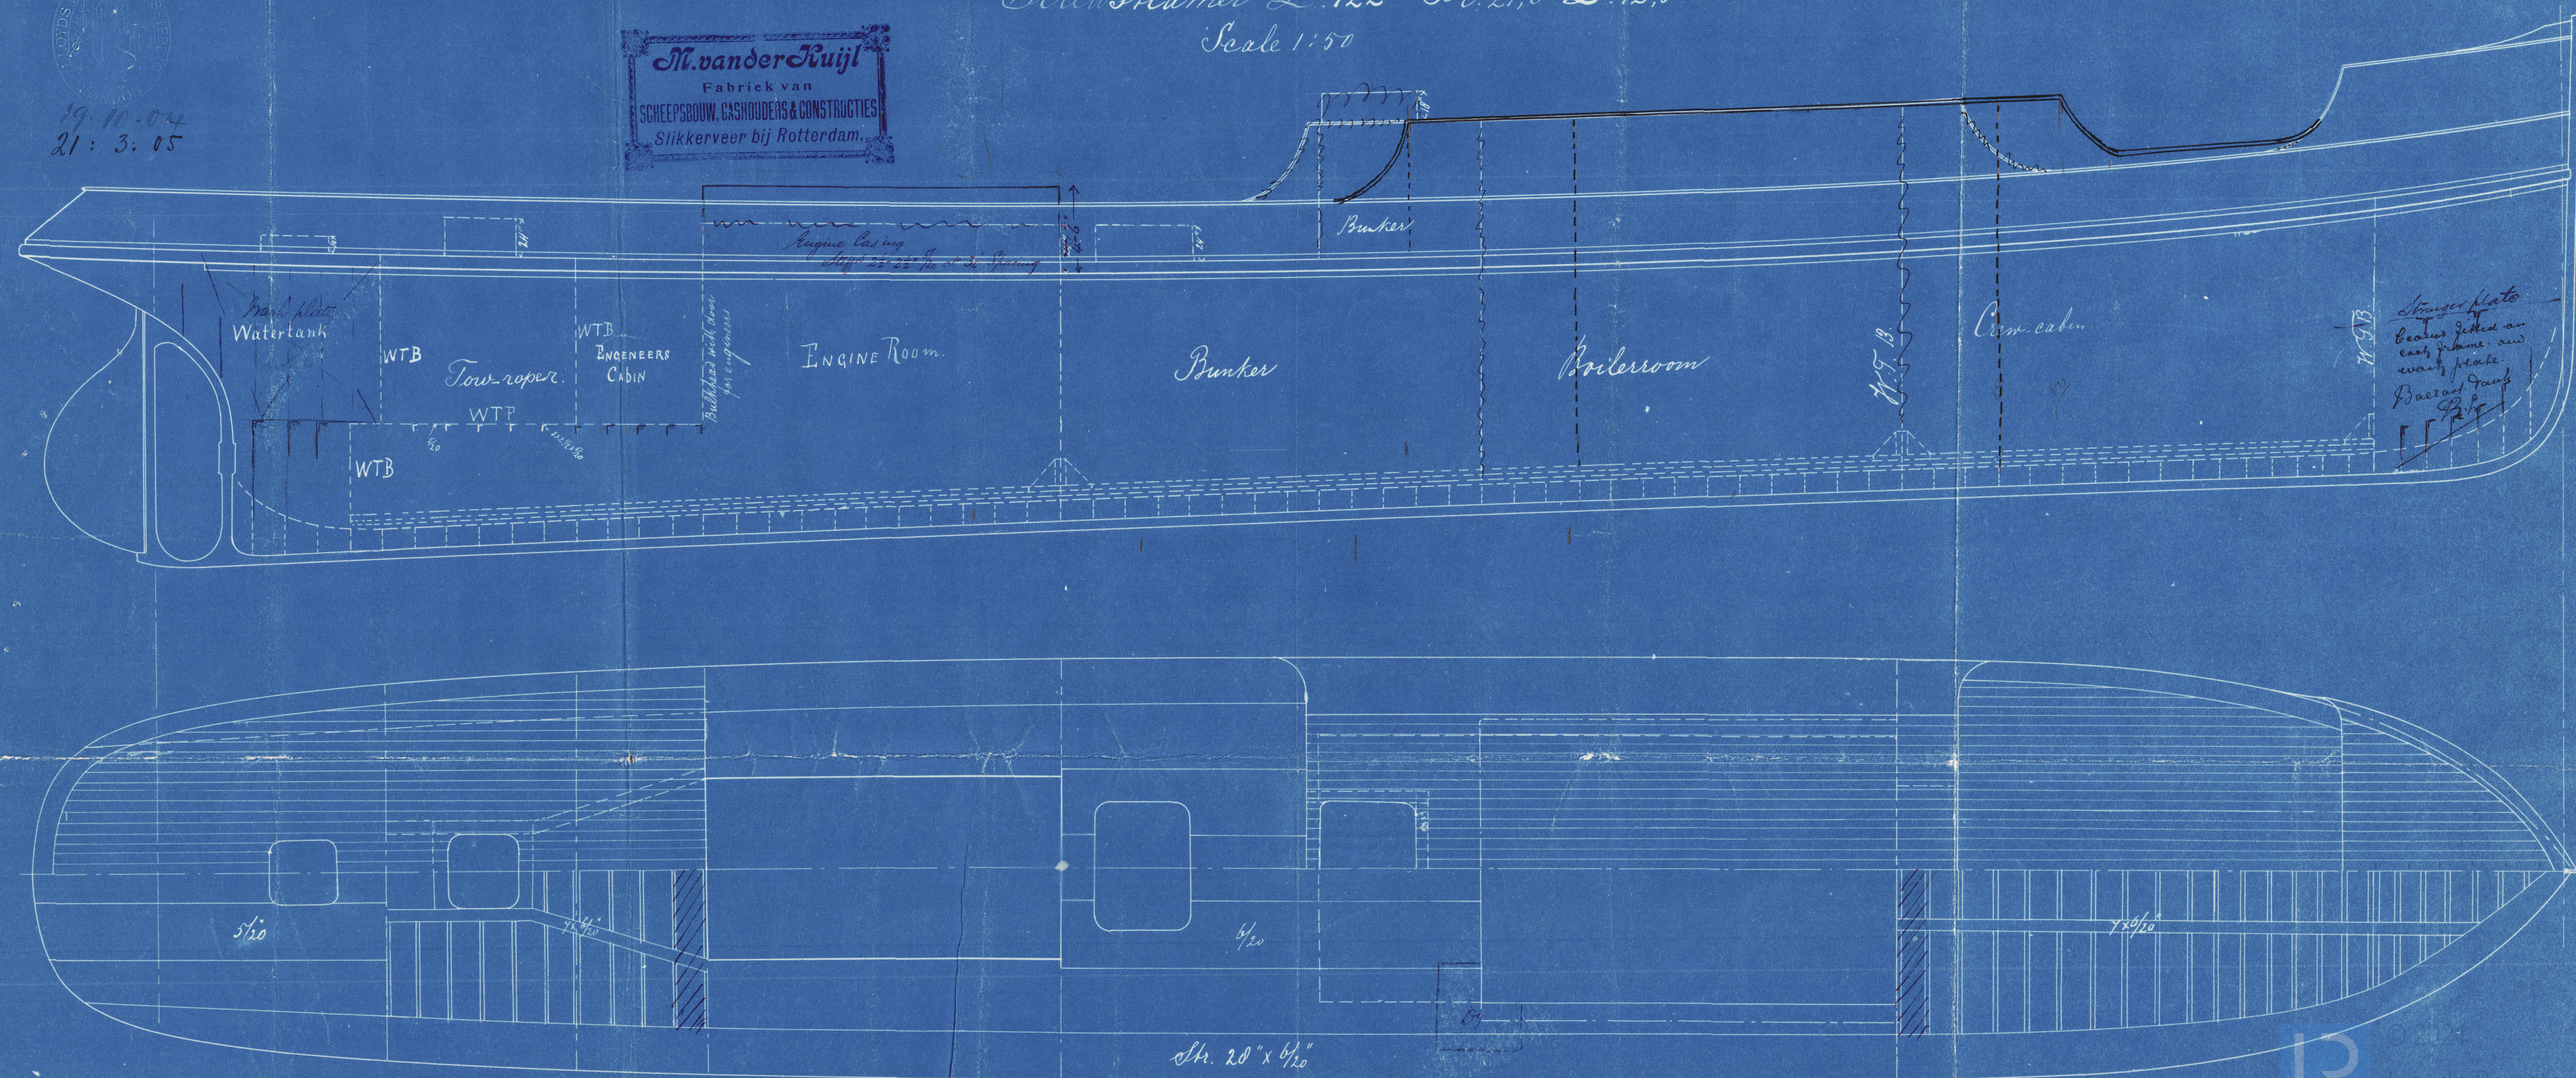



Steel. Tug. "maas"  
Part. of Rotterdam  
Report no 4340

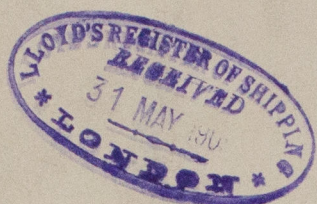

© 2021

Lloyd's Register  
Foundation

W782-0025