
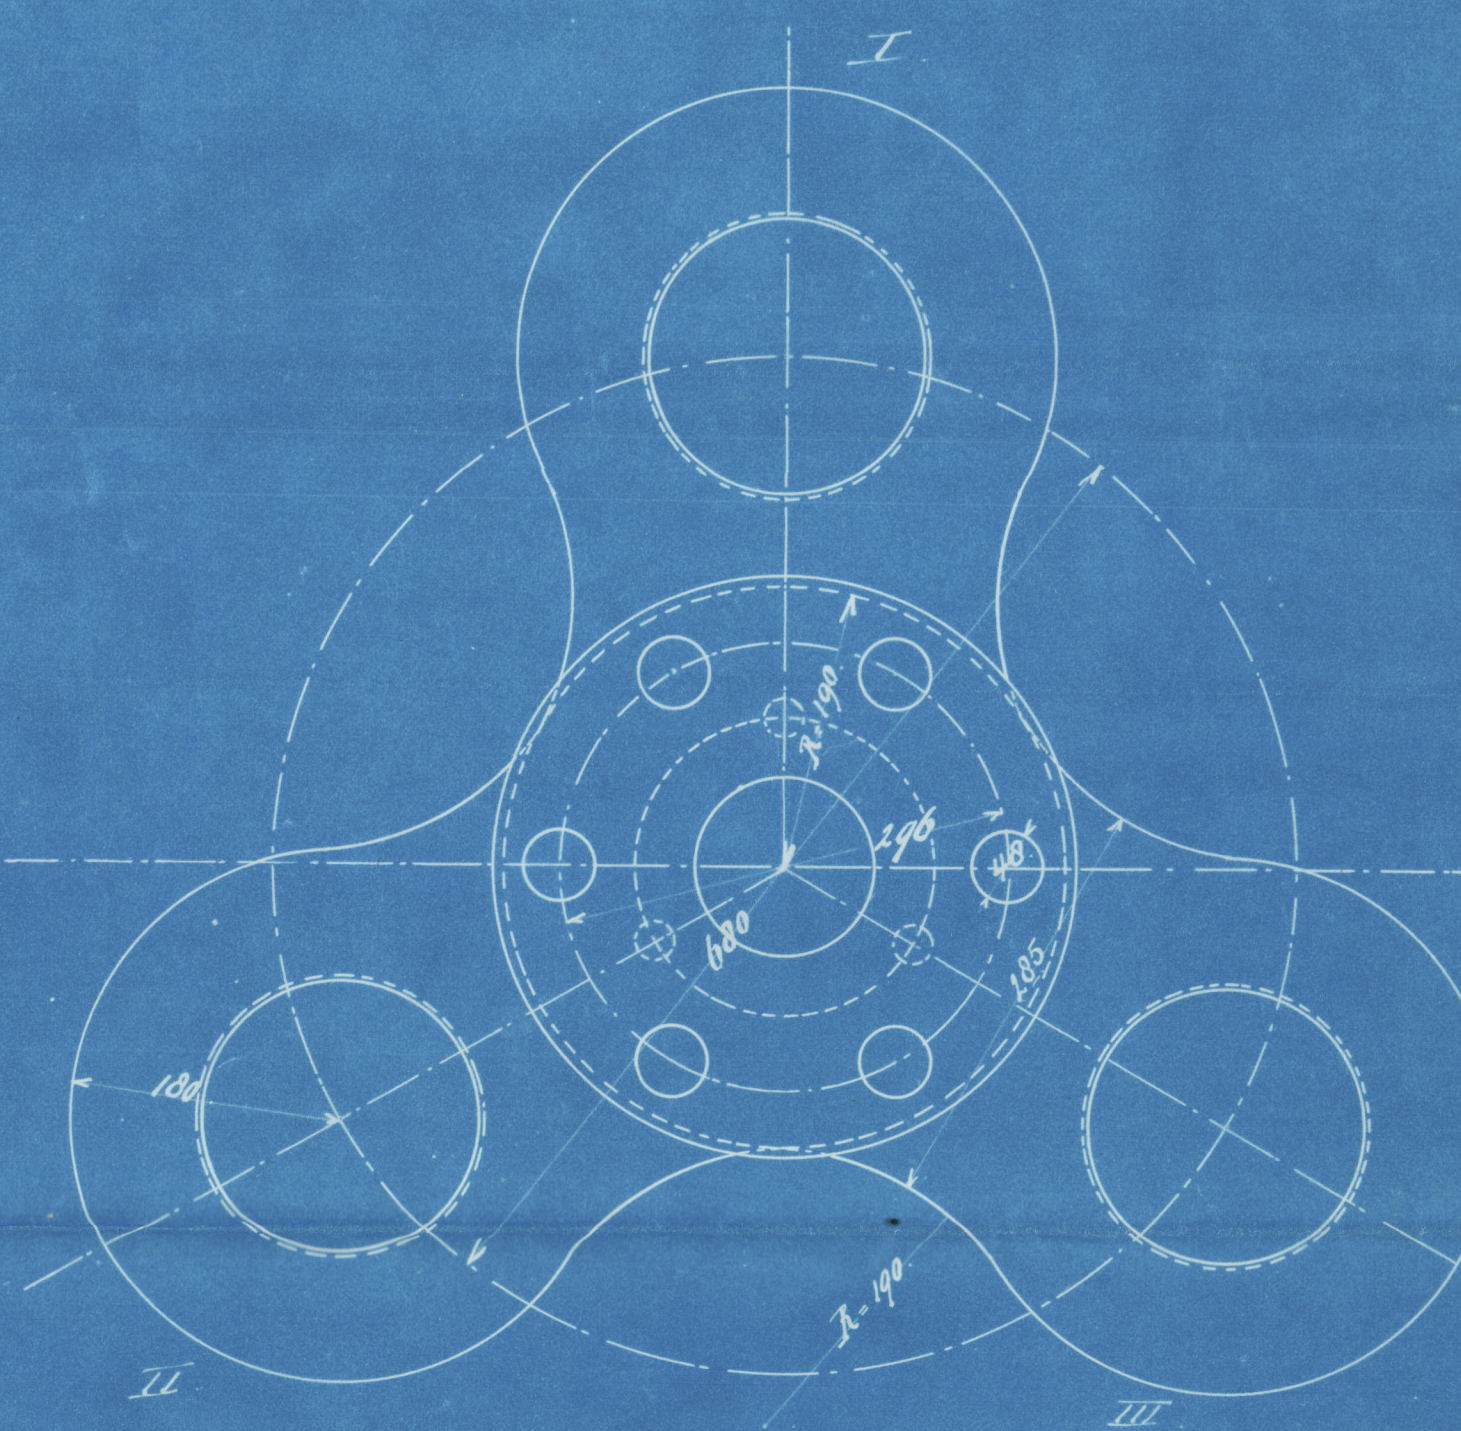


28.10.04

Collaras Xunkas Order No 45.

M.S. staal. Certificaat „Lloyd.”

Schaal 1a5.

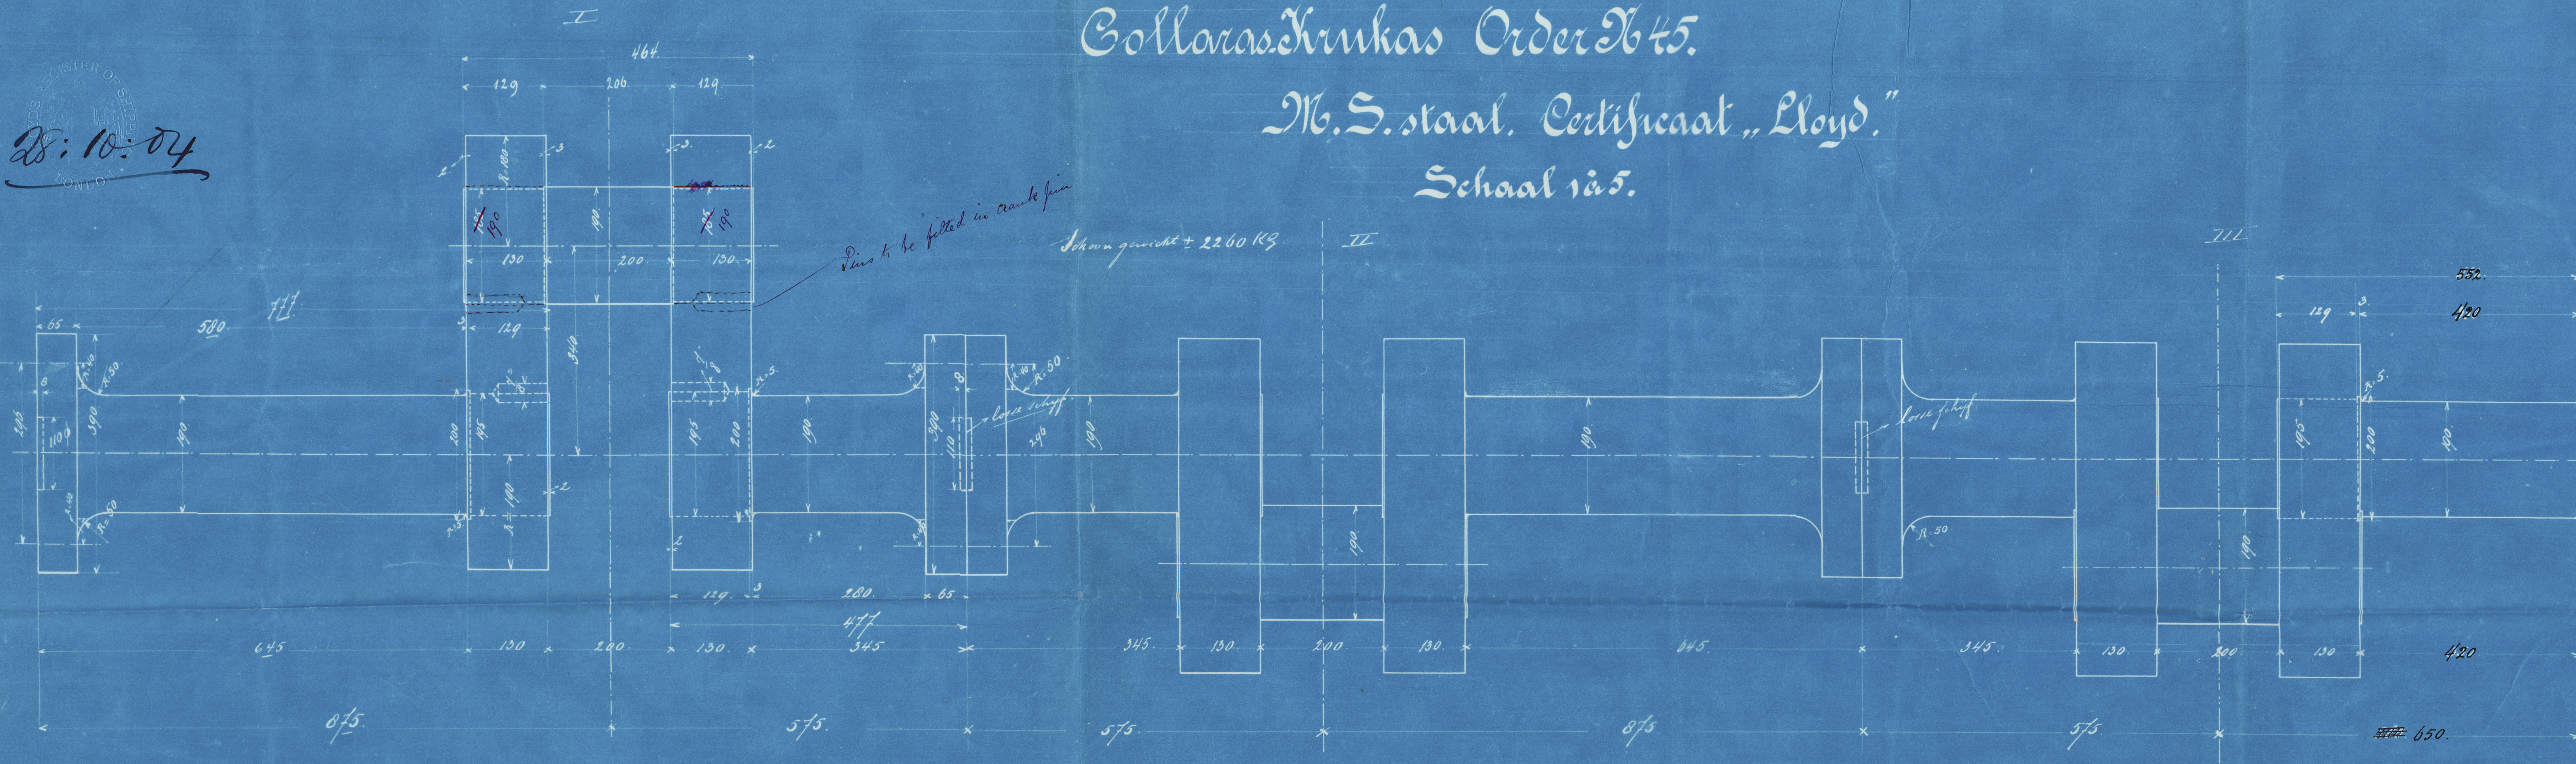

Naamloze Vennootschap
„Alblasserdamsche Machinefabriek”
Alblasserdam

dato: 19/10 '04.
Com. No. 4/5

Gezien: *[Signature]*

Diam. Intermediate shafts 180 mm.
" " Propeller shaft }
no brass liners



Propeller shaft

Machin. $365 \times 595 \times 900 \text{ mm}$
600 mm

Engin. $14 \frac{3}{8} \times 23 \frac{7}{16} \times 38 \frac{9}{16} \text{ mm}$
26 $\frac{3}{4}$ mm

Diam. Propeller 9' 4"


Minimum length of stem 32' 9"

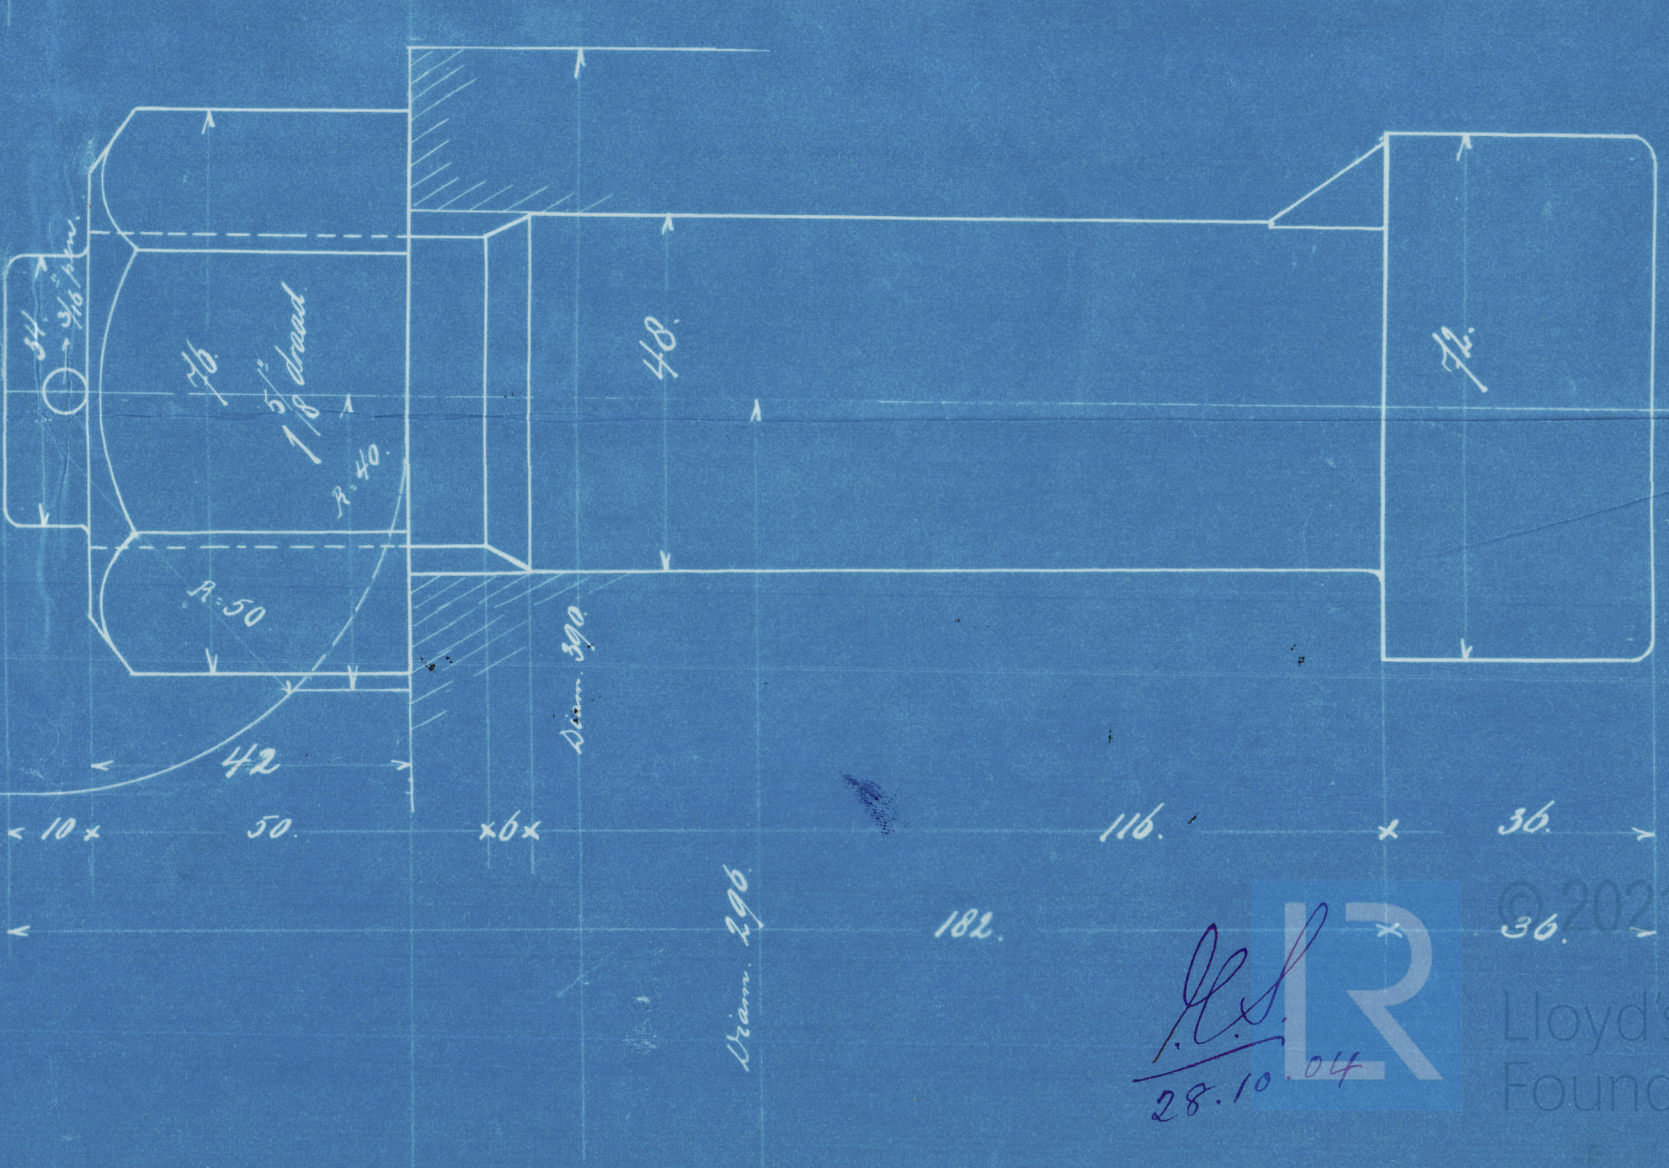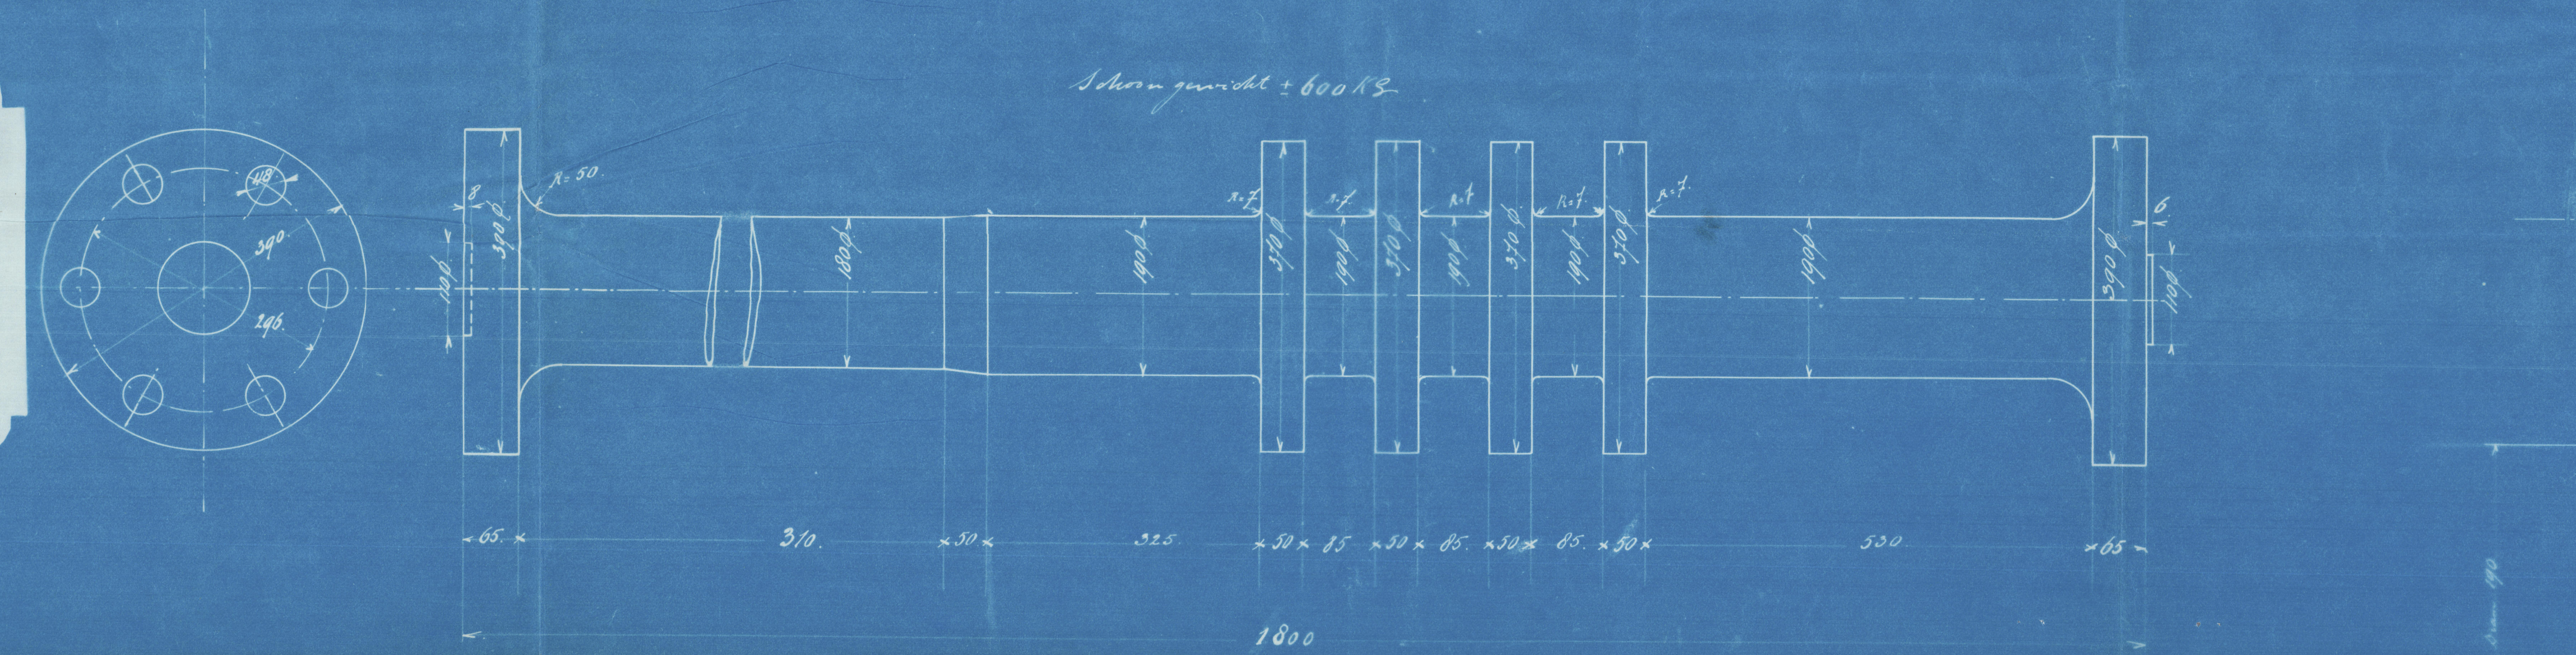



Screwtrug "Maas"
Shafting -

Port of Rotterdam
Report N^o 4340.

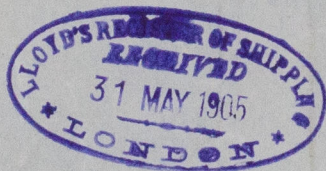

© 2021

Lloyd's Register
Foundation

W782-0026