



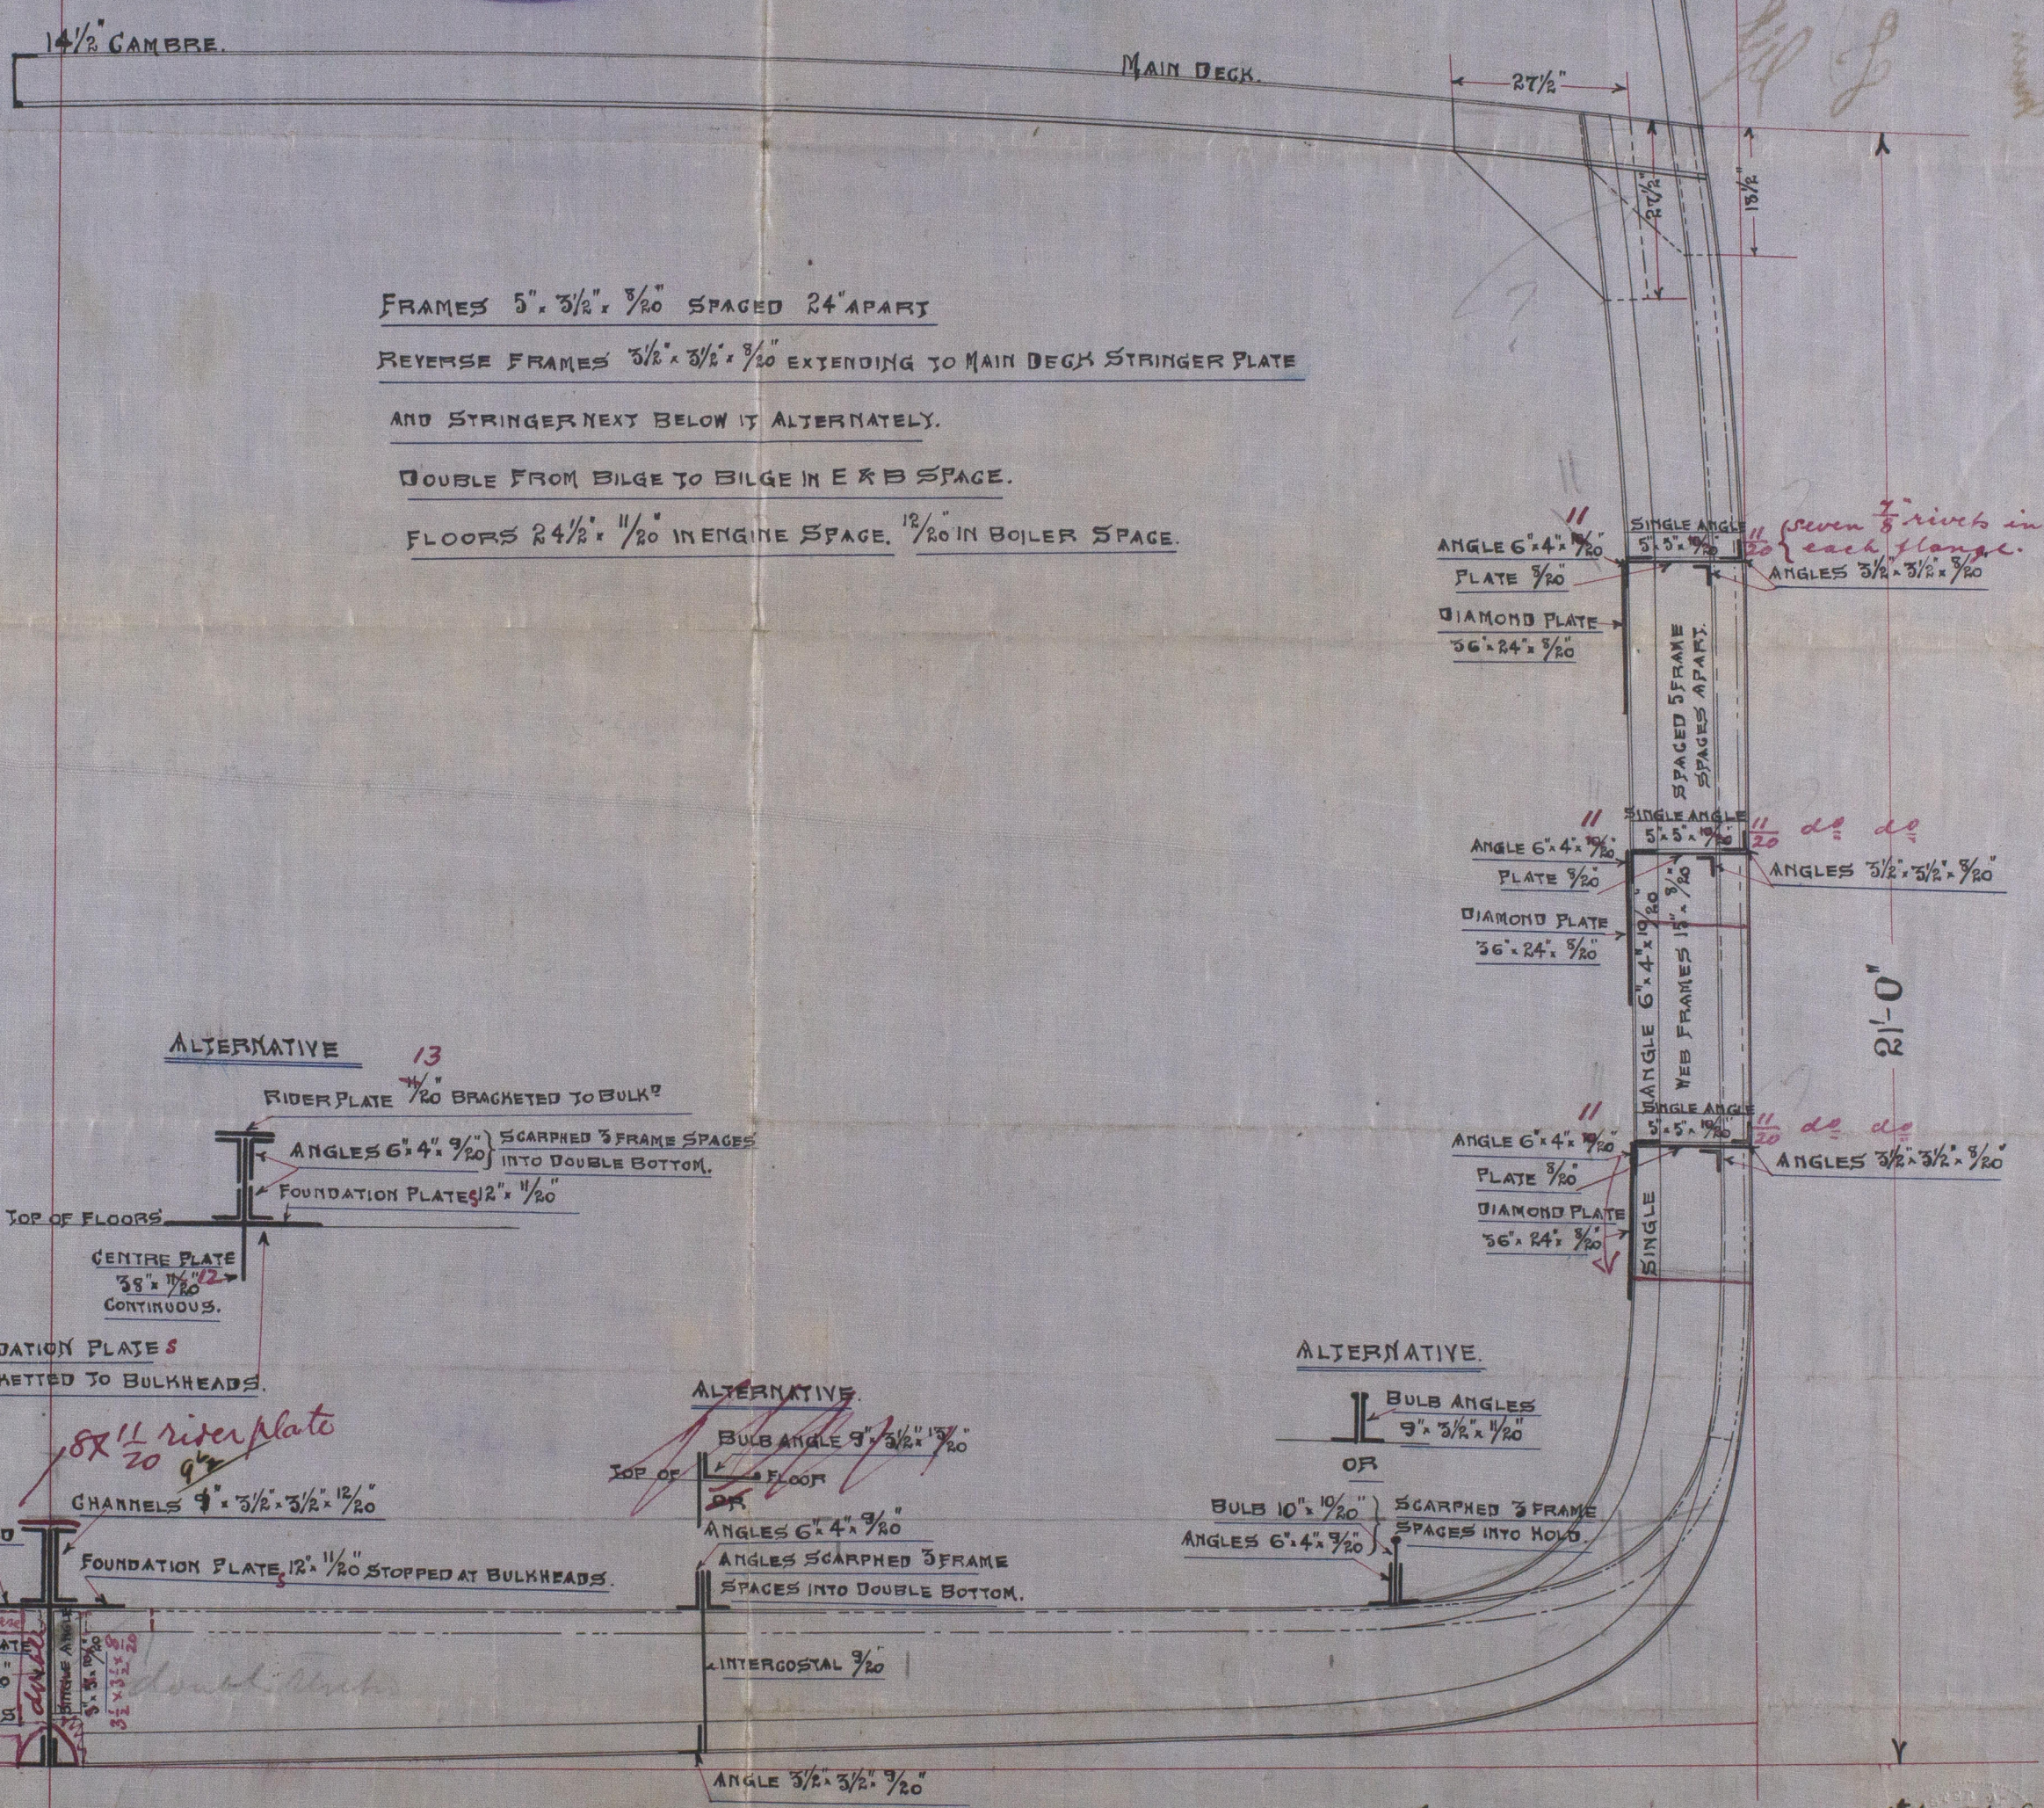

5-3-00

MIDSHIP SECTION
IN
ENGINE & BOILER SPACE

F.N. = 83.56
P.N. = 23758.61.

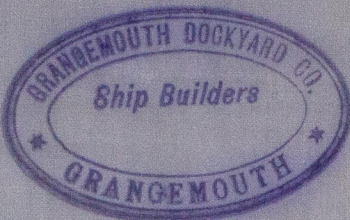

Handwritten notes in the top right corner, including "Seven 7 rivets in each flange" and "Angles 3 1/2 x 3 1/2 x 3/20".

Handwritten signature and date: 5/3/00

PRIVATE GRAVING DOCK 275 FEET LONG.

26th March 1900

GRANGEMOUTH DOCKYARD CO.,
GRANGEMOUTH, N.B.

This Enclosure is to be Sent to

Order No.

211 Mr. Lloyd's Surveyors

Tracing No.

86

Grangeville

WJ 8.3 - 0162 (1/2)

5-3-00

Midship Section in
E & B Space.
Invers. Smith. Dryd. Co.

S. S. No 711

S.P. Restored -
Gil Report No 12902

RECEIVED
2 MAR 1900

© 2020

Lloyd's Register
Foundation

W783-0162 (212)