

MIDSHIP SECTION

SS № 144

SCALE $\frac{1}{2}$ INCH = 1 FOOT

TO CLASS 100A1 AT LLOYDS STEEL

DIMENSIONS 155'-0" x 25'-6" MLD x 12'-3" MLD

PROPORTIONS

DEPTHS TO LENGTH = 12.04

BREADTHS TO LENGTH = 6.03

ROUND OF BEAM

MAIN AND QUARTER DKS = $6\frac{1}{2}$

BRIDGE AND FS'LE DKS = 9 1/2"

- NUMERALS

HALF GIRTH = 23.18 -

HALF BREADTH = 12.45

DEPTH = 12.49

1ST NUMERAL = 48-42 ✓

$$\times 153.94$$

2ND NUMERAL = 4499.95

$$+ 992$$

| <u>EQUIPT</u> | <u>NUMERAL</u> |
|---------------|----------------|
| | 8491.95 |


ER ECTIONS

QUARTER DECK $82 \cdot 25 \times 3 \cdot 5 \times 2 = 618$

BRIDGE $10.50 \times 4.0 \times 1.5 = 112$

FORECASTLE $25.00 \times 4.0 \times 1.5 = 150$

992

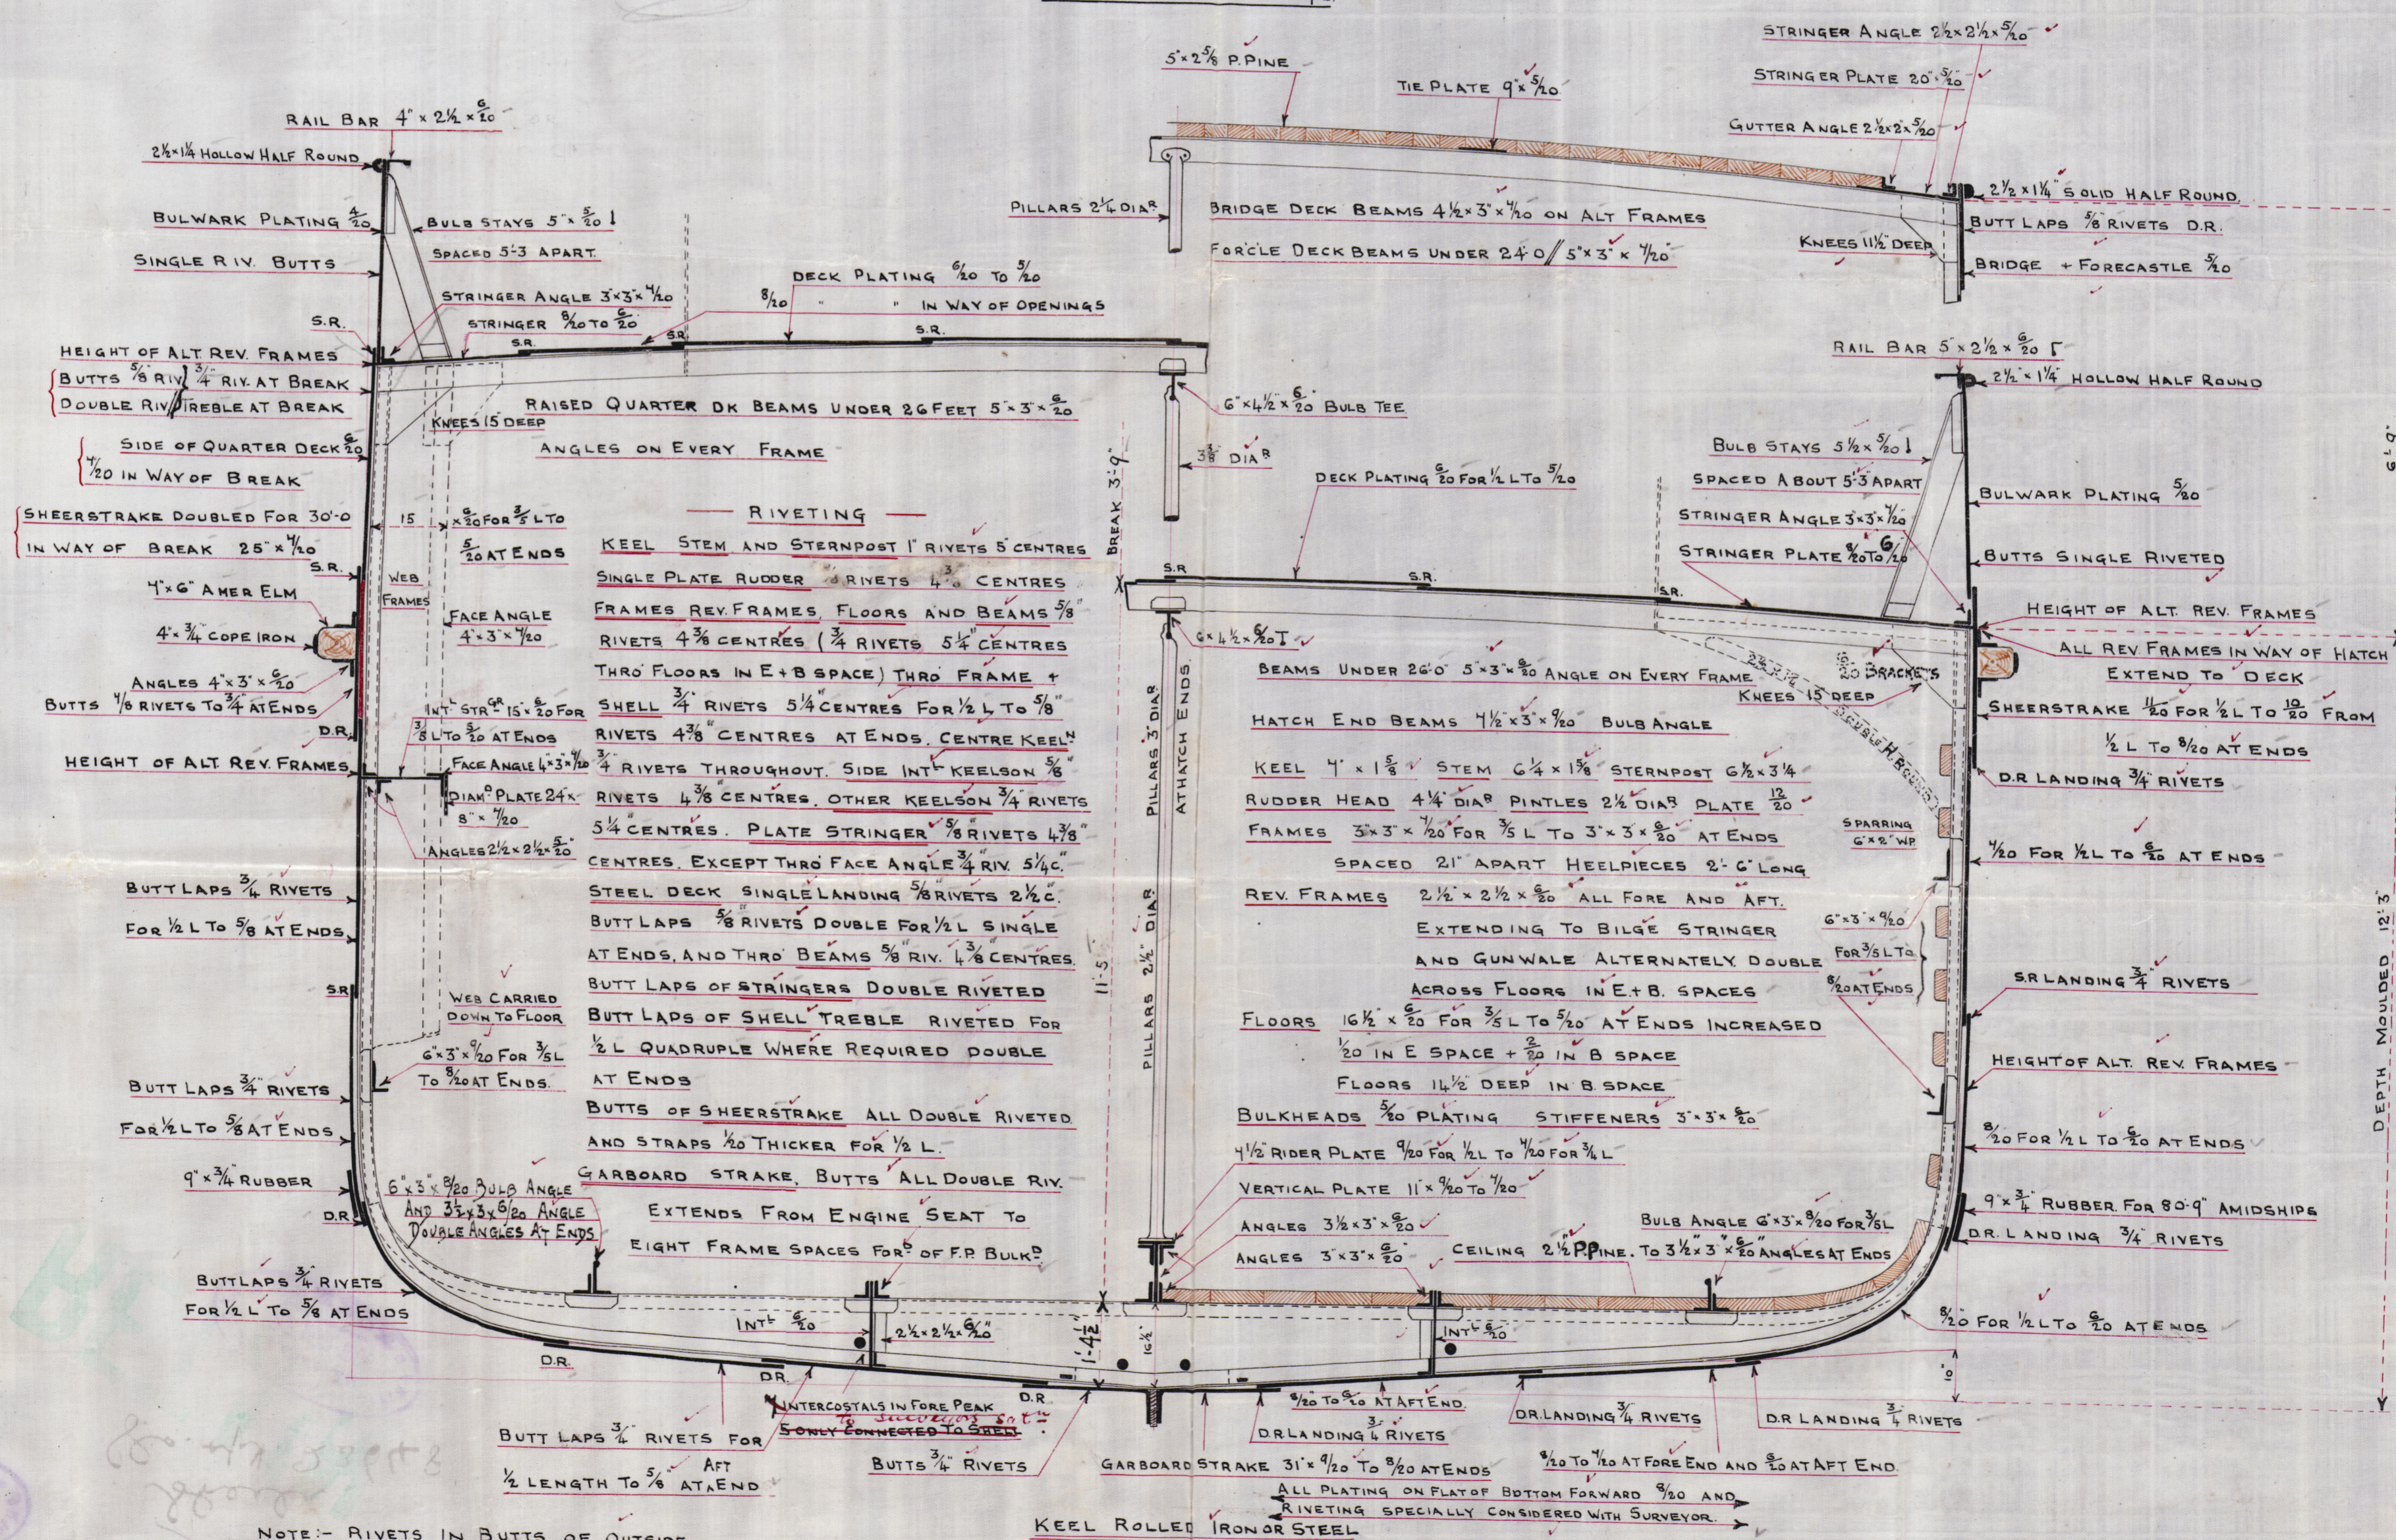

NOTE:- RIVETS IN BUTTS OF OUTSIDE

PLATING AND STRINGERS SPACED

3 1/2" DIARS APART. AND 4 TO 4 1/2" DIARS

IN EDGES OF PLATING AND AT OTHER PARTS

KEEL ROLLED ✓ IRON OR STEEL ← RIVETING


© 2020

Lloyd's Register
Foundation

W785 - 0048

No 144

Arlosa Co. Ltd.

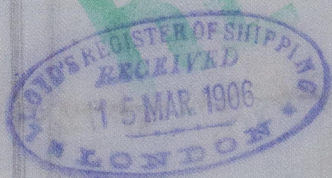

Sheila

Sheila
Geo. npt. 23648

W785-0048



© 2020

Lloyd's Register
Foundation