


14.2.05.

S.S. No. 77.  
PROFILE & DECK PLAN.  
DIMS. 143-0 23-0 x 10-6 MLD.  
SCALE 1/4" = 1 FT.



*Drawn supported to  
Surveyors satisfaction*

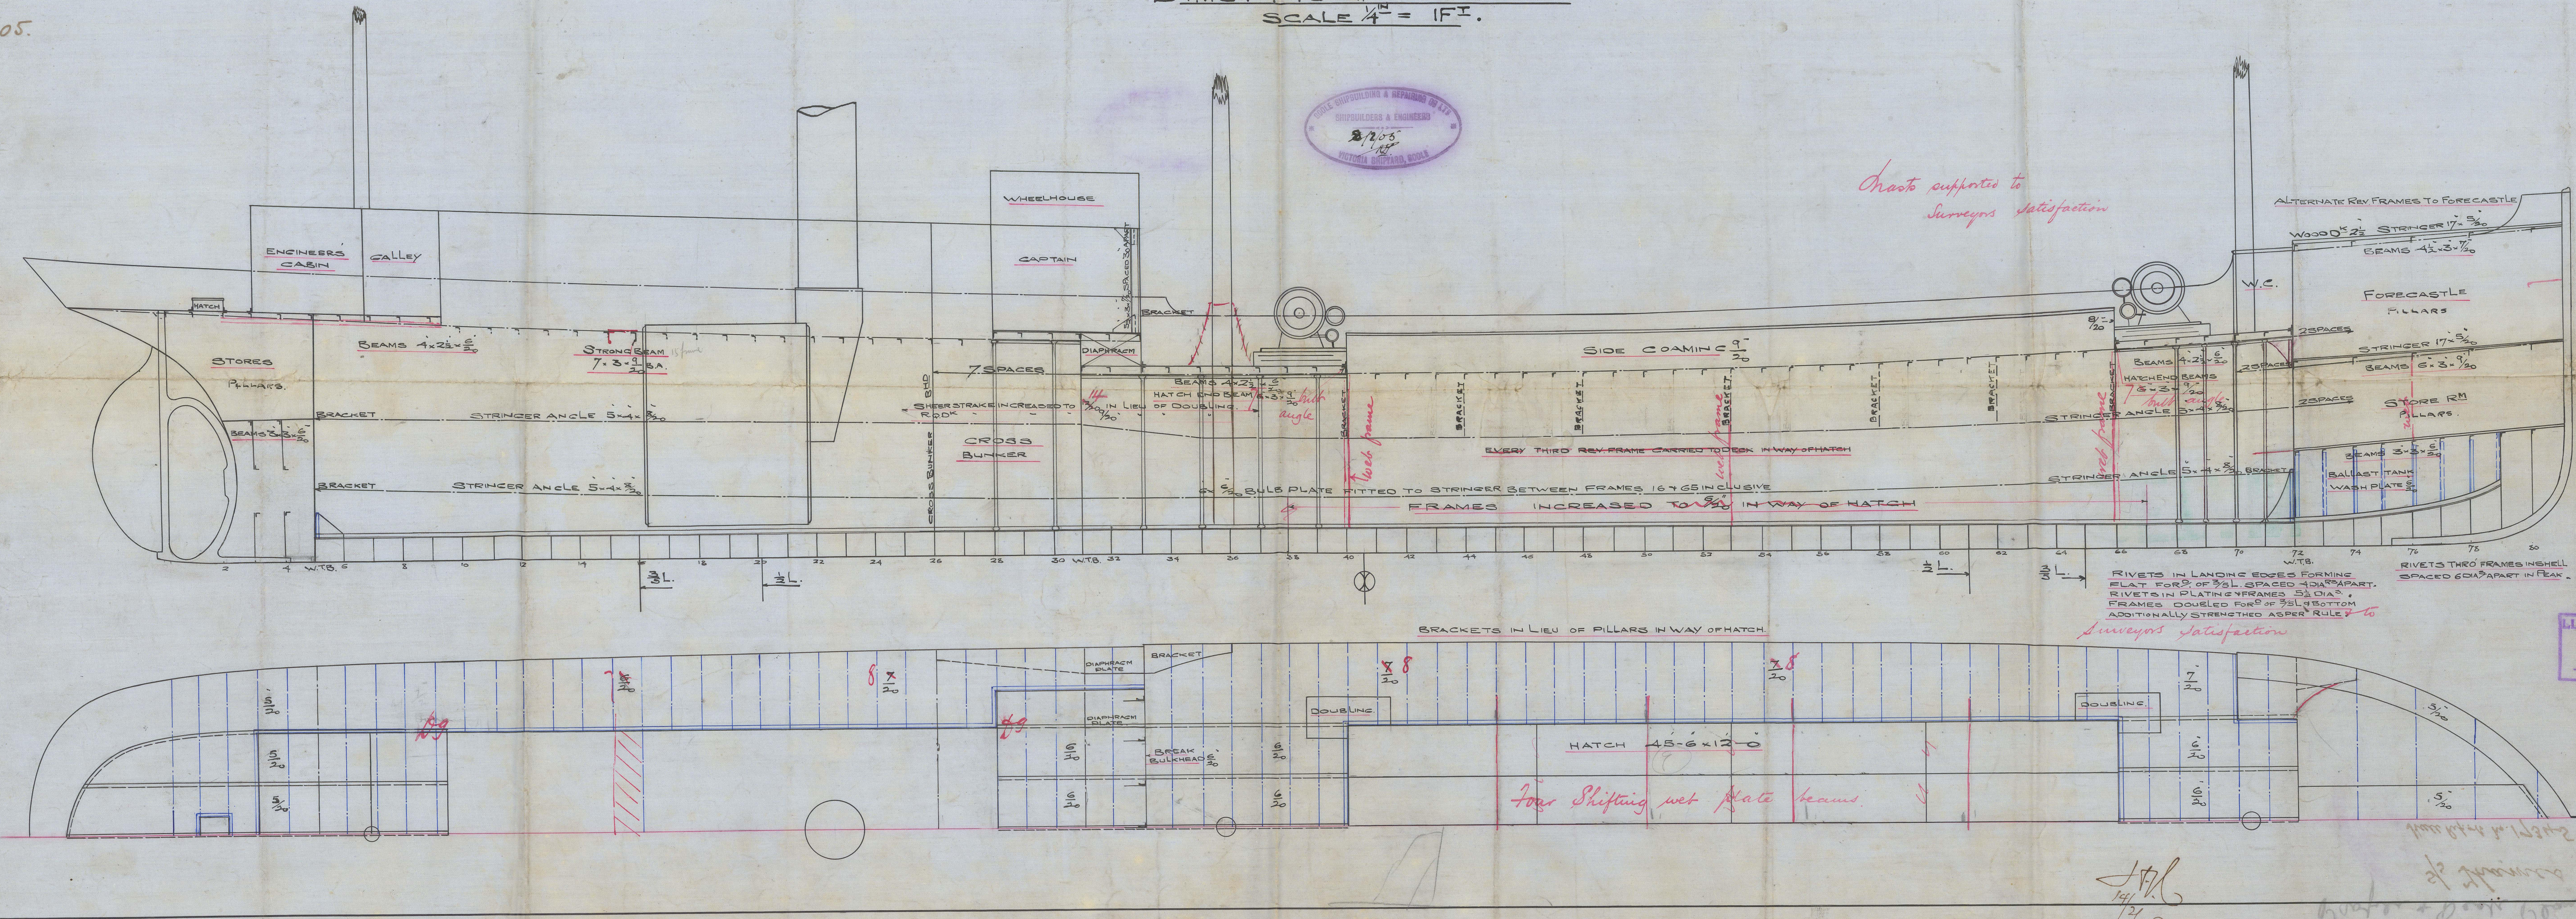

*J.H.L.  
14/2/05*

*over 21 15 C. 21*






Book S + R C: 2d

N: 77

Profile + Deck Plan  
s/ Thames

Hull Report No. 17345

1/5/02  
1st  
74/8

 





© 2021

Lloyd's Register  
Foundation

W787-0068