

Copy of Midship Section to accompany  
1<sup>st</sup> Entry Report No 145314

*AS*

S.S. DEN or KELLY

MIDSHIP SECTION. S.S. N<sup>o</sup> 555  
DIMENSIONS 385' x 49'-9" EX x 49'-7" MLD x 29'-0" MLD TO SPAR DECK.  
10 CLASS 100 A.I. AT LLOYDS. SPECIAL SURVEY, SPAR DECK RULE.  
SCALE 1/2 INCH = 1 FOOT.



Numerals.

Half Beam	2479
Half Girth	42'85"
Depth Maindk to keel	22'02"
1 <sup>st</sup> Numeral	89.66
Length	382.5
2 <sup>nd</sup> Numeral	34294.95

Proportions

Beam to length	7.7
Depth to length to spardeck	12.75
" " " Maindk	17.37


Equipment Numeral

Half Girth to Spardeck	50'85"
Depth to Spardeck	30'00"
Half Beam	2479
Length	105'64"
	382.5
	40407.300


Roop 307 Bridge 108 x 7.75 Forecastle 40 x 7.0 } Excesses  
Saloon House 22 x 7.25 Sidchouses 4 x 7.25 }  
Equipment Numeral 42759.3

Equipment

2 Bower anchors	45 cwt. or steel
1 " "	38 " " "
1 Steam " "	15 " " "
1 Redge " "	6 1/2 " " "
270 Fathoms 1/4" stud chain cable	608-2-14
90 " 1 3/16 " steam chain or 4 1/2 steel wire	
120 " 13 " top line or 4 1/2 steel wire	
2 warps 7" 90 fathoms each	
2 " 7" 90 " "	

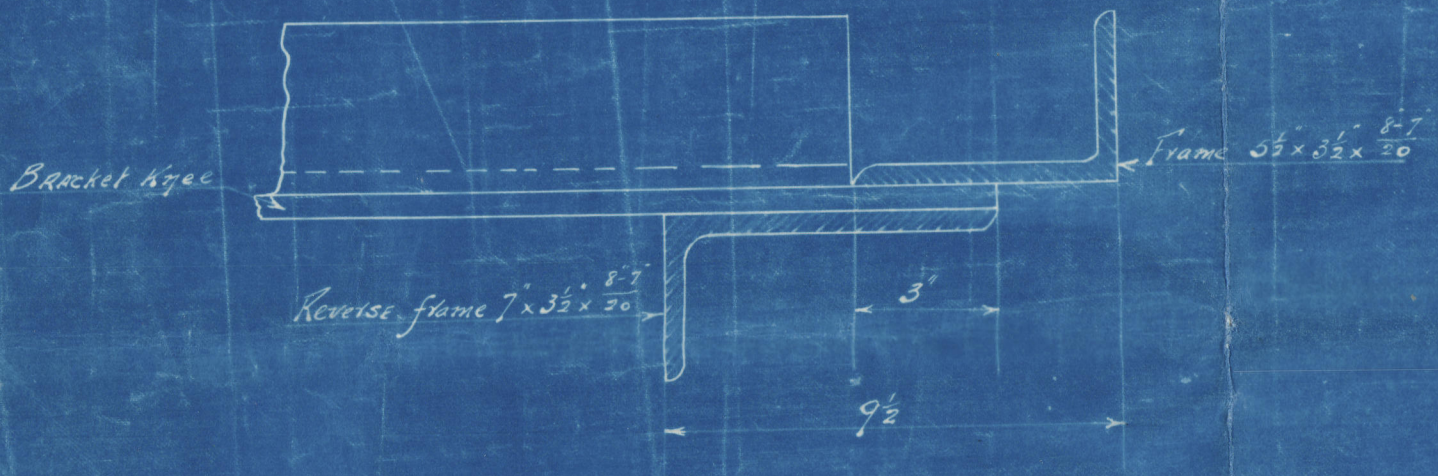

Section of Deep Framing  
Scale 3 inches = 1 foot

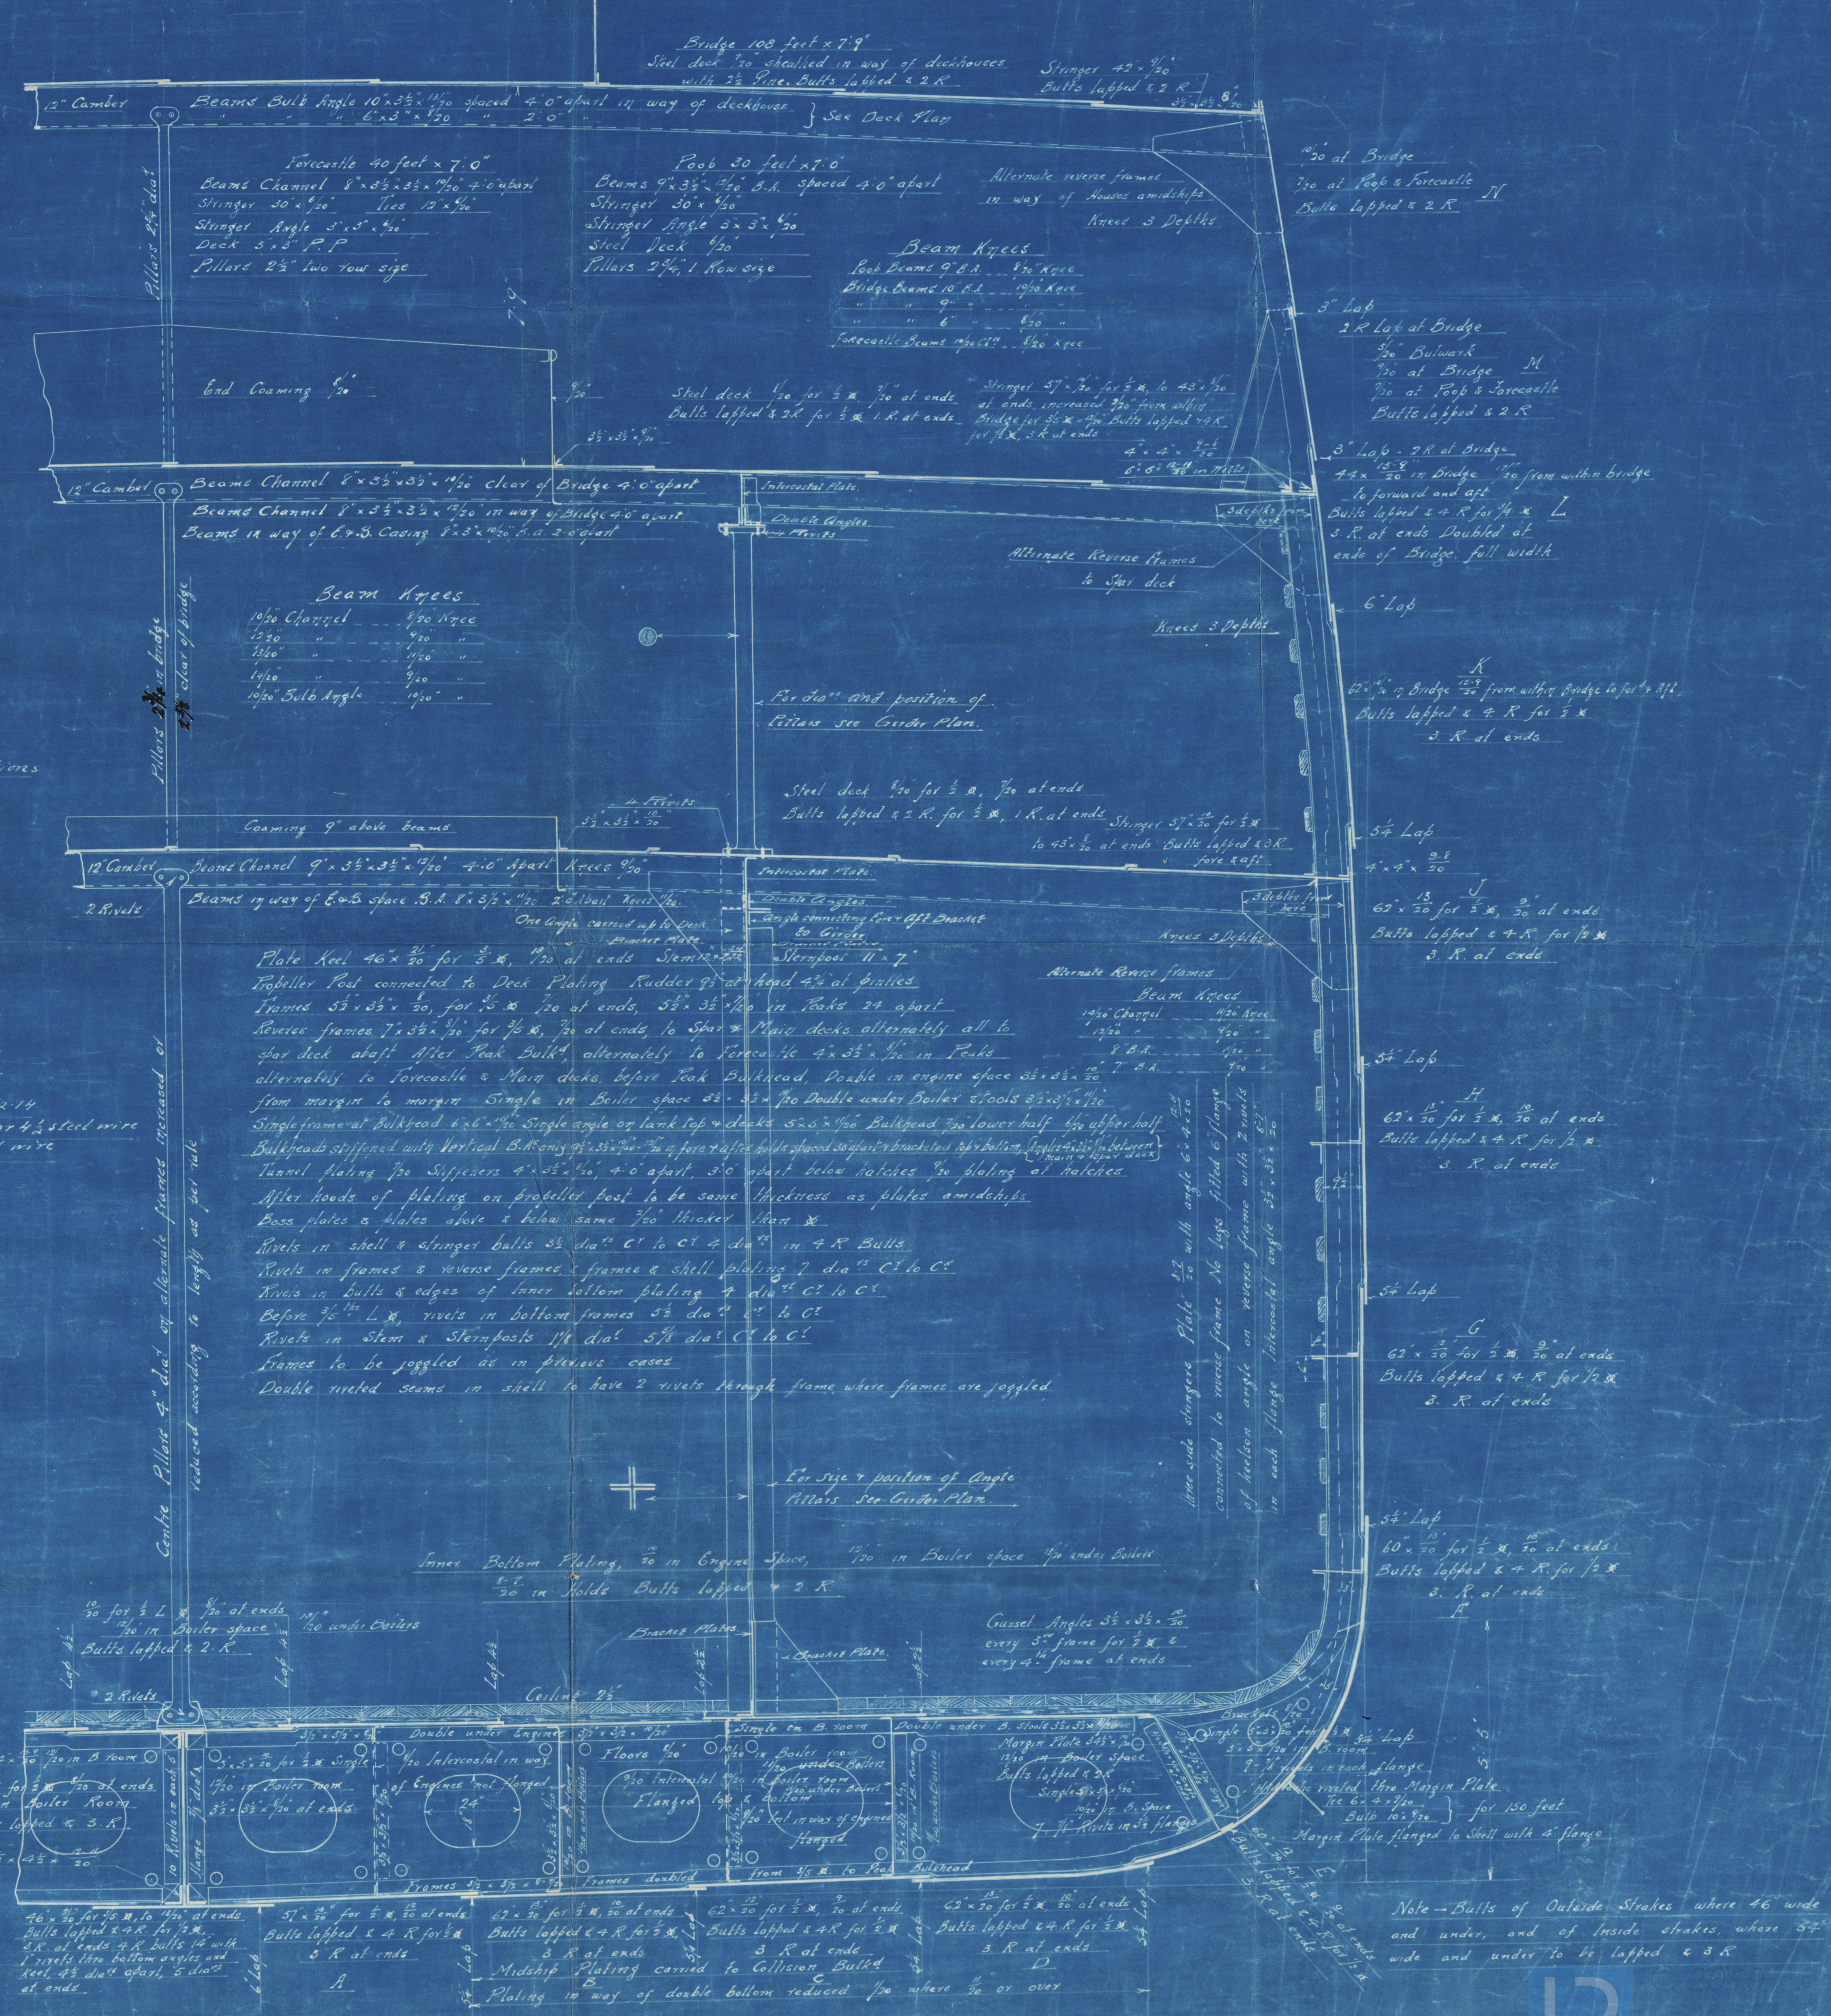

Note - Butts of Outside Strakes where 46 wide and under, and of Inside strakes, where 54 wide and under to be lapped & 3 R



W789-0027

Midship Section  
Russell & Co No 555.

S.S. Den of Kelly.  
Greenock 4th No 14534



Copy as built  
will be in List of docks

RETAIN



© 2019

Lloyd's Register  
Foundation