



No 541.  
PORT BOILER.

POSITION OF STAYS IN STEAM SPACE. *in back*

STAYS SHOWN IN RED AS ACTUALLY FITTED.

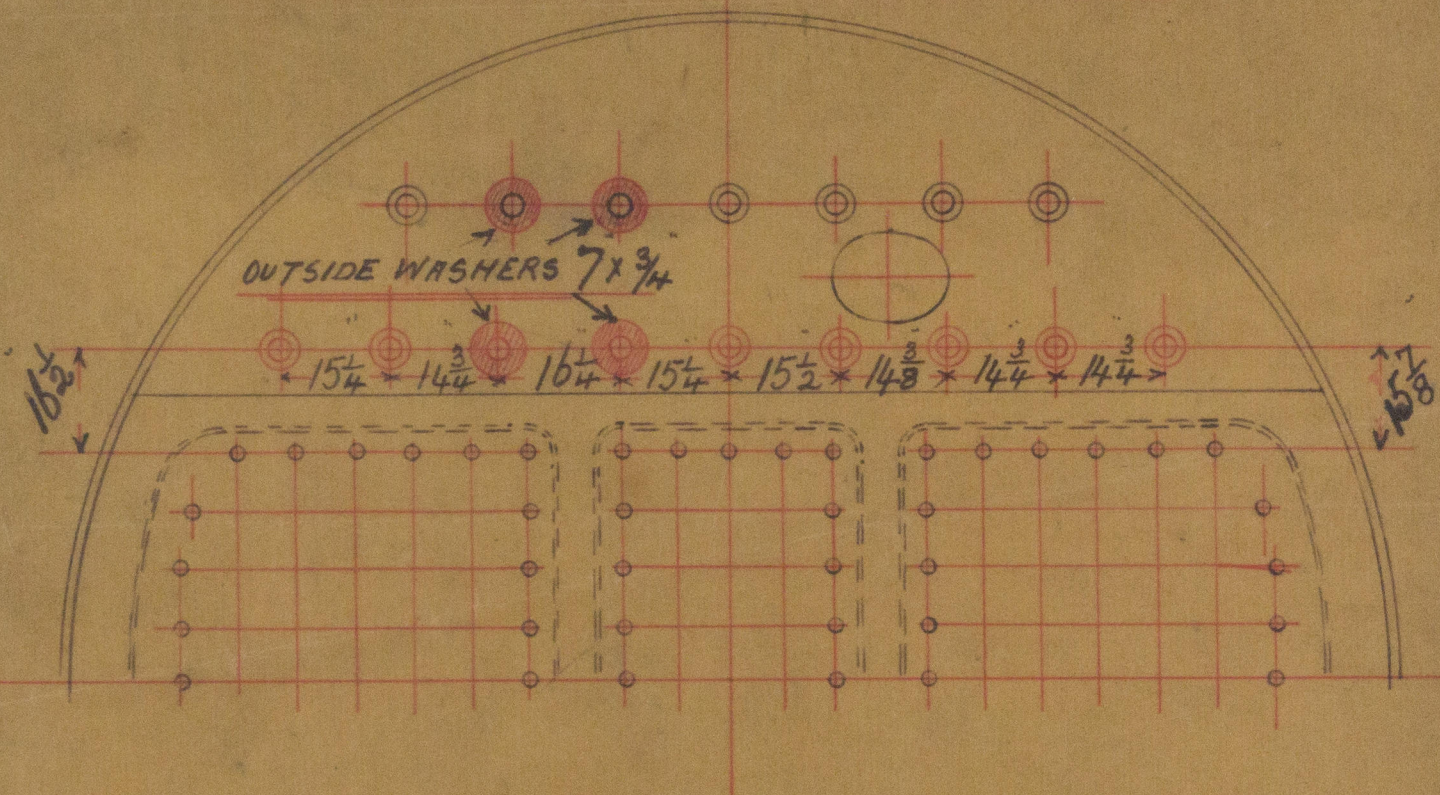

LOOKING ON BACK OF BOILER.

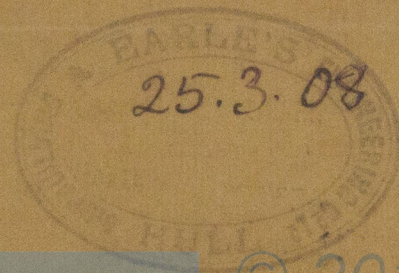

© 2019

Lloyd's Register  
Foundation