



No 541.  
STAR<sup>3D</sup> BOILER.

POSITION OF STAYS IN STEAM SPACE *on back*

STAYS SHOWN IN RED AS ACTUALLY FITTED

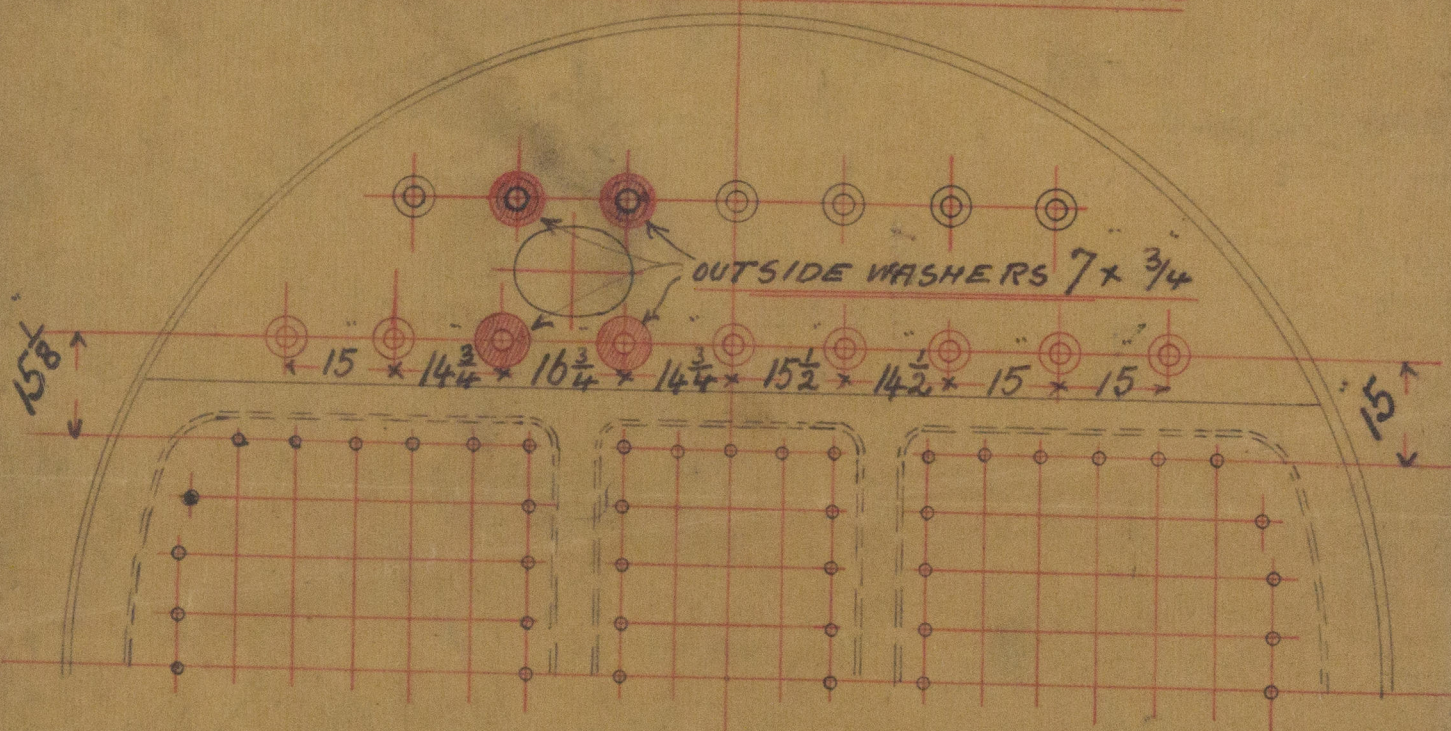

LOOKING ON BACK OF BOILER.

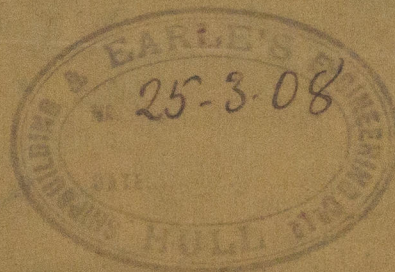

© 2019

Lloyd's Register  
Foundation