

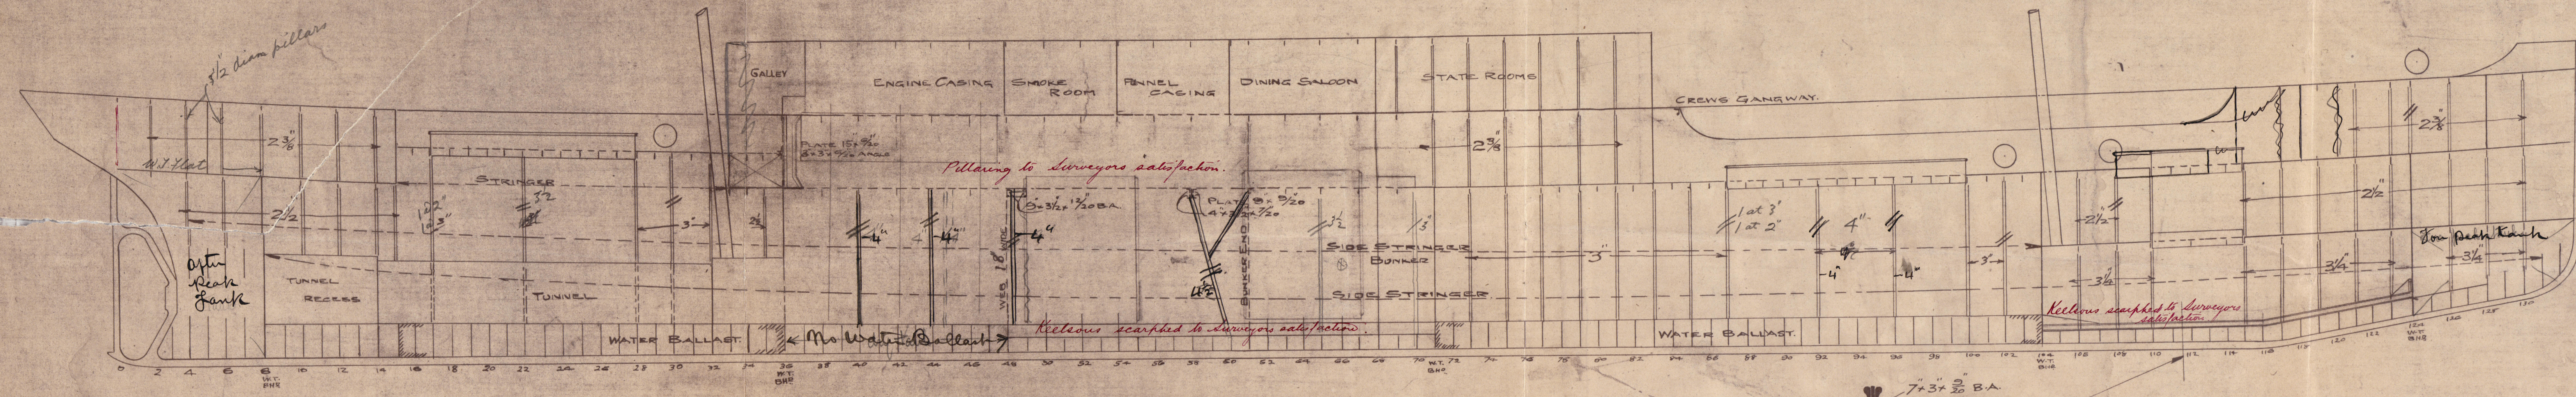
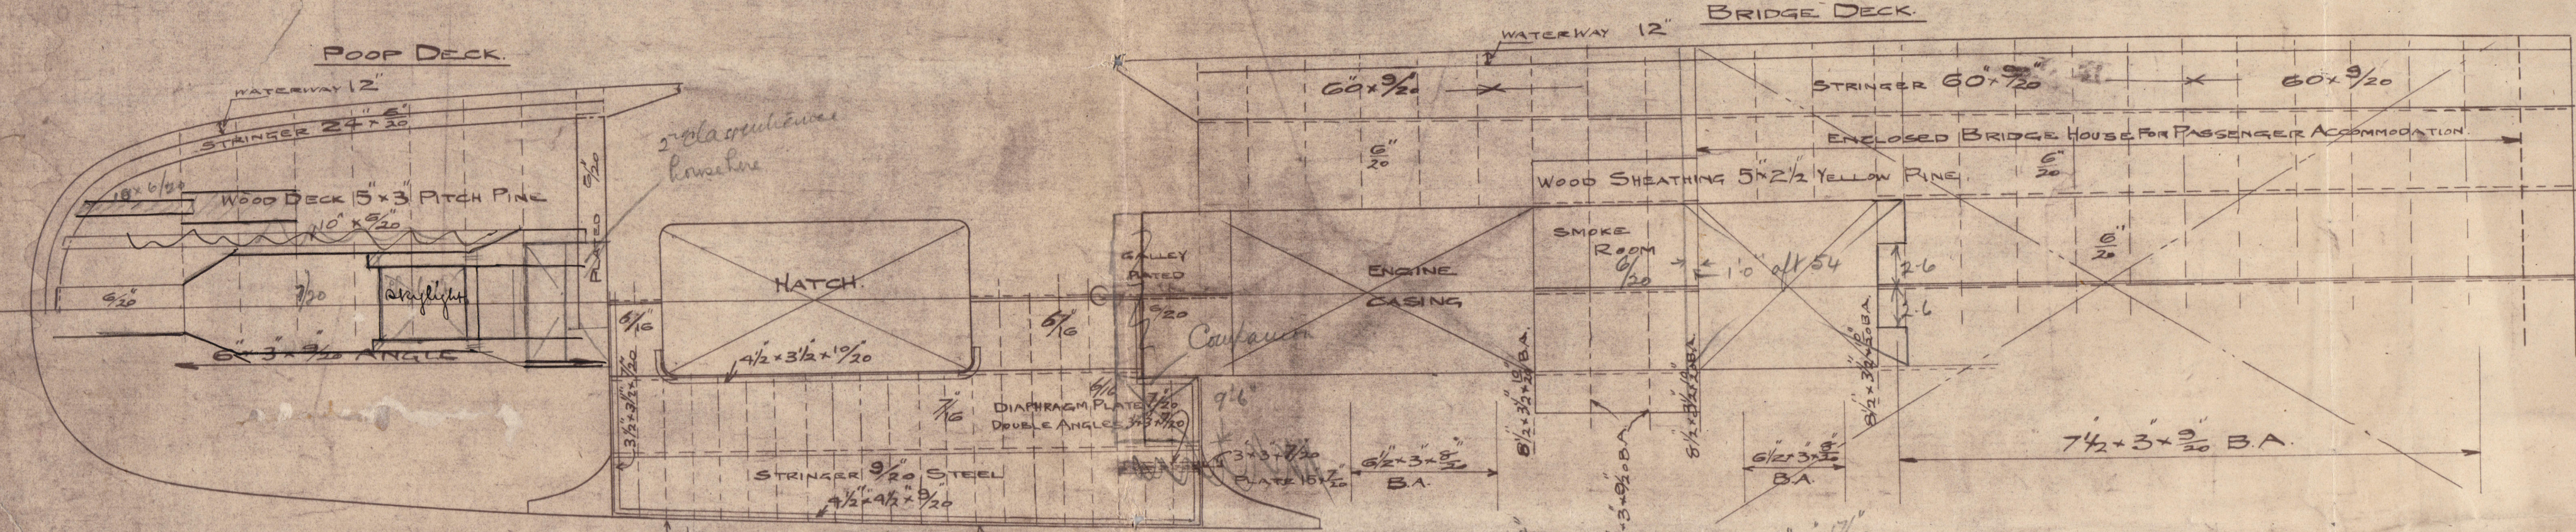
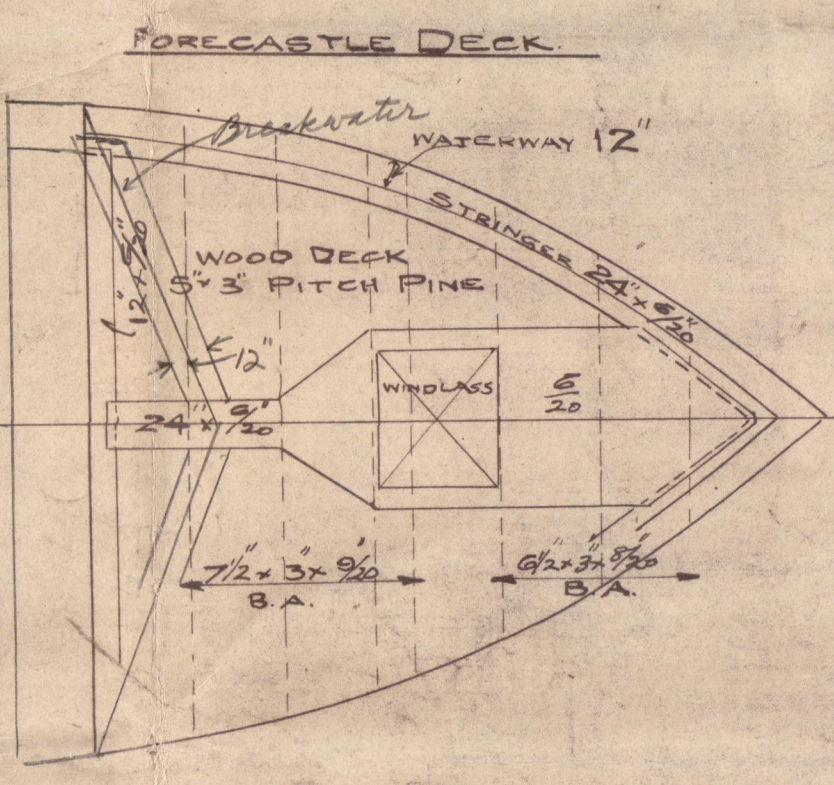
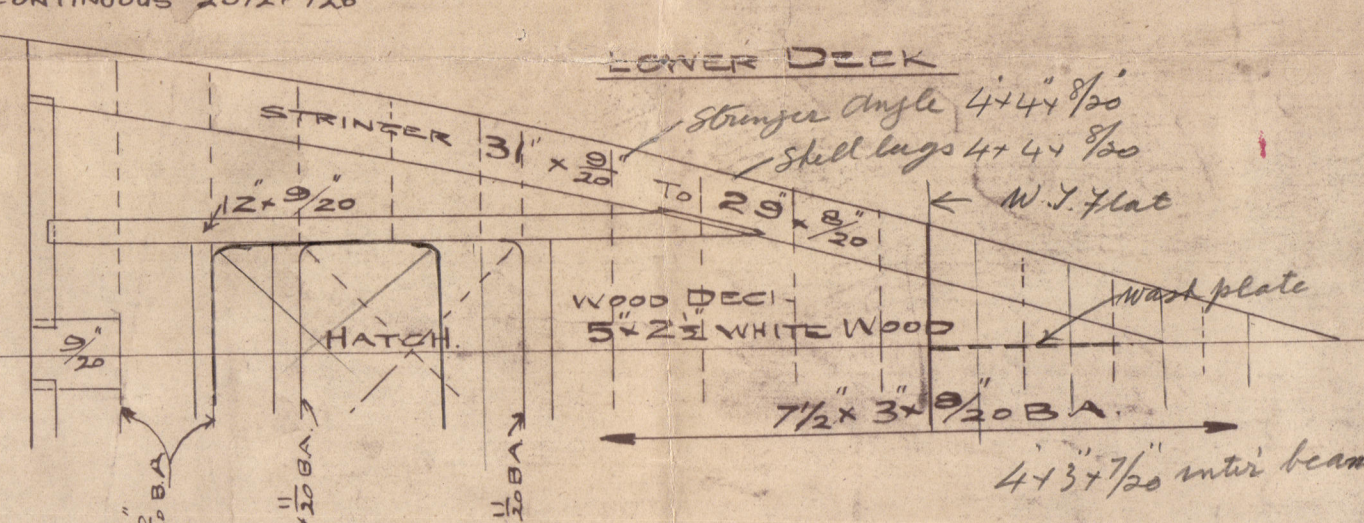


ELEVATION SHEWING  
TOPSIDE PLATING  
ALL BUTTS LAPPED & RIVETED AS SHOWN.


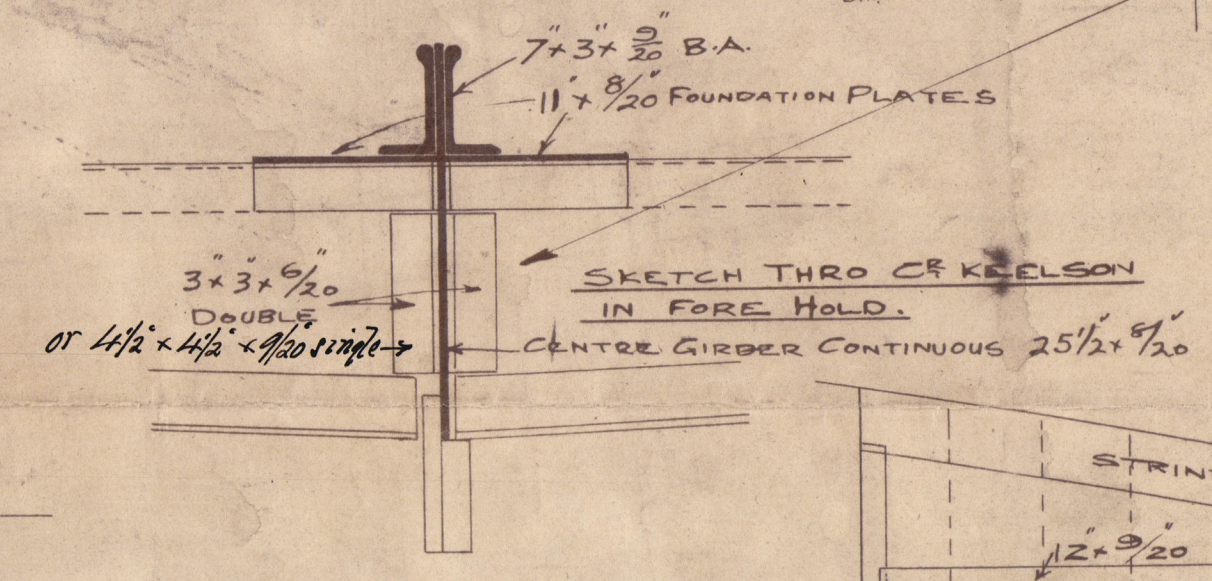


N<sup>OS</sup> 541-2.

255'-0" x 33'-6" x 16'-3" MLD  
SCALE 1/8" = 1 FOOT

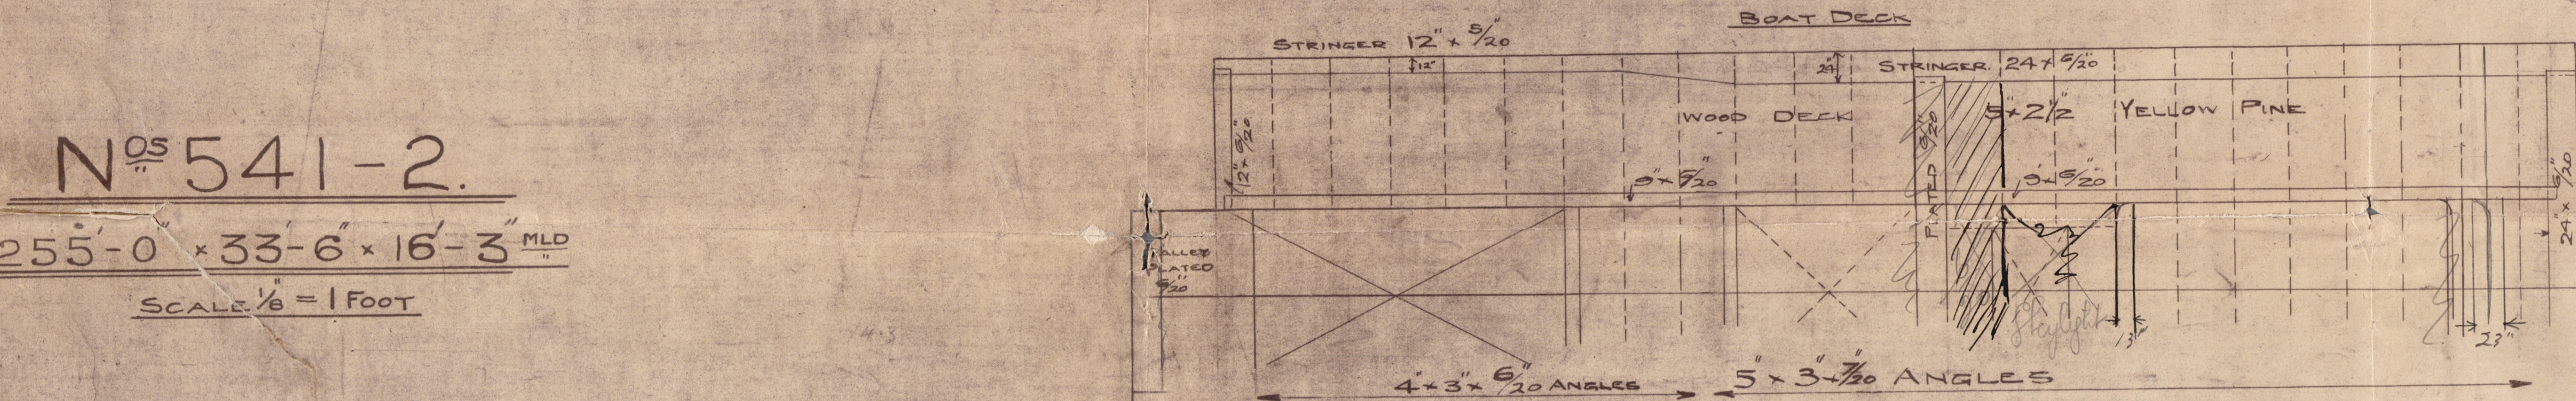

LLOYD'S REGISTER OF SHIPPING  
19 JUL 1907  
+ HULL +

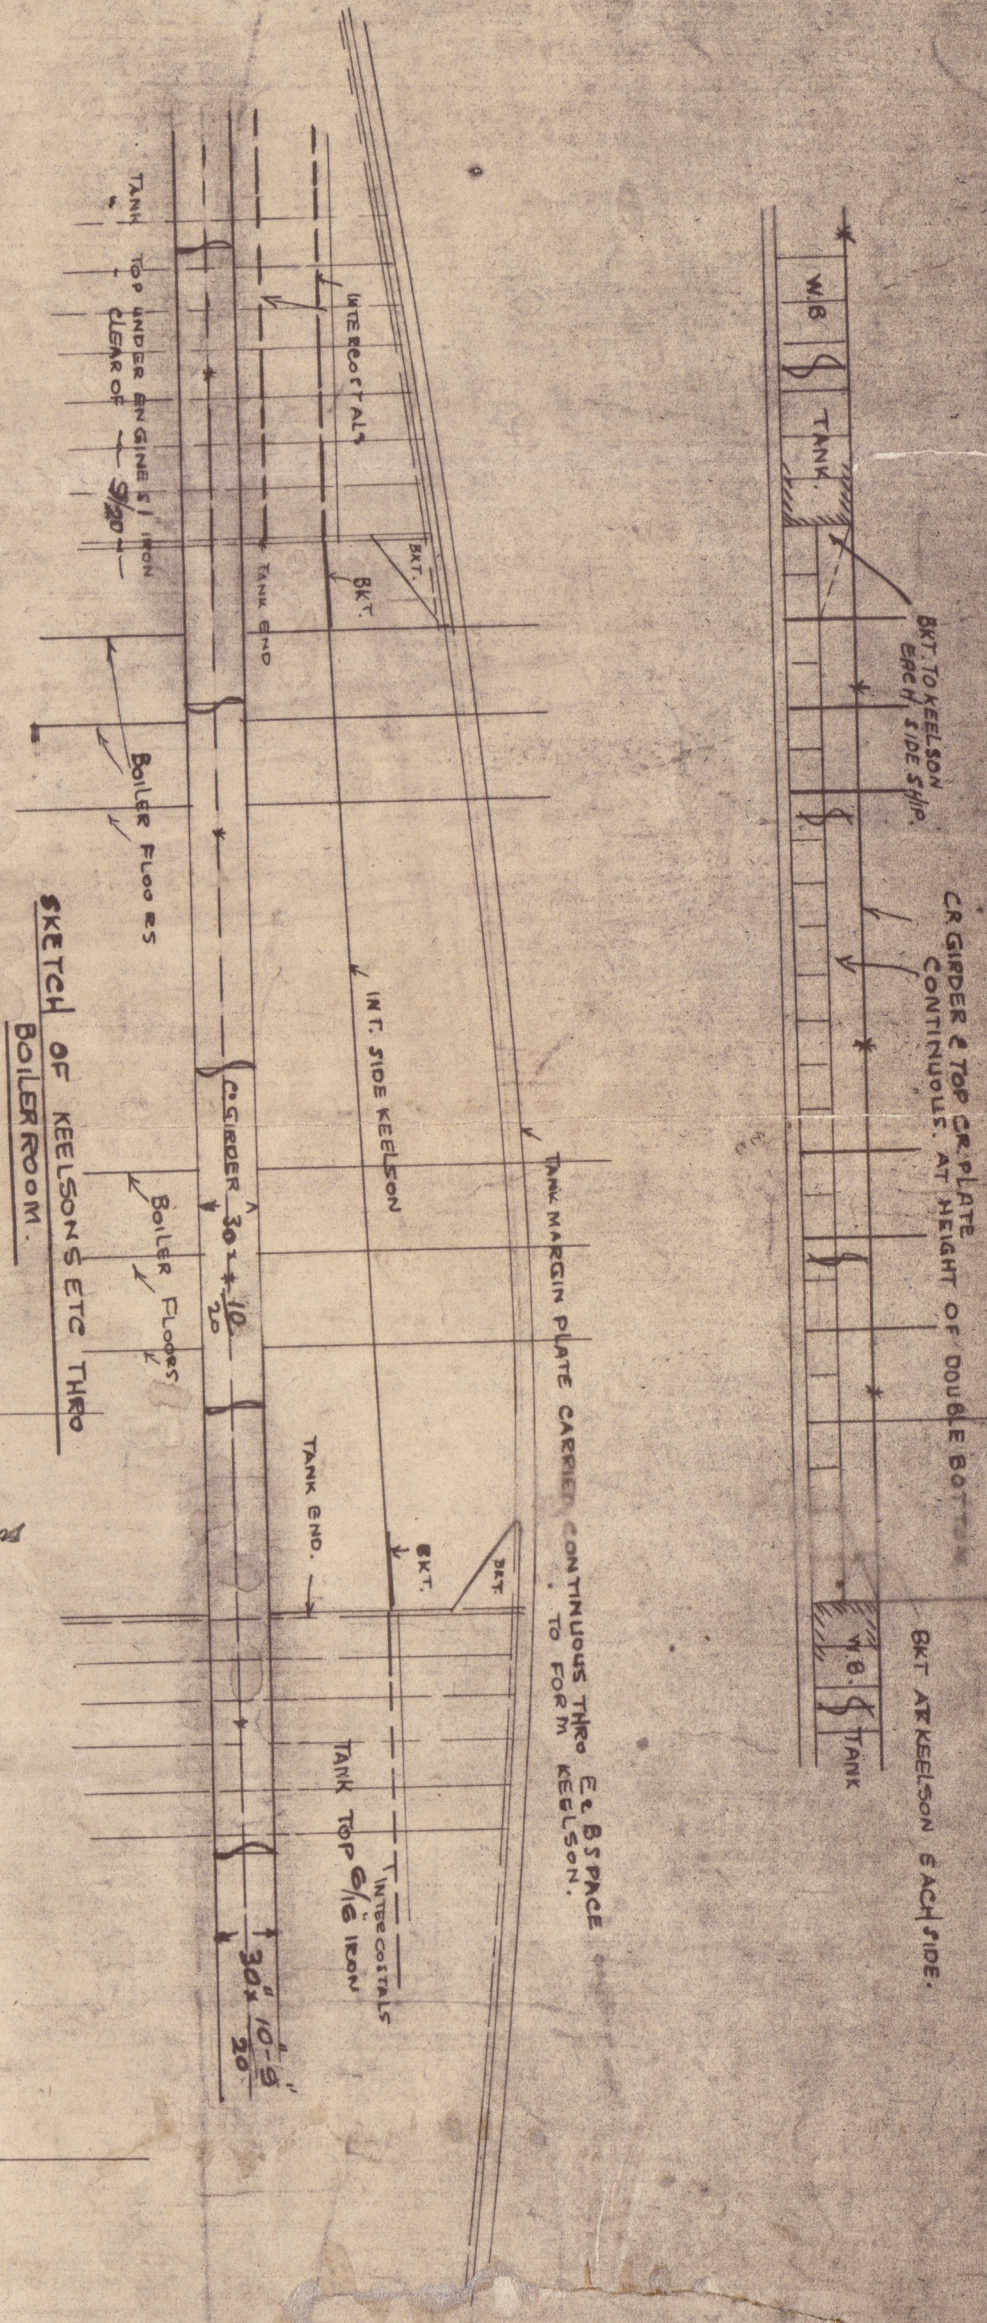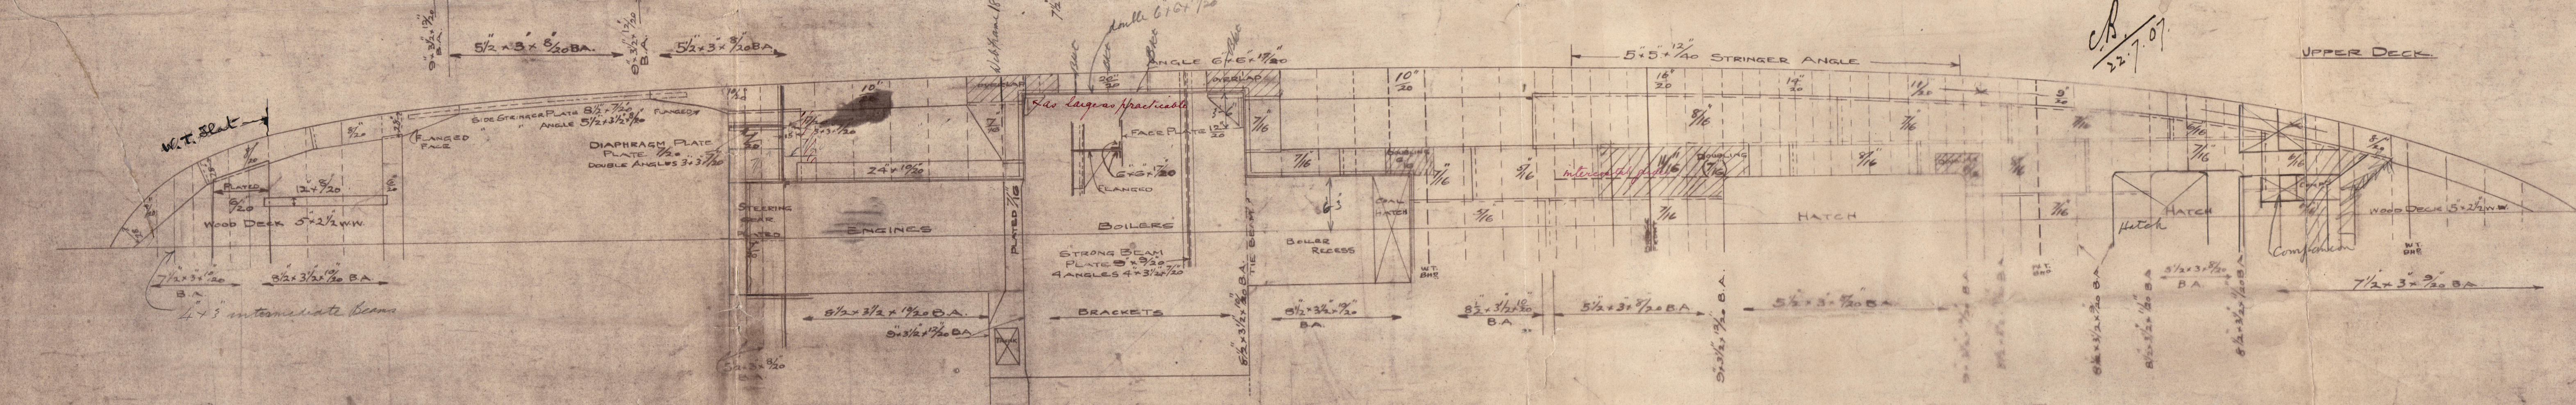

Additional protection to be  
afforded to Plating in  
hull as shown.



amended

Profile & Deck Plan

Carle's S & E. 60 hr

No. 541-2

~~Page~~ s/s Ruvaulty abbey  
Hull Report No. 19962



s/s Kirkham abbey  
Hull Report No. 19969

W789-0133

RETAIN



© 2019

Lloyd's Register  
Foundation