



Amendments

Midship Dechoi


Carl's to be

-No 541-2-

of Puloanly Abbey
Hull Rpt No. 19962

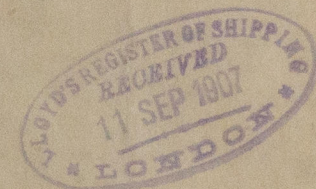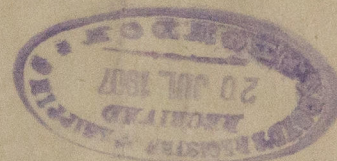

of Kirkham Abbey
Hull Report No. 19969

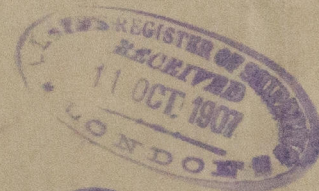

RETAIN



© 2019

Lloyd's Register
Foundation

W789-0134