

10/9/24

PROFILE & DECK PLANS

OF A FULL SCANTLING STEAMER

SCALE 1/8" = 1 FOOT

DIMENSIONS


LENGTH B.P. 348'-0"
BREADTH MW 49'-8 1/2"
DEPTH MD 24'-10 3/4"
CLASS 100A1 LLOYDS.

Hearts, Bricks, Brackets & Steering Gear Supplied to Sunways Shipyard

Stays to Hatch Coaming as per Rules

Chair House in Bay of Porting frame to be provided

See 16 Jan 7

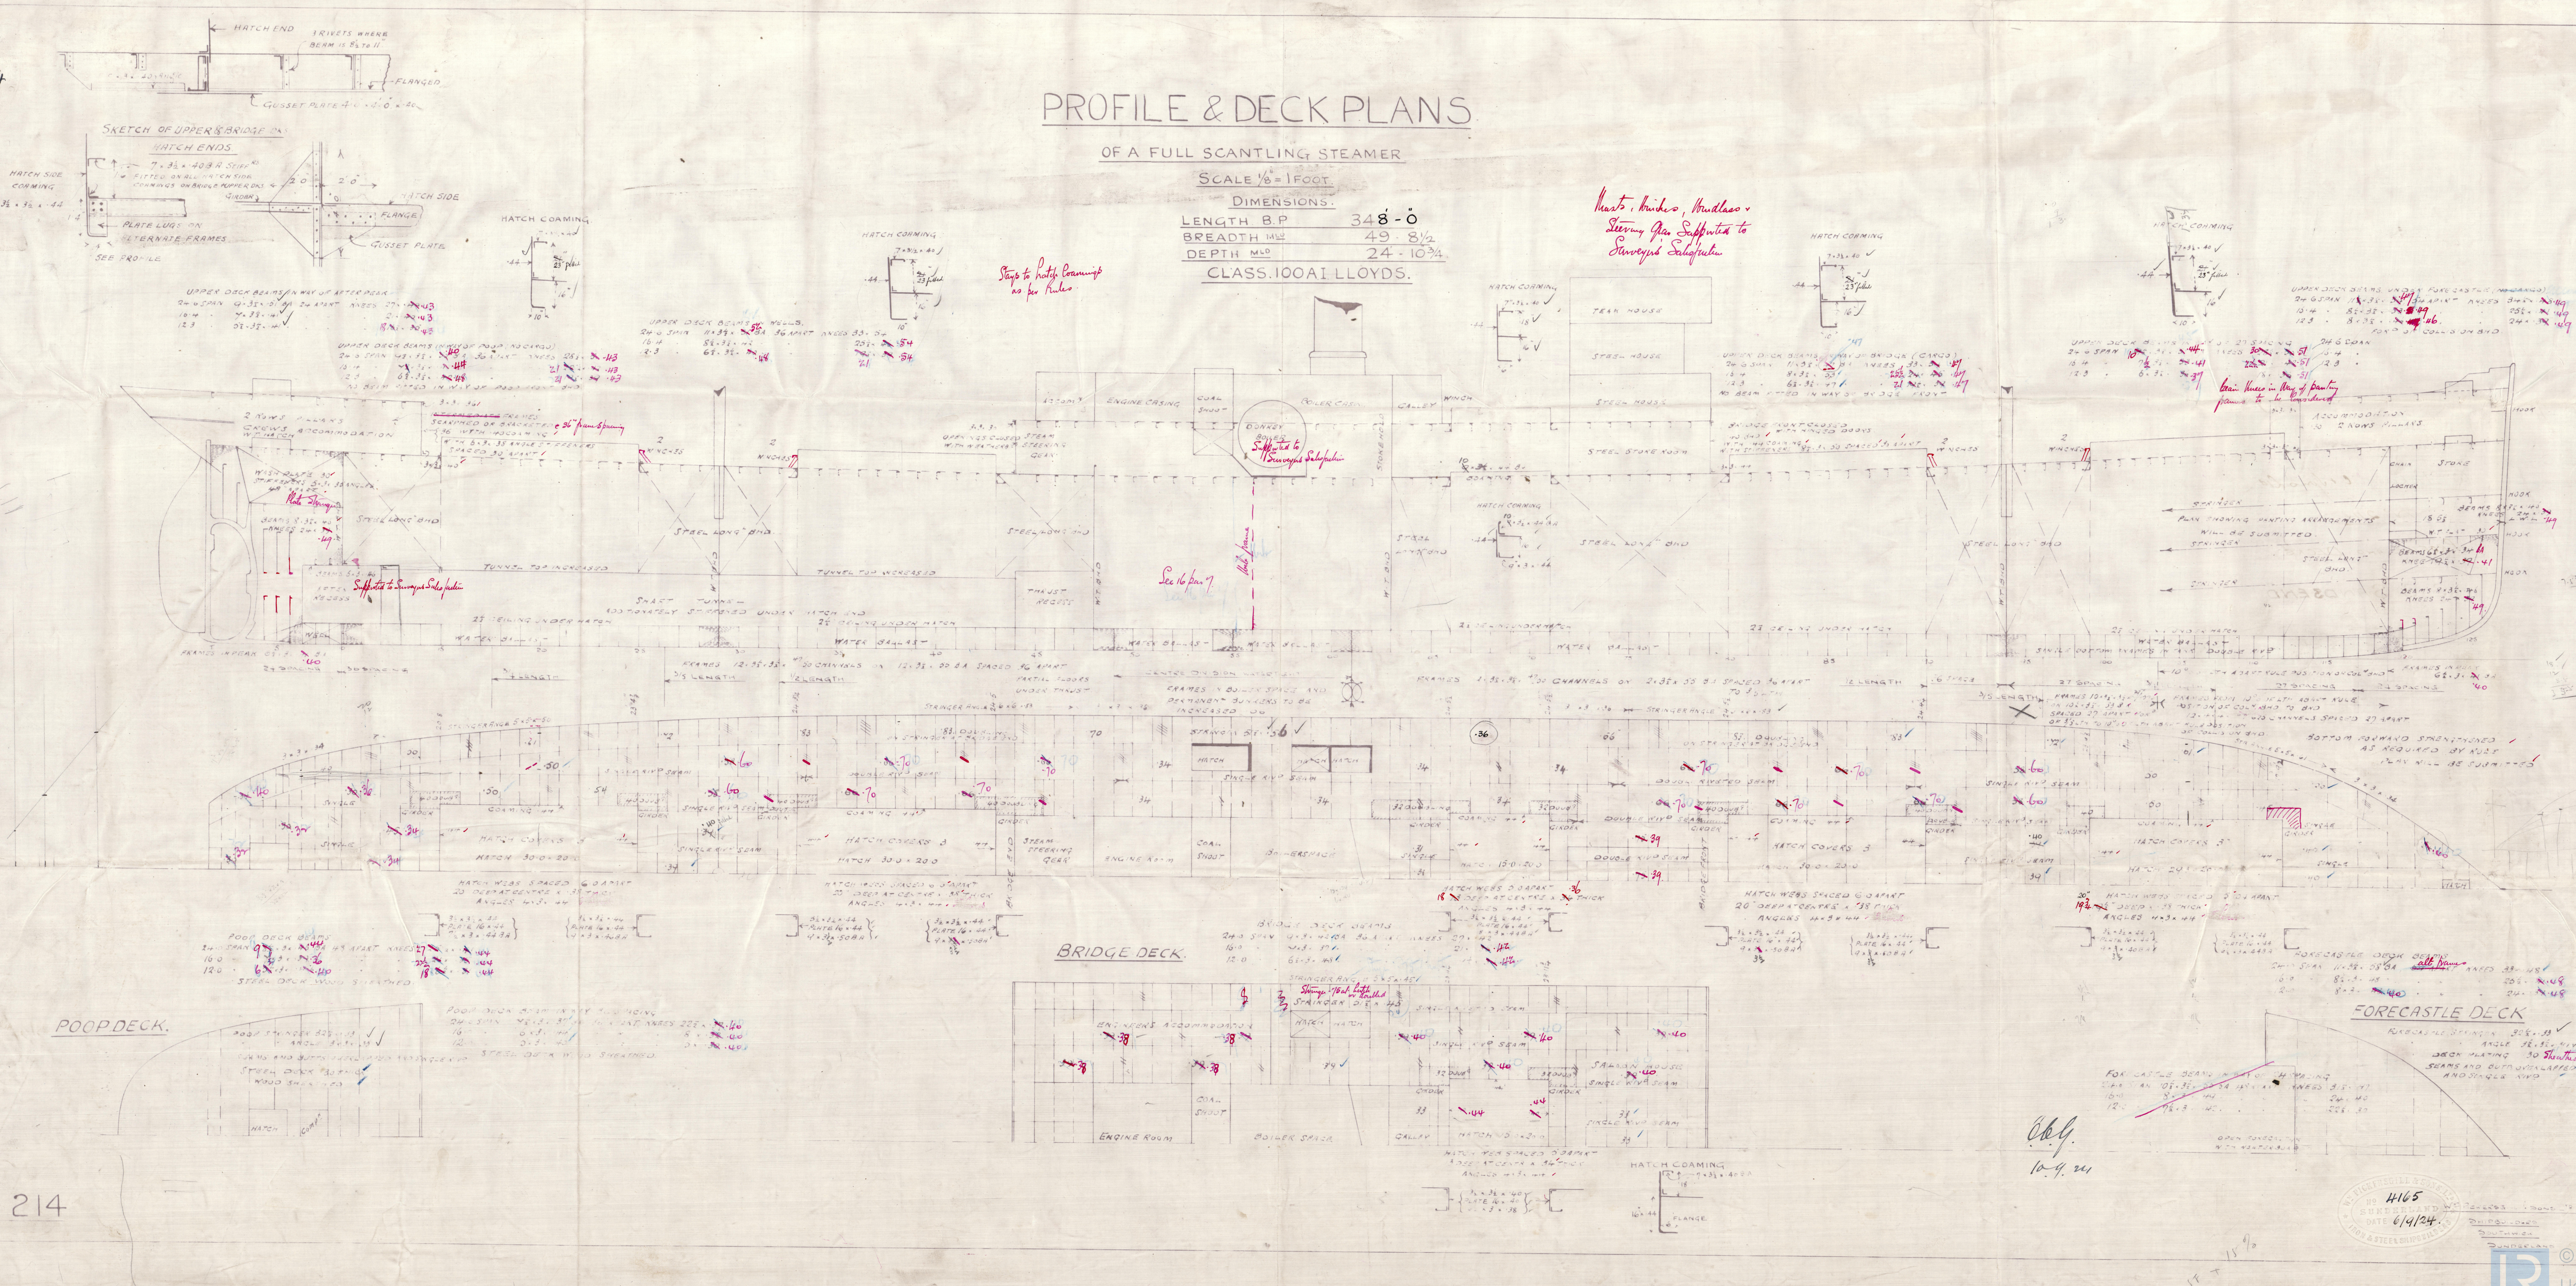

Nº 214

4165
DATE 6/4/24

(2)


Sunderland
Wm. Pickersgill & Sons Ltd

Nº 214

PROFILE AND DECKS

S S "SANDSEND"

SUNDERLAND RPT. NO. 29090.

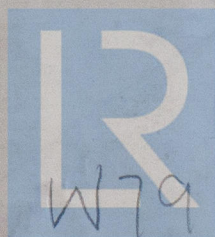

© 2020

Lloyd's Register
Foundation