

| LLOJOS NUMERALS | |
|----------------------|--------------|
| DEPTH | 24.30 ✓ |
| LENGTH | 347.41 ✓ |
| 1ST LONGITUDINAL NO. | 8650.51 ✓ |
| BREADTH | 49.70 ✓ |
| DEPTH | 24.30 ✓ |
| LENGTH | 347.41 ✓ |
| 2ND LONGITUDINAL NO. | 25316.79 ✓ |
| DEPTH TO LENGTH | 18.95° ✓ |
| — DO — | 10.55° ✓ |
| | UPPER DECK ✓ |
| | BRIDGE " ✓ |

OF A
FULL SCANTLING SCREW STEAMER

| DIMENSIONS | |
|-------------|-----------|
| LENGTH 8 P | 348.0 |
| BREADTH MLO | 49.8 1/2 |
| DEPTH MLO | 24.10 3/4 |

CLASS 100 A.I.


SCALE $\frac{1}{2}'' = 1 \text{ FOOT.}$

ANCHORS & CABLES

| | | | | | |
|---------------------------------|------------------|------------------|------------|--------|--------|
| 270 | LONGITUDINAL | N ^o - | 259.8 | 76 ✓ | |
| POOP BRIDGE & FLEE | 175 | 78.8 | 75 ✓ | 104.2 | 6 ✓ |
| DECKHOUSE | 175 | 21.2 | 7.8 | 79 | 75 ✓ |
| CAS 44 | 175 | 21.2 | 7.8 | 241.8 | 87 ✓ |
| EQUIPMENT N ^o - | - | - | - | 272.71 | 24 ✓ |
| 1 ST BOWER STOCKLESS | - | - | - | 272.83 | 87 ✓ |
| 240 | - | - | - | 48.4 | LYTS ✓ |
| 320 | - | - | - | 48.2 | ✓ |
| 9 STREAM EX STOCKLESS | - | - | - | 41 | ✓ |
| 270 FATHOMS STD CHAIN CABLE | - | - | - | 13 | ✓ |
| 90 | - | - | - | 2 | ✓ |
| 1 | STREAM CHAIN 1/8 | OR 1/2 | STEEL WIRE | - | - |

HAWSERS & WARPS

| | | | |
|-------------|---------|----------|---------------|
| 120 FATHOMS | TOWLINE | 12" HEMP | 4" STEEL WIRE |
| 2-90 " | HAWERS | 7" " | 2½" ✓ |
| 2-90 " | WARDS | 7" " | 2½" ✓ |

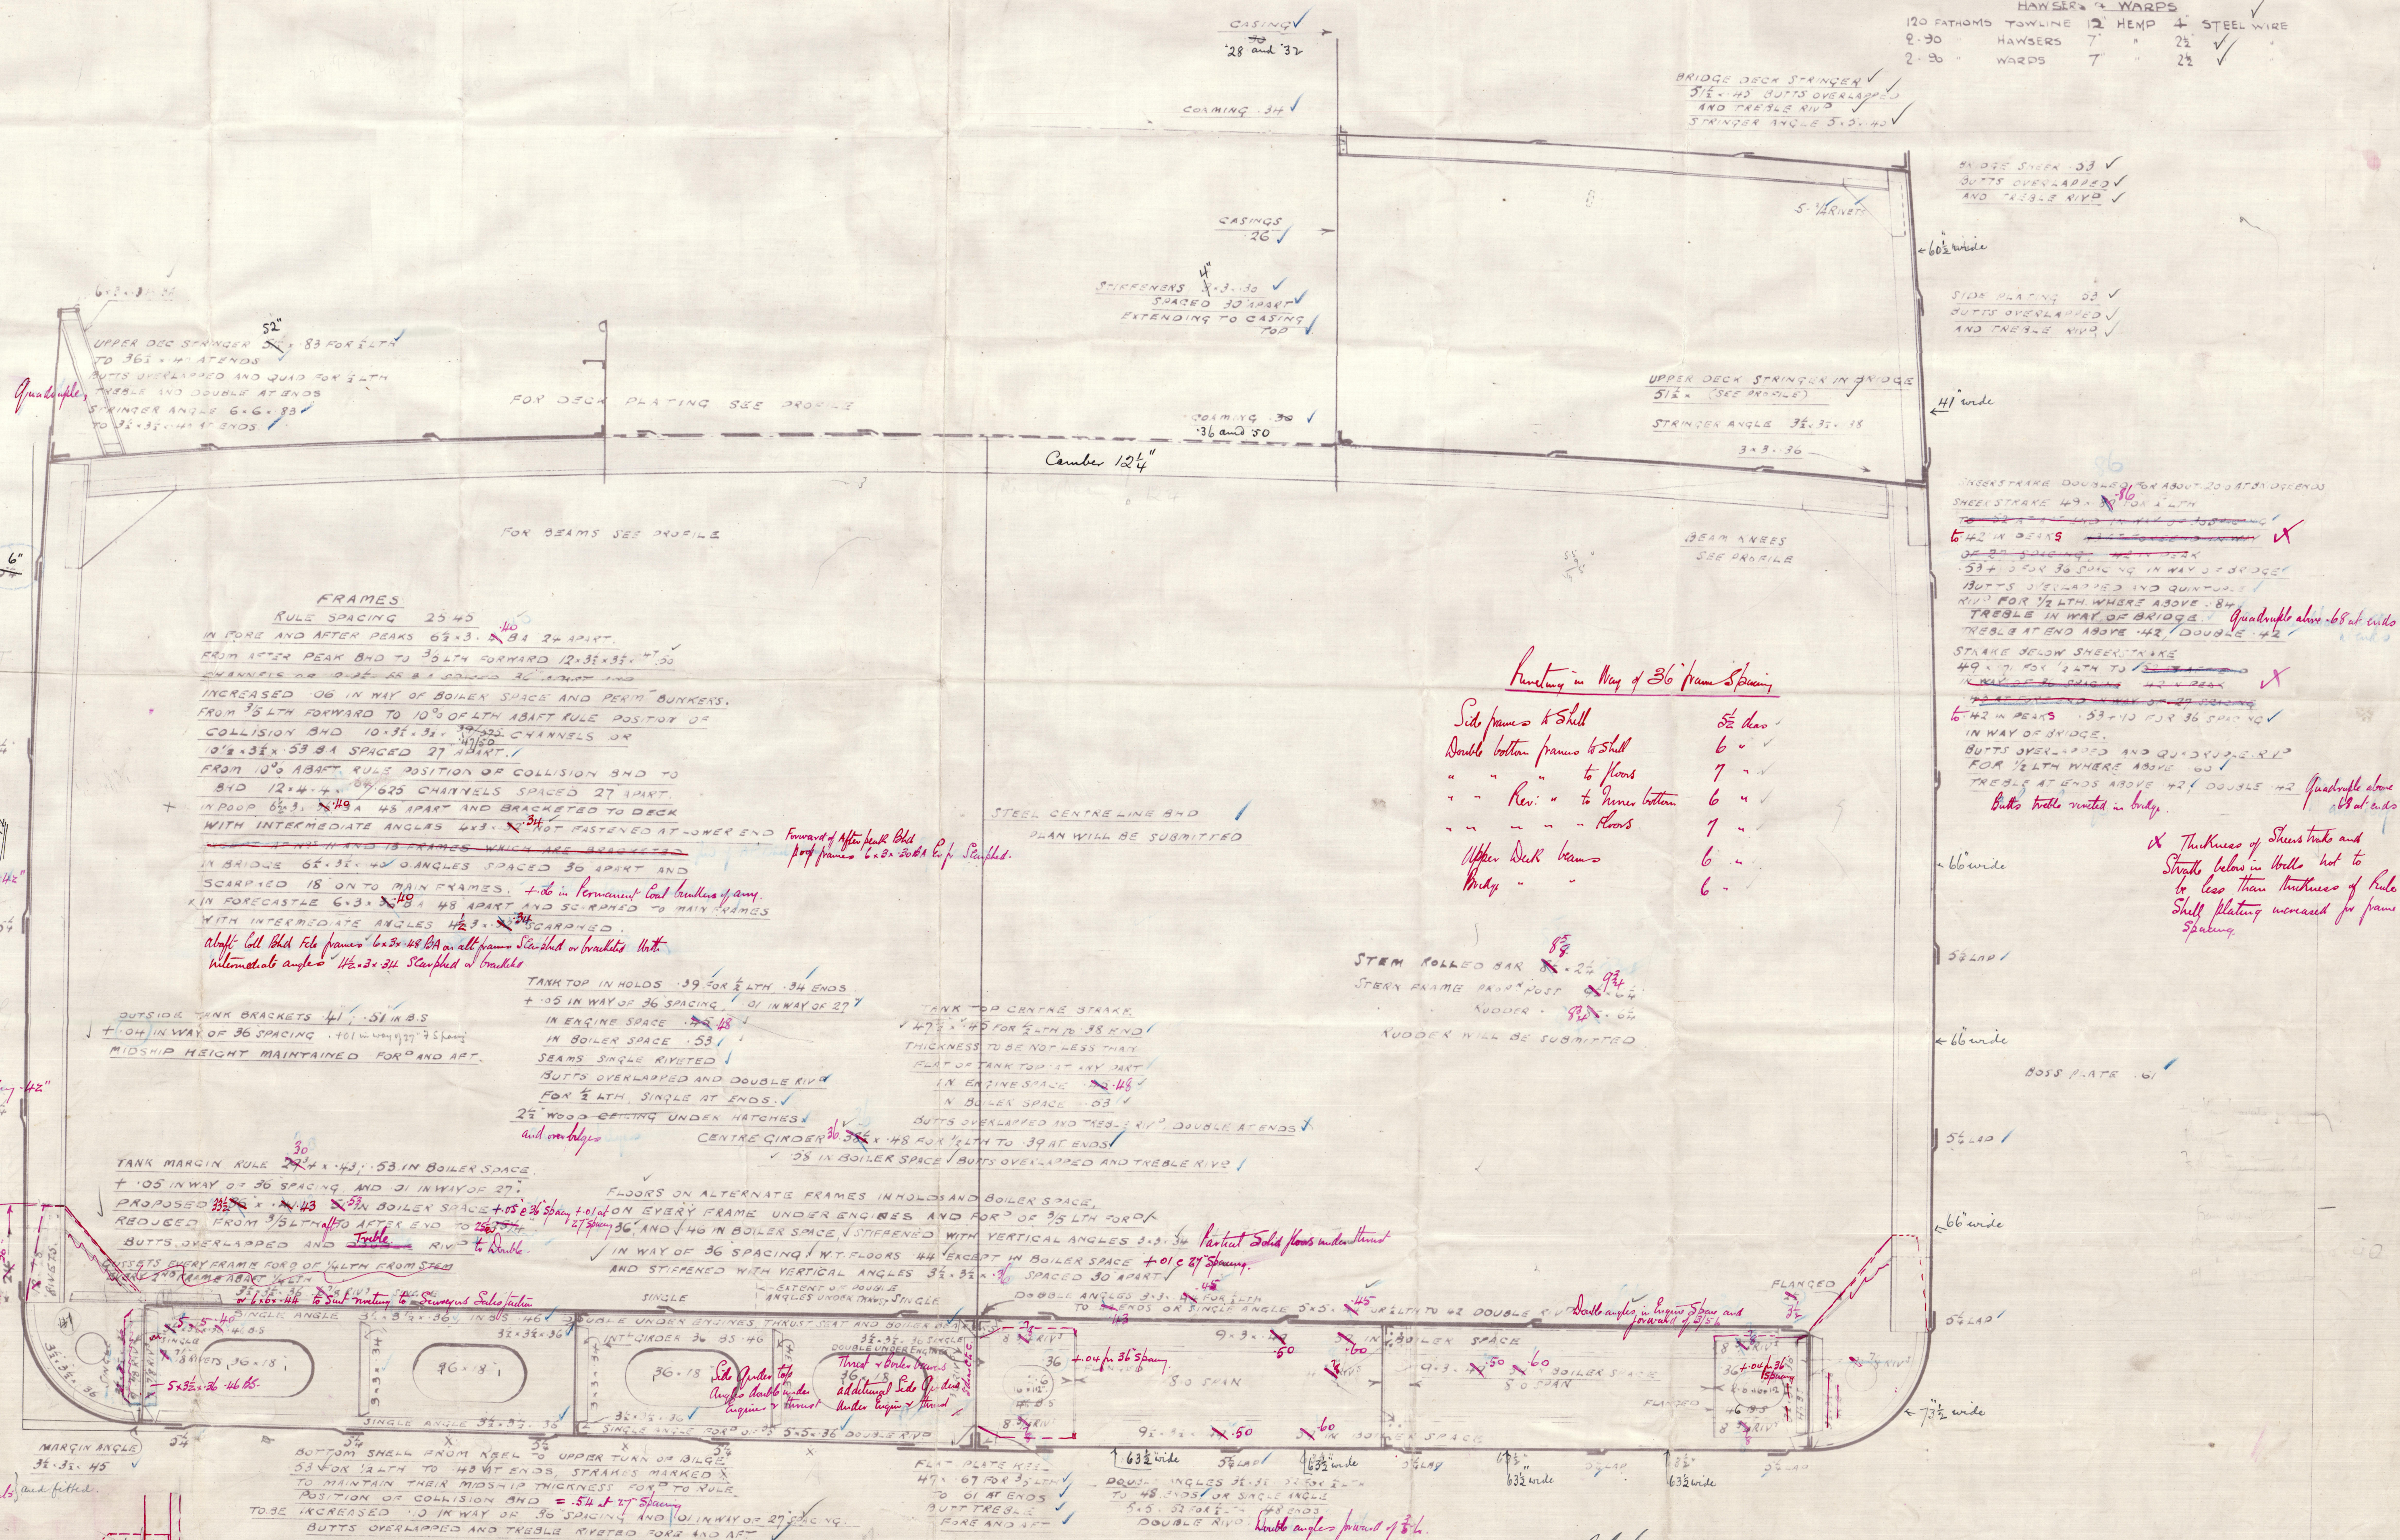

Nº 214

W. W. PICKERSGILL & SONS LTD.
NO 4166
SUNDERLAND
DATE 6/9/24.

WM. PICKERSGILL & SONS LTD
SHIPBUILDERS
SOUTHWICK
SUNDERLAND

© 2020
Lloyd's Register
Foundation

①

Sunderland

Wm Pickersill & Sons Ltd

S S N^o 214

MIDSHIP SECTION

S.S. "SANDSEND"

SUNDERLAND RPT. NO. 29090



© 2020

W79-0184

Lloyd's Register
Foundation