


<u>DIMENSIONS.</u>	
<u>LENGTH B.P.</u>	348' 0"
<u>BREADTH MLD</u>	49' 8 1/2"
<u>DEPTH MLD</u>	24' 10 3/4"
<u>CLASS 100A I LLOYDS.</u>	

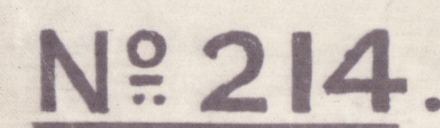



Sunderland

(2a)

10<sup>m</sup> Pickersgill Sons Ltd


N<sup>o</sup> 214.

S. S. 'SANDSEND'

PROFILE AND DECKS.

(AS BUILT)

SUNDERLAND DPT. NO. 29090.

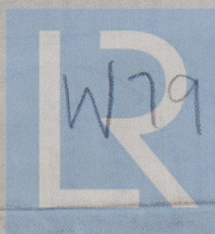

© 2020

W79-0185

Lloyd's Register  
Foundation