



8.10.09


PLAN No. 8849.
FOR ENCLOSURE TO
Messrs. Lloyd's Surveyors
Hull FROM
COCHRANE & SONS,
SHIPBUILDERS, SELBY
DATE 4/10/09. *R.H.*

Nº 458 MIDSHIP SECTION

STEEL SCREW TRAWLER

DIM^{NS}:- 135'-0" B.P. x 24'-0" EX x 13'-2" M^{LD}
SCALE 1/2" = 1 FOOT

TO CLASS 100. A.I. STEAM TRAWLER
ENGINE & BOILER CASING AS PREVIOUSLY APPROVED
DECK PLATED OVER IN WAY OF MACHINERY SPACE

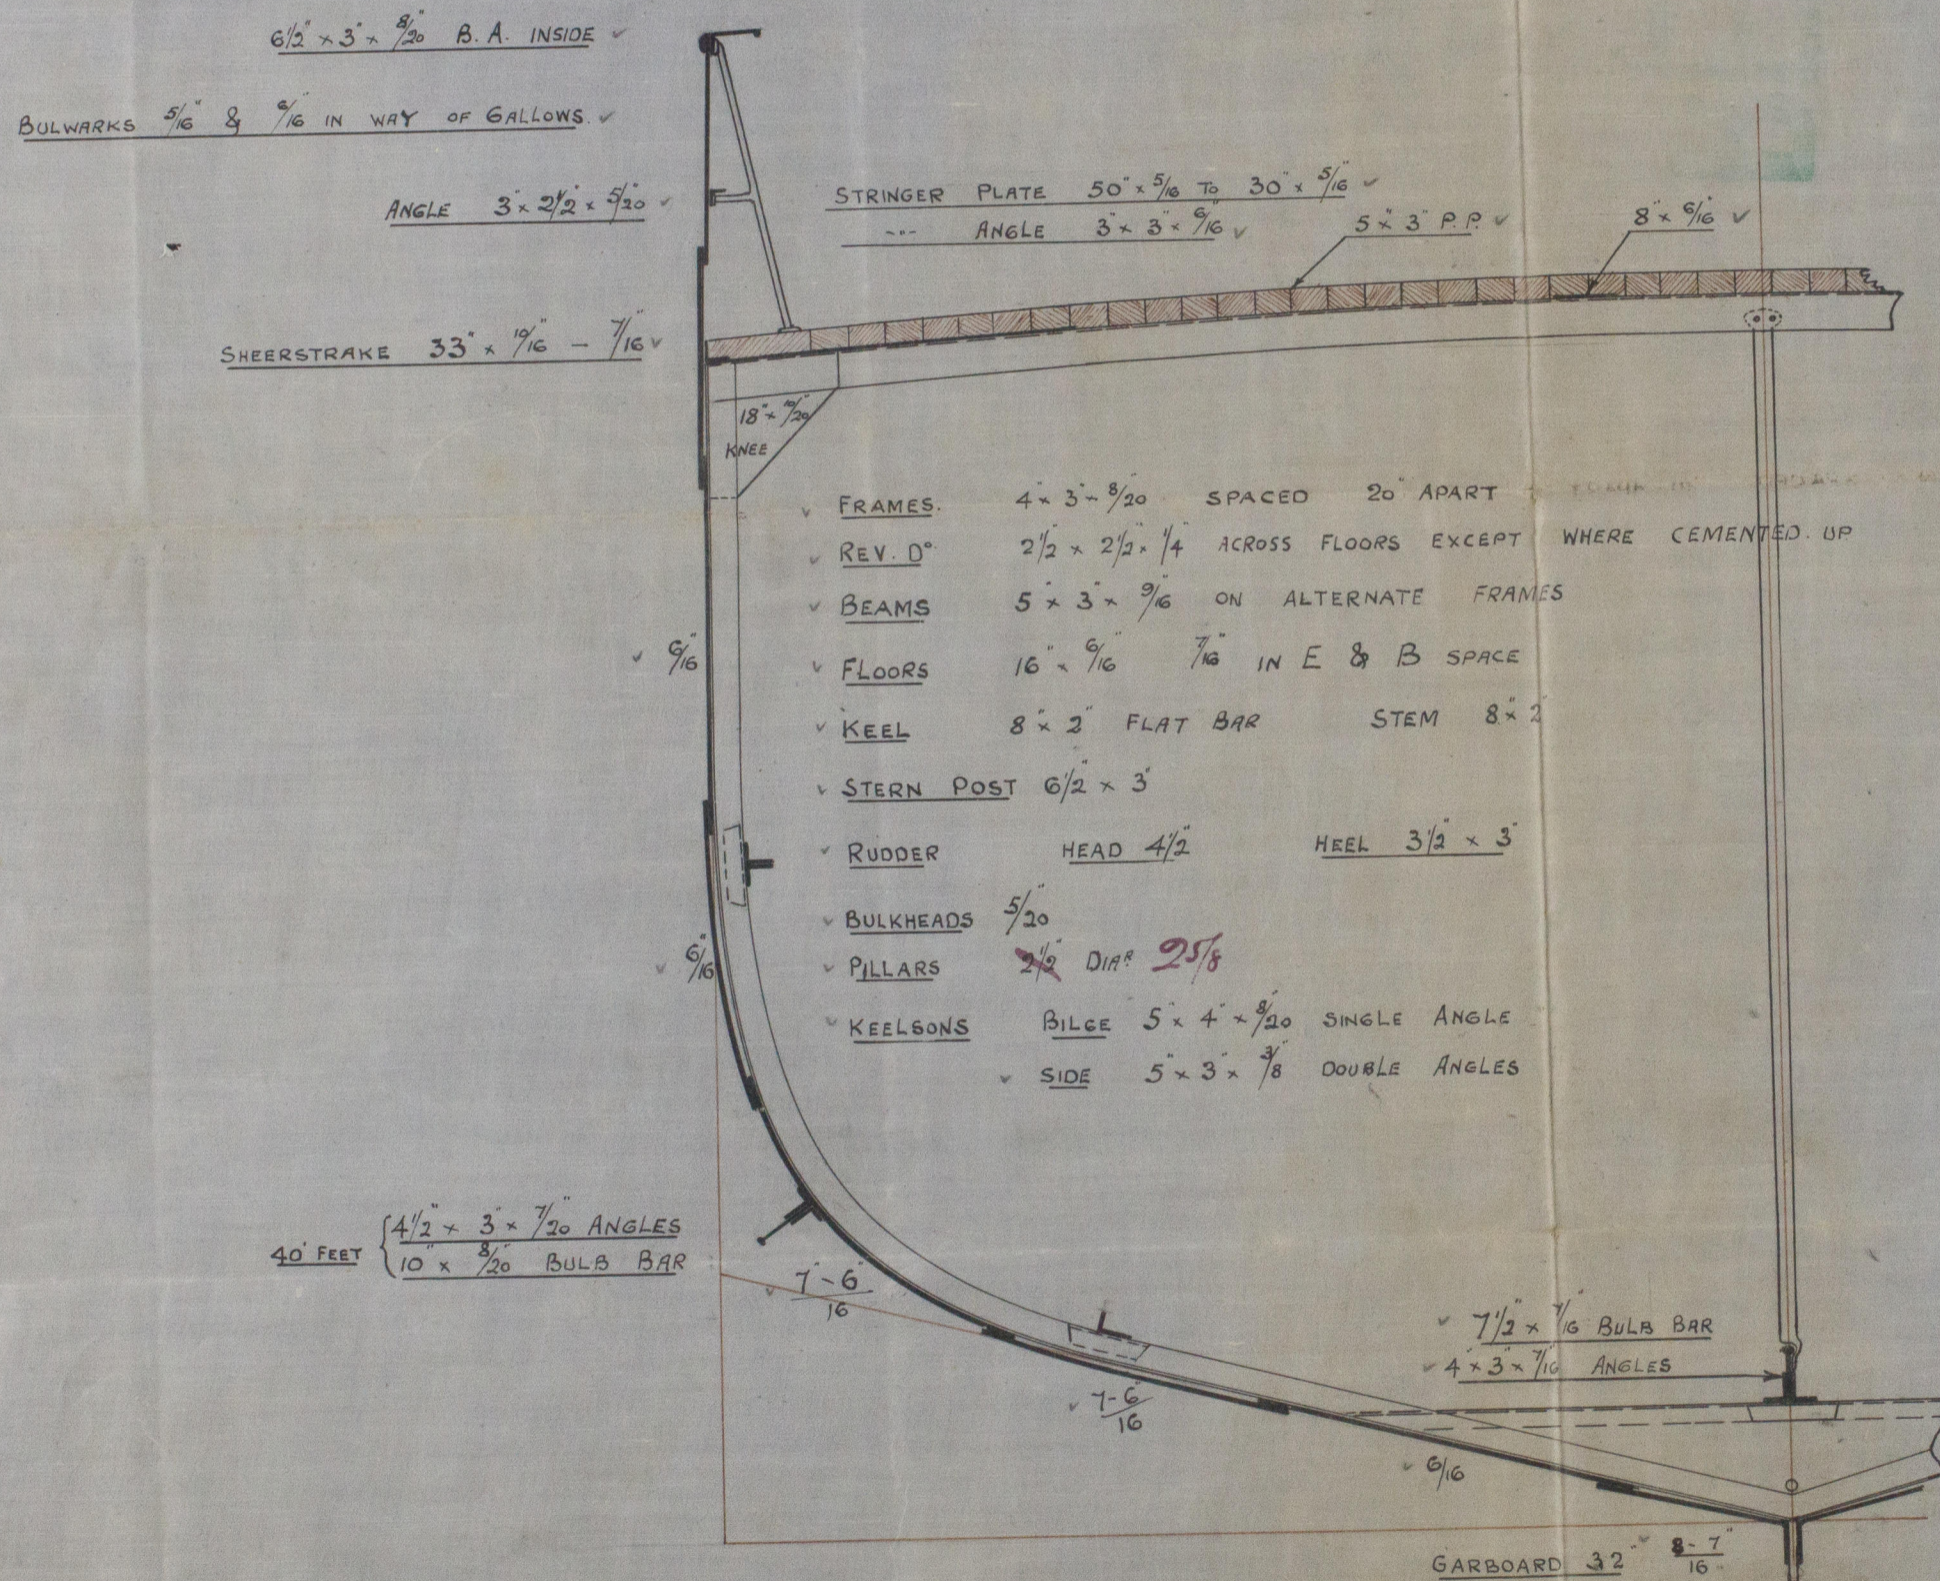

LLOYDS NUMERALS

1/2 GIRTH	✓ 21.25
1/2 BREADTH	✓ 11.93
DEPTH	✓ 13.66
	✓ 46.84 1 ST N ^O
LENGTH AS PER RULE	✓ 133.79
	✓ 6266.72 2 ND N ^O

PROPORTIONS

L/D	= 3.7 ✓
B	= 5.6 ✓

EQUIPMENT.

1 ST BOWER ANCHOR	6 1/4 CWTs EX STOCK
2 ND " "	5 3/4 " " "
3 RD " "	3 1/4 " " "
120 FATHOMS	1 1/16 CABLE
60 " "	6" HAWSER
60 " "	5" WARP

RIVETING

- BUTTS OF SHELL PLATING LAPPED & DOUBLE RIVETED, EXCEPT
- GARBOARD & SHEERSTRAKES WHICH ARE TO BE STRAPPED.
- LANDINGS DOUBLE RIVETED. BULWARKS SINGLE RIVETED. BUTTS OF
- STRINGER & TIE PLATES OVERLAPPED & DOUBLE RIVETED.

C.F.
8/10/09.


LODD'S REGISTER
OF SHIPPING.
5 - OCT 1909
HULL

Cochrane & Sons.
No 458.
Midship Section.

s/s Lois
Hull Report No 22204



11.03
31.32

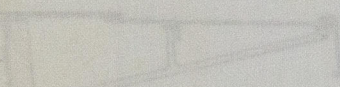




SHIP SECTION
No 458

© 2021

Lloyd's Register
Foundation

W792-0008