

8.10.09



PROFILE & DECK PLAN  
N<sup>o</sup> 458

DIM. 135'0" x 26'0" x 13'2" MLD

Scale 1/4" = 1 foot

PLAN No. 8832  
FOR ENCLOSURE TO  
Messrs. Messrs. Messrs.  
Hall FROM  
COCHRANE & SONS,  
SHIPBUILDERS, SELEBY  
DATE 4/10/19. R.R.

NOTE: PILLARS THROUGHOUT TO SURVEYORS SATISFACTION.

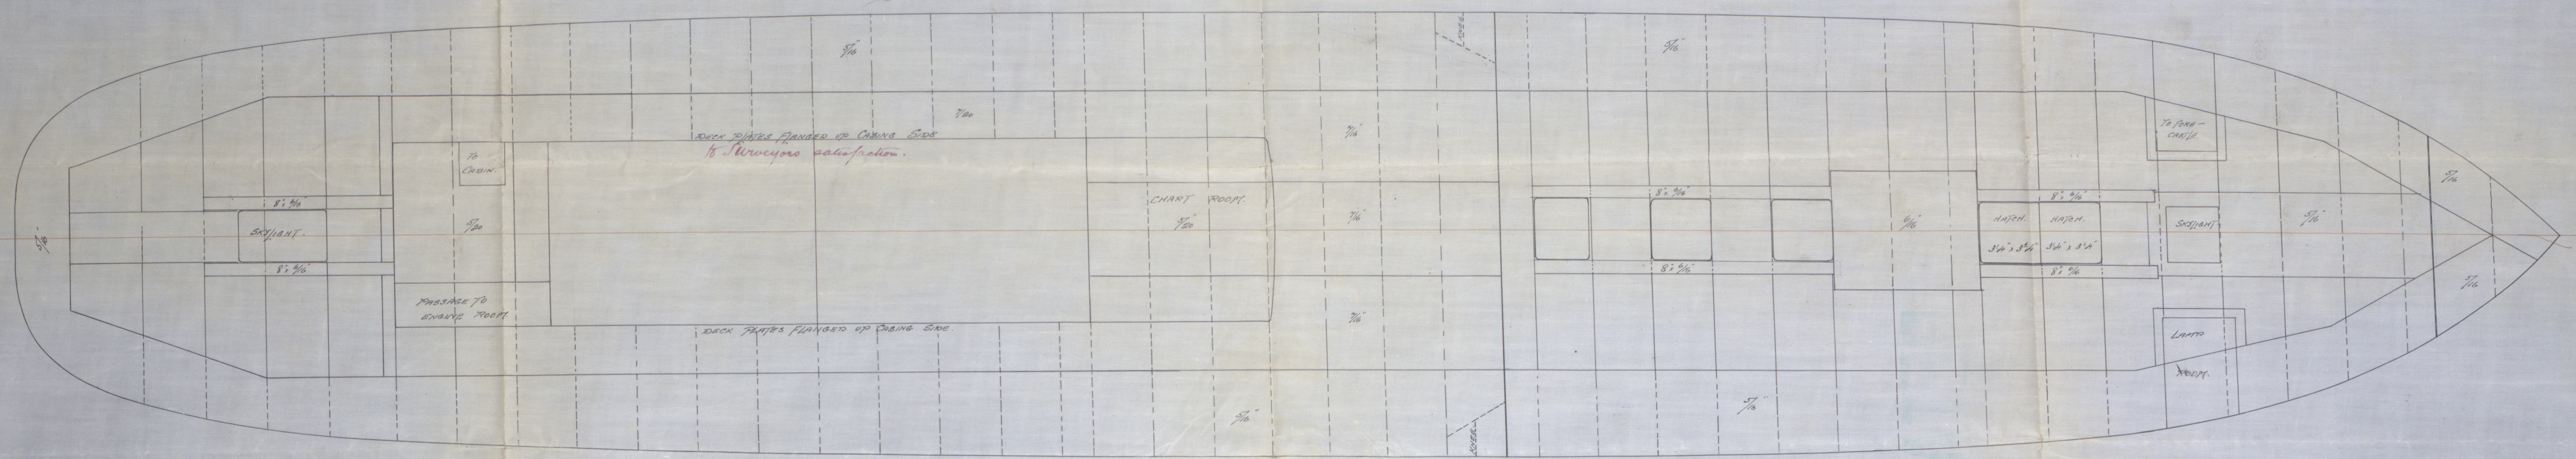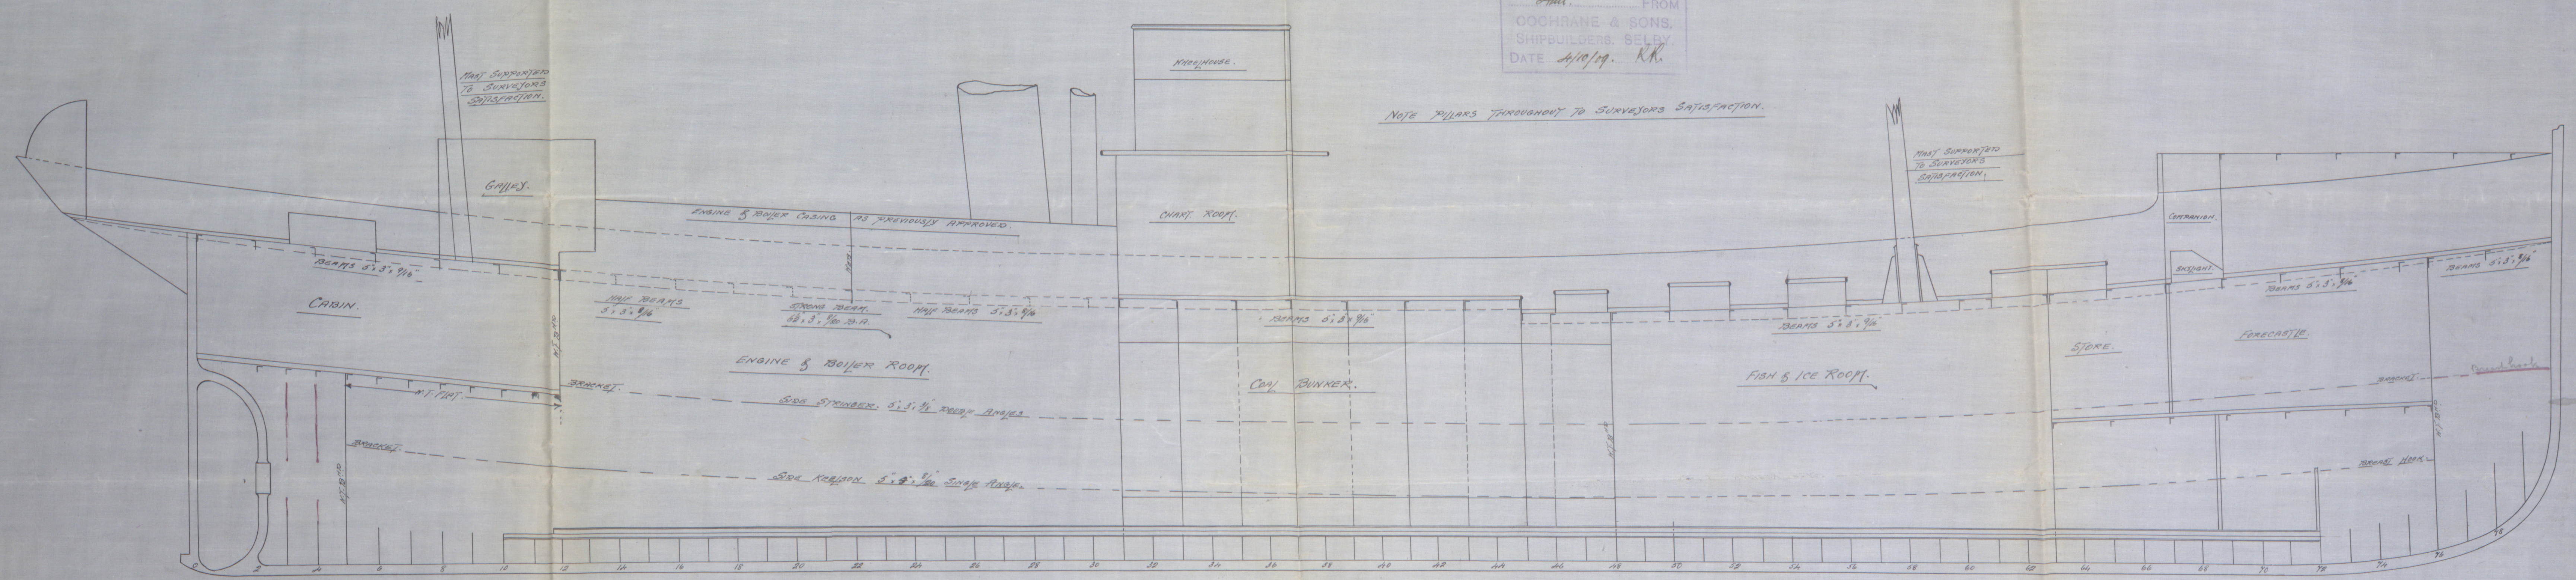


PLAN 3 REGISTERED  
OF SHIPPING.  
6 - OCT 1909

C.T.  
8/11/09

135'0" x 26'0" x 13'2" MLD  
Cochrane & Sons  
Shipbuilders, Seleby



Cochrane & Sons.  
No. 458.  
Profile of Decks.  
s/s 'Lois'  
Hull Report No. 22204

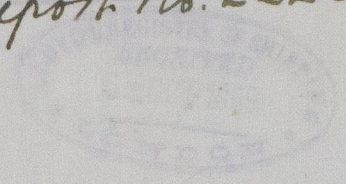

69 10 29



RETAIN



© 2021

Lloyd's Register  
Foundation