



From AMOS & SMITH, Ltd., HULL.

Enclosure for

*Messrs*

*Lloyds Surveyors*


*Hull*

W792-0060 (1/3)

eps Lois  
Hull Report. No. 22204  
Amos & Smith. Boiler  
No 1722  
for  
Cochrane, Lons No 458

W.P. = 180 lbs.

Amended plan 14.10.09.

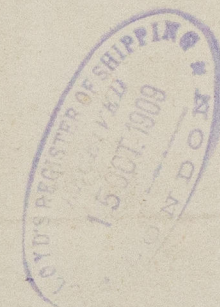

W792-0060 (2/3)

From AMOS & SMITH, Ltd., HULL

Enclosure for

Messrs Lloyds Surveyors.

RETAIN



© 2021

Lloyd's Register  
Foundation

W792-0060 (3/3)