


S.S. N° 407

LENGTH B.P. --- 360'-0"
BREADTH M^{LD} --- 50'-0"
DEPTH " --- 27'-6"

SCALE $\frac{1}{8}" = 1 \text{ FOOT.}$

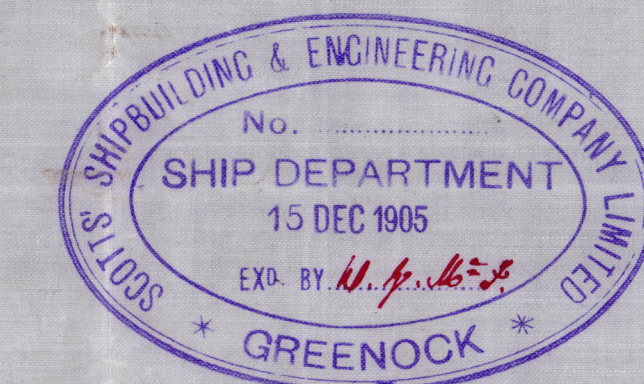

C.B.
21.12.85-

W795-0043

Amended Profile Plan
Scotts' Bl. & Eng. Co.
No. 1407.

L. S. Bardistan
Greenock 4p. No. 14906



© 2021

Lloyd's Register
Foundation