
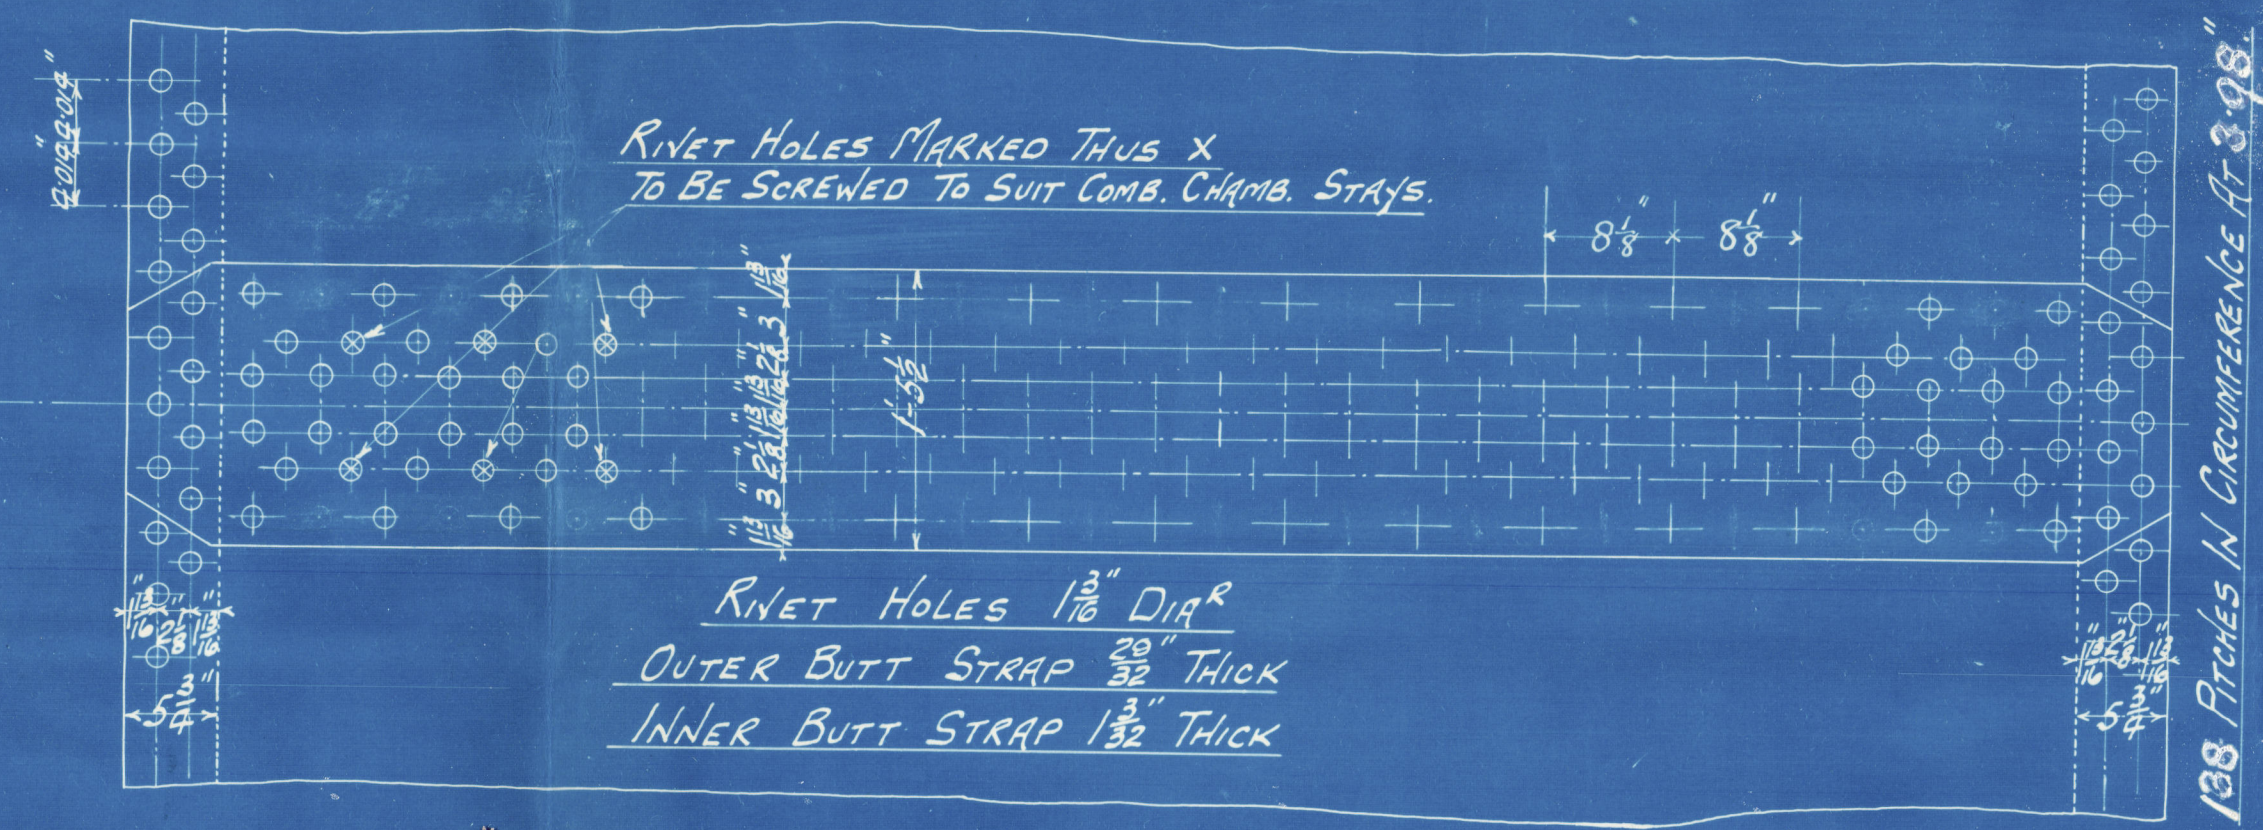





18.11.05.

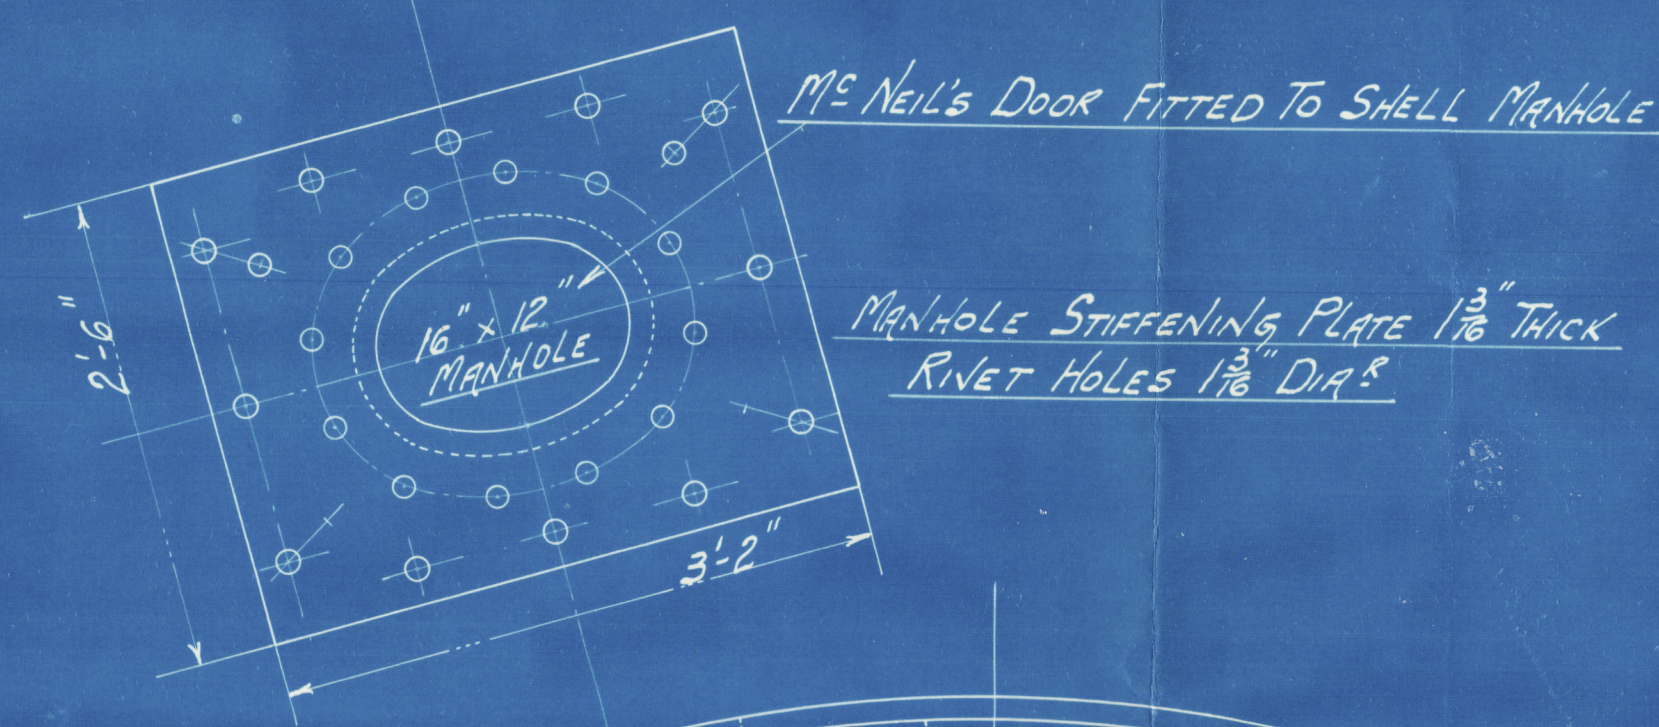


411 TUBES 2 1/2" EXT. DIA. 7'-10" LONG OVER PLATES	=	2106 #.
FURNACES	=	156 #.
FIREBOXES	=	258 #.
TOTAL HEATING SURFACE	=	2520 #.
GRATE AREA (5-3 BARS)	=	35 #.

WORKING PRESSURE 180 LBS LLOYDS.

TENSILE STRENGTH OF SHELL PLATES 28 TO 32 TONS PER SQ IN											
"	"	"	OTHER	"	26	"	30	"	"	"	"
"	"	"	LONGITUDINAL STAYS	"	27	"	32	"	"	"	"
"	"	"	SCREWED	"	26	"	30	"	"	"	"

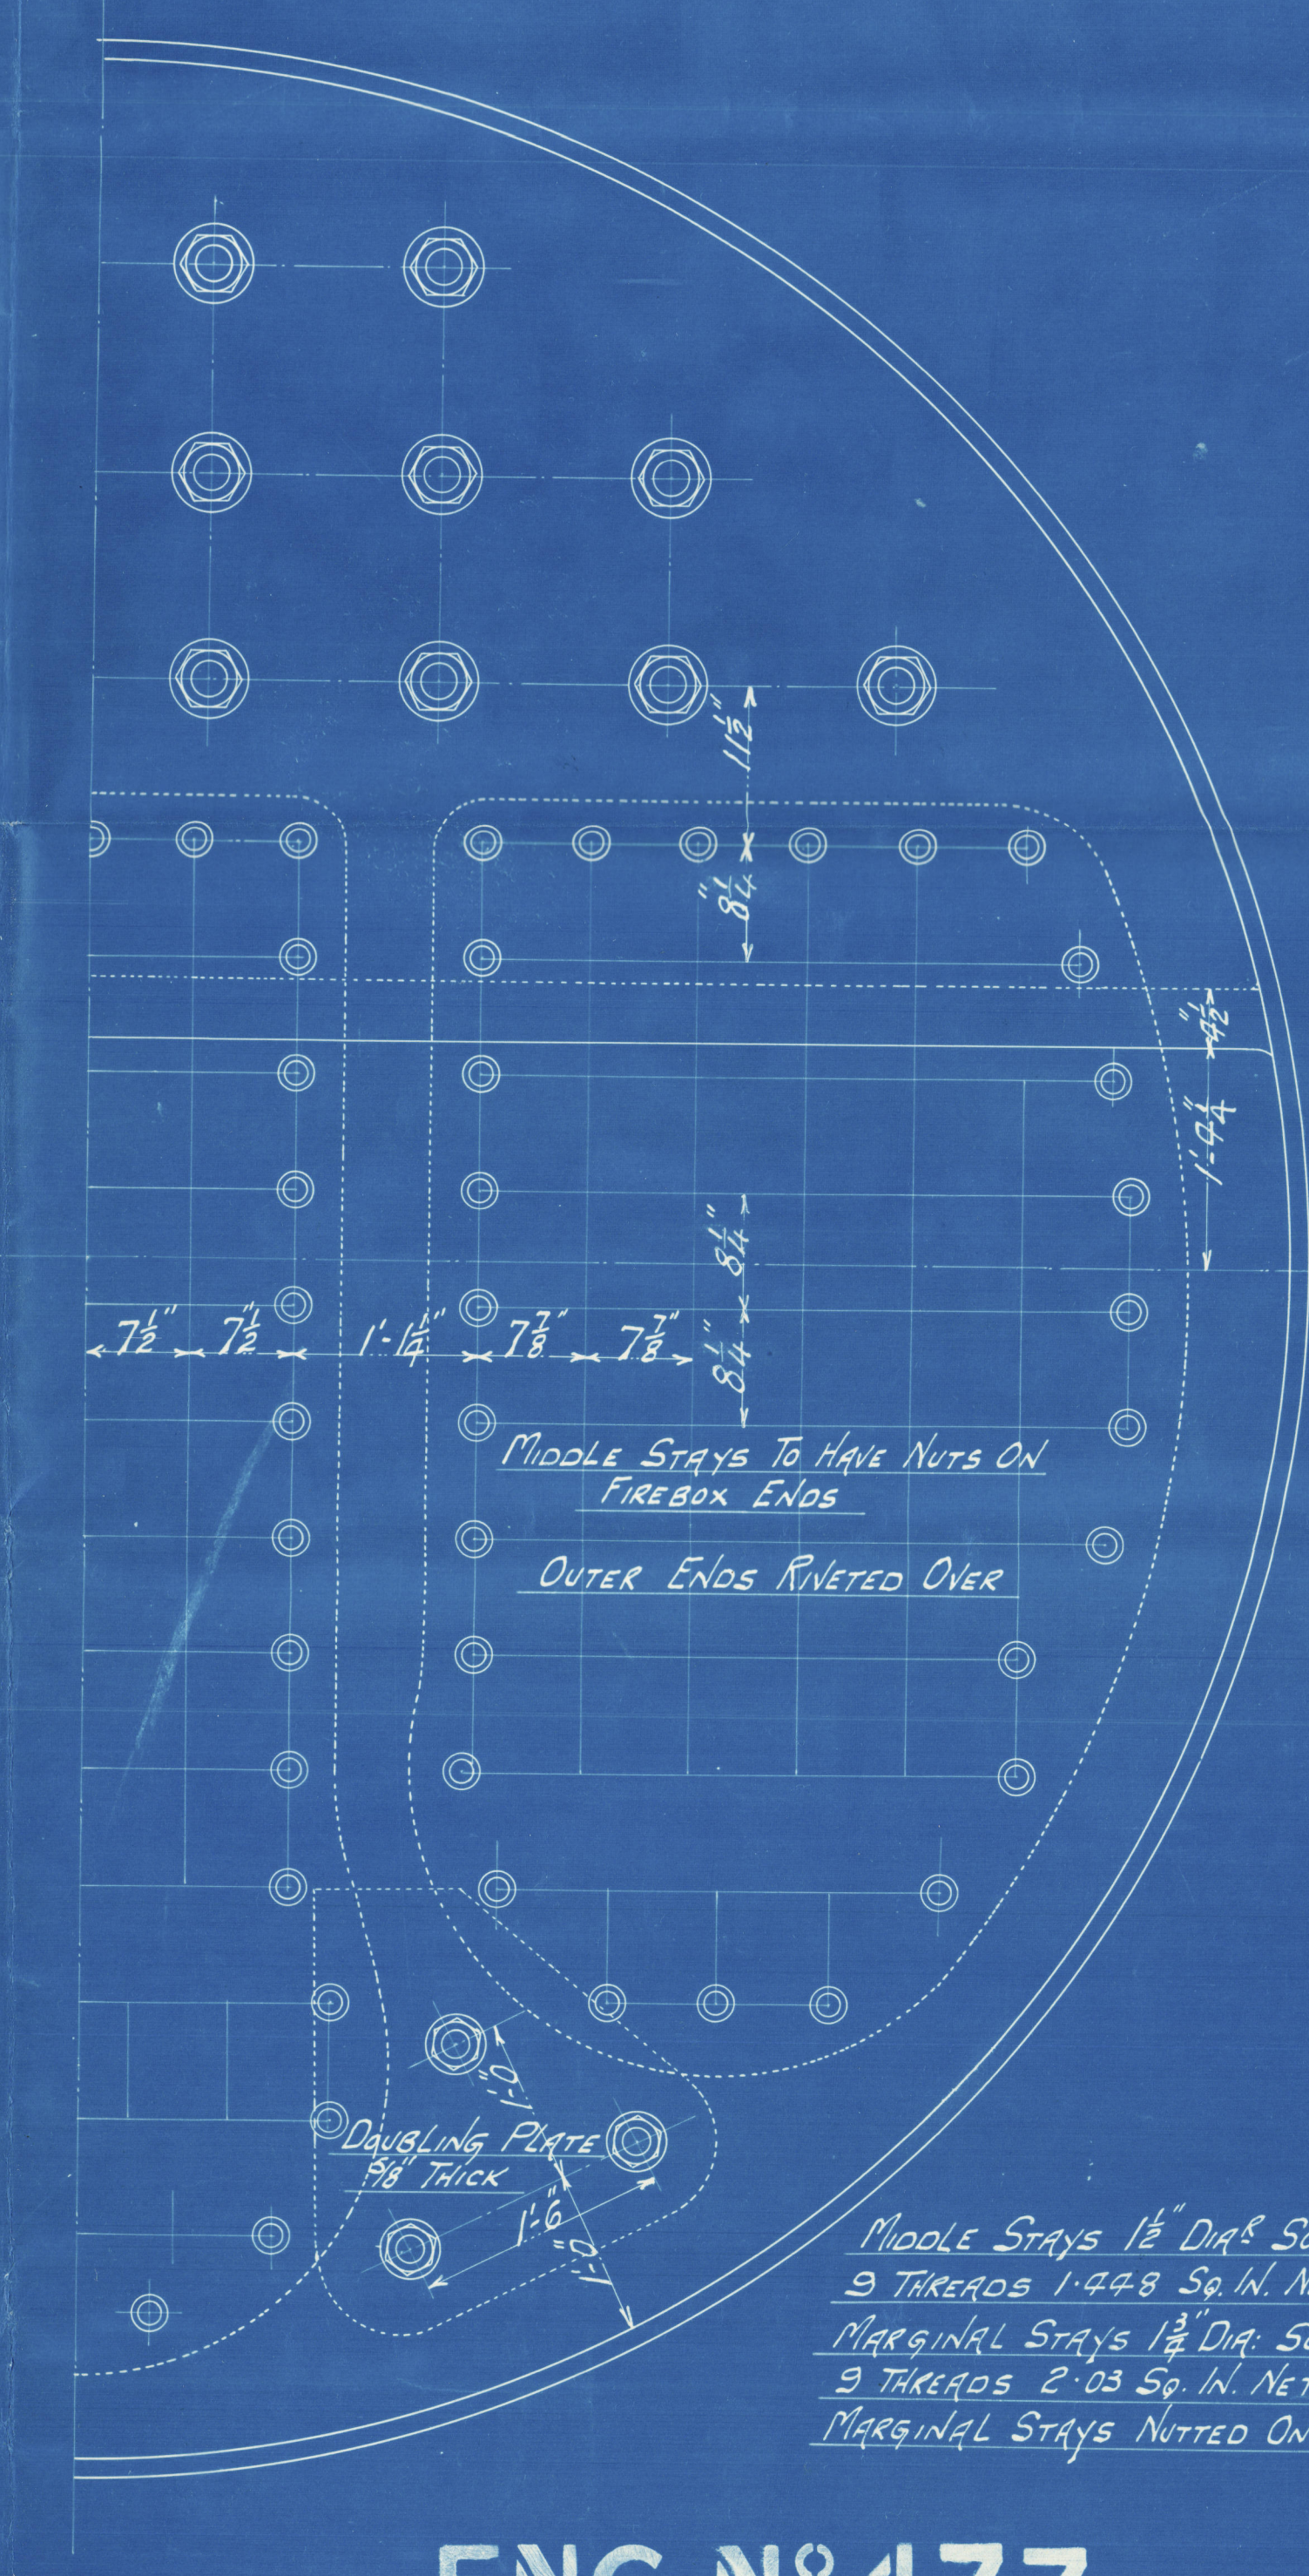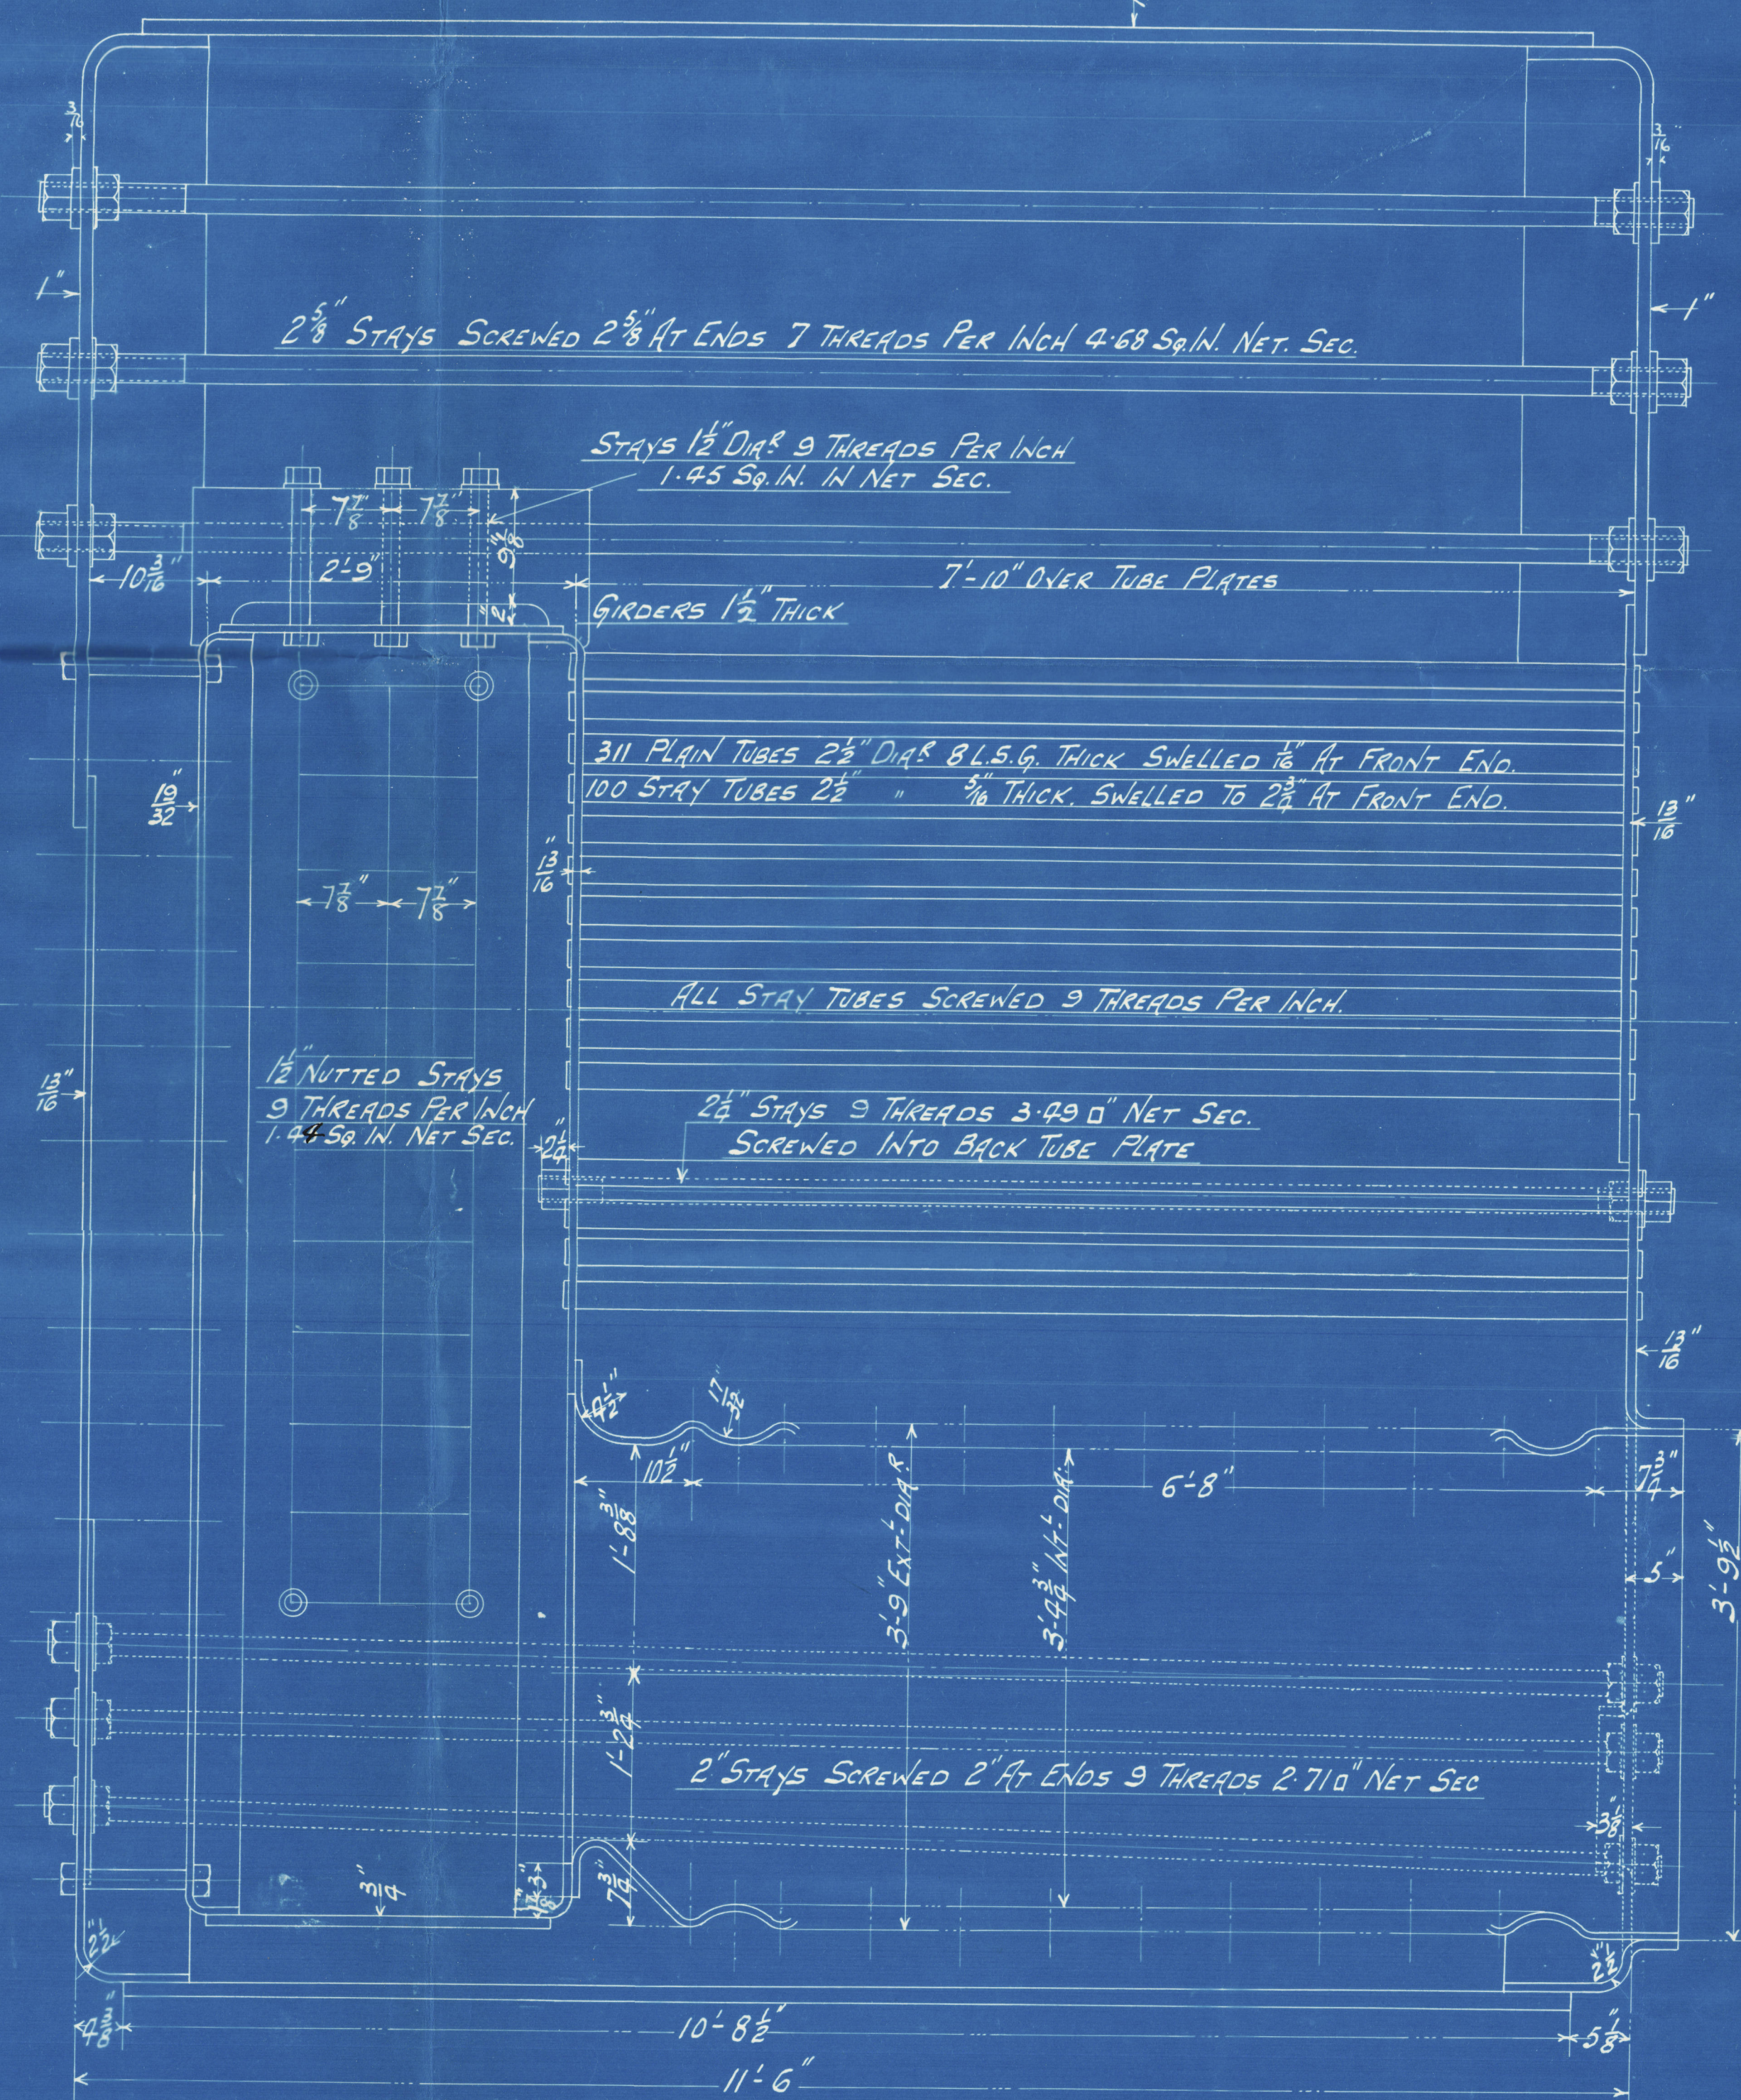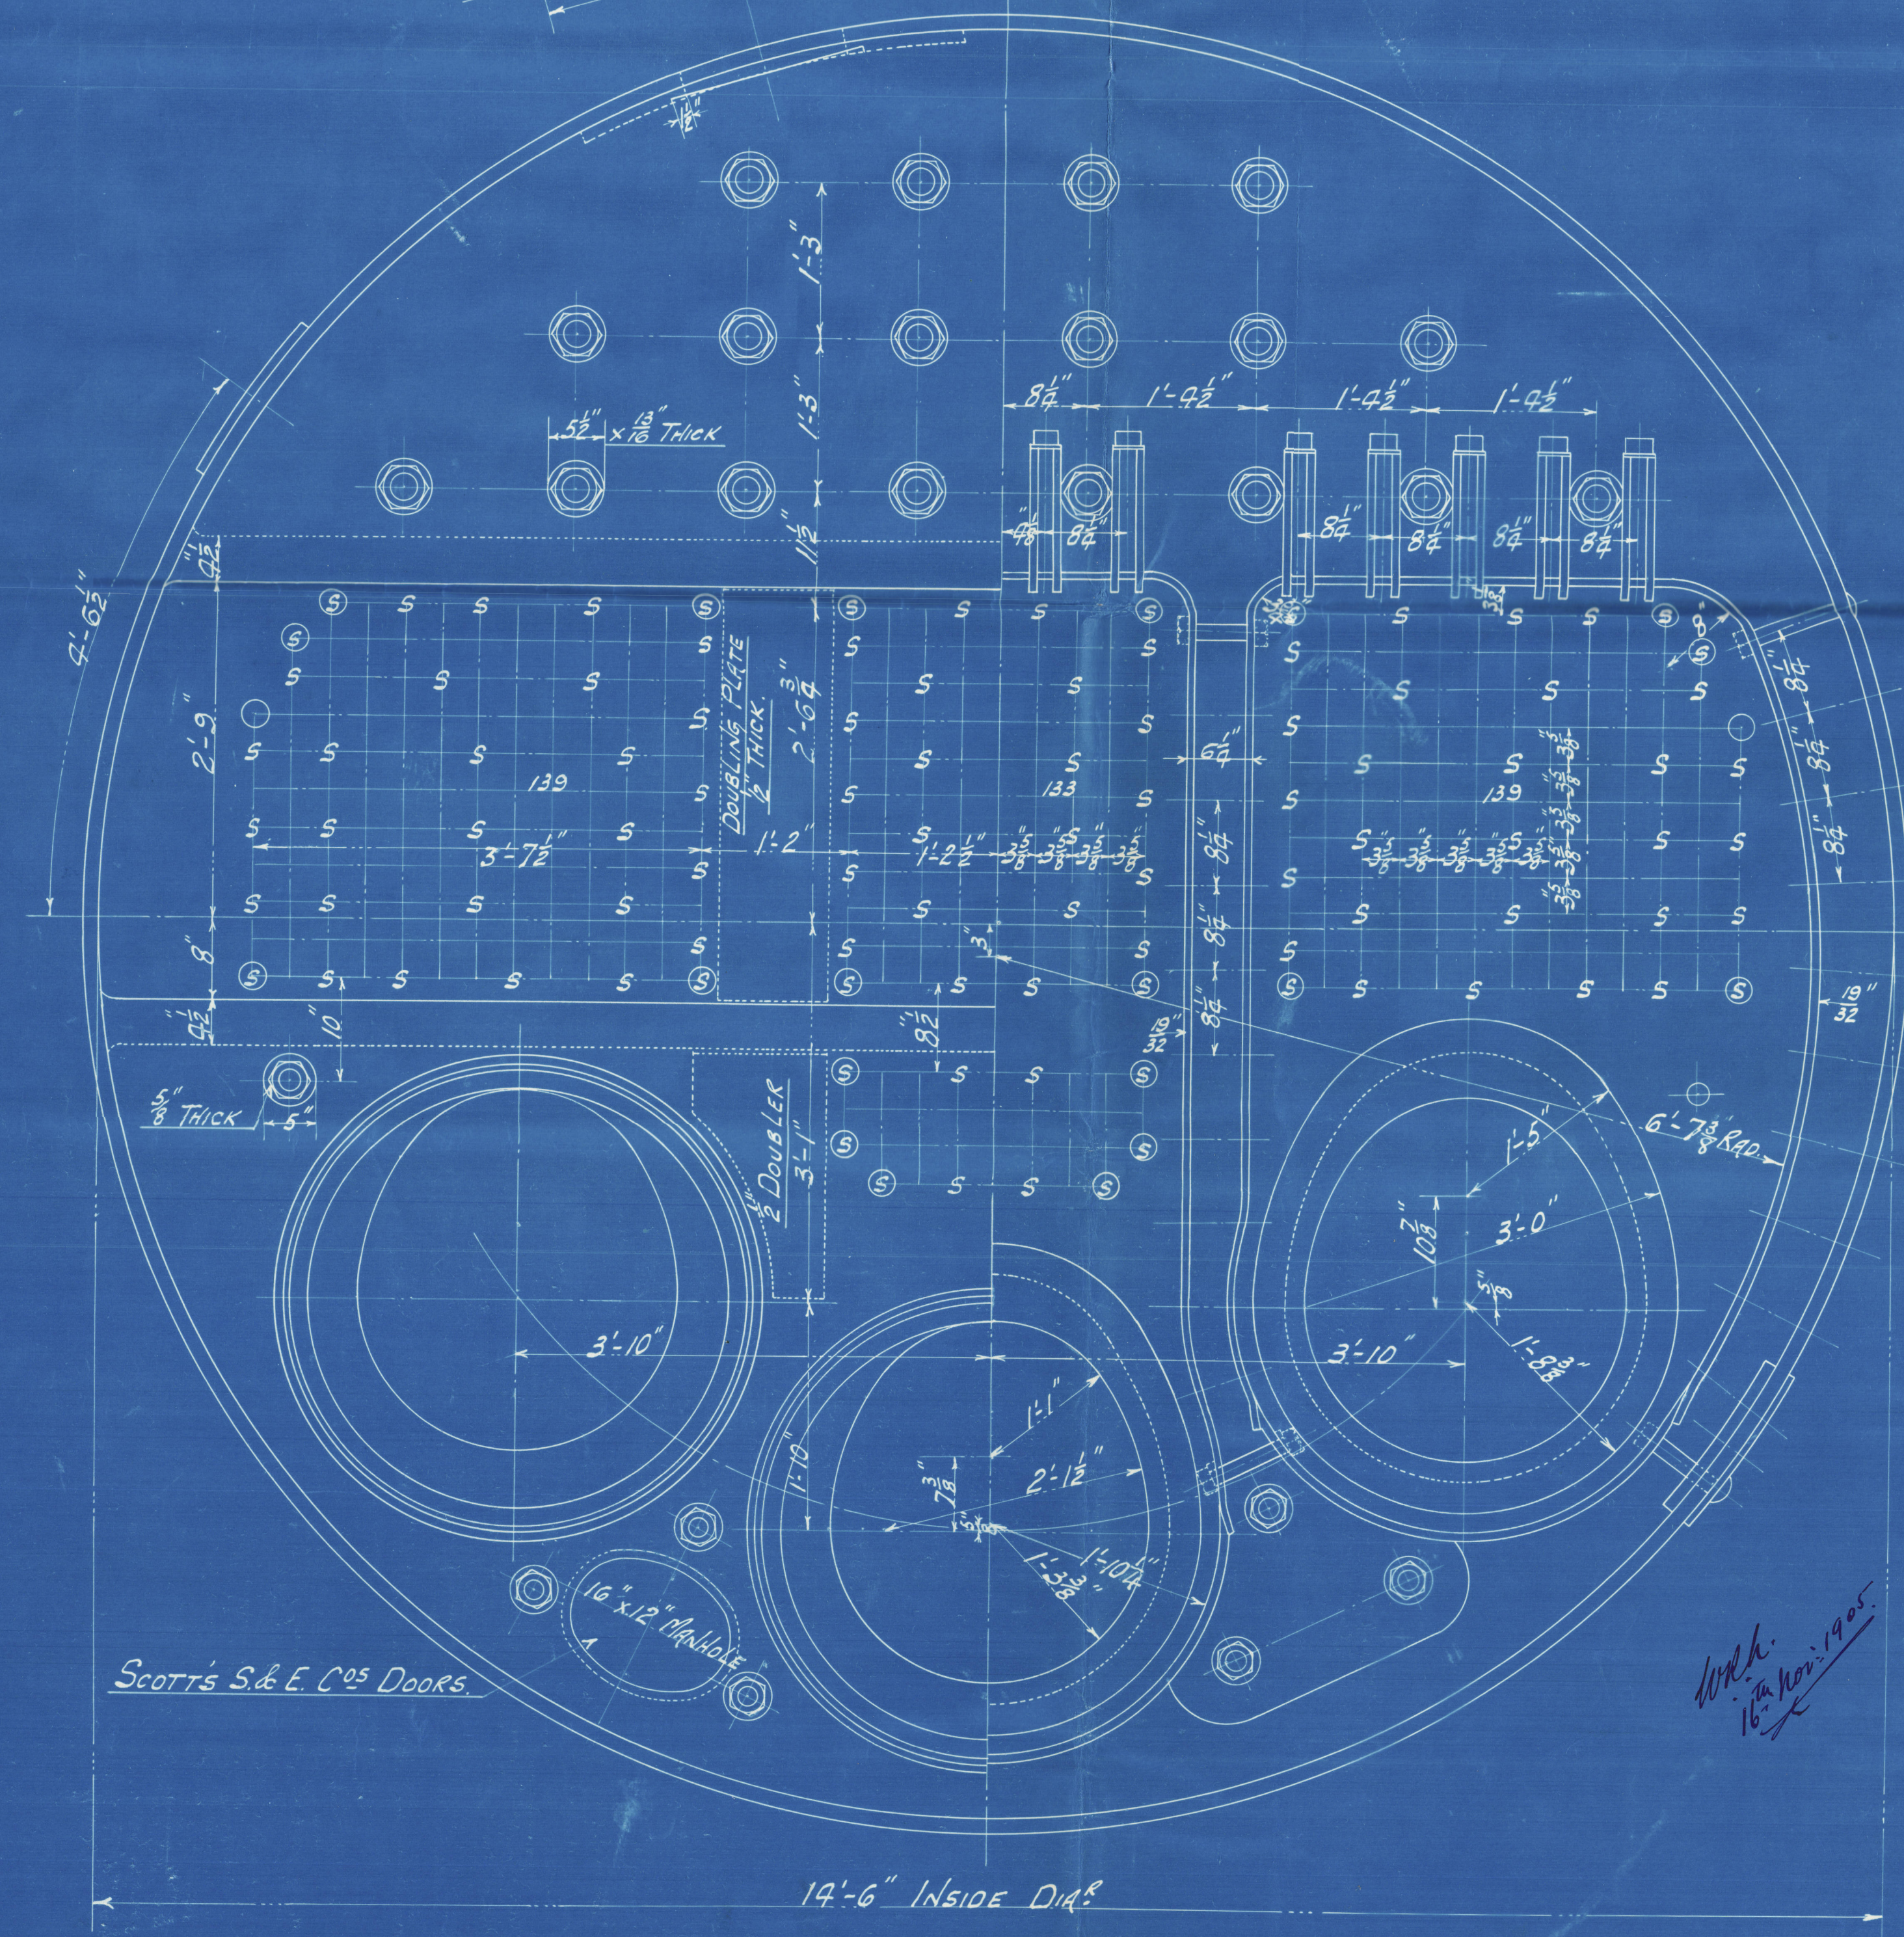

17.11.05.
17/11/05.

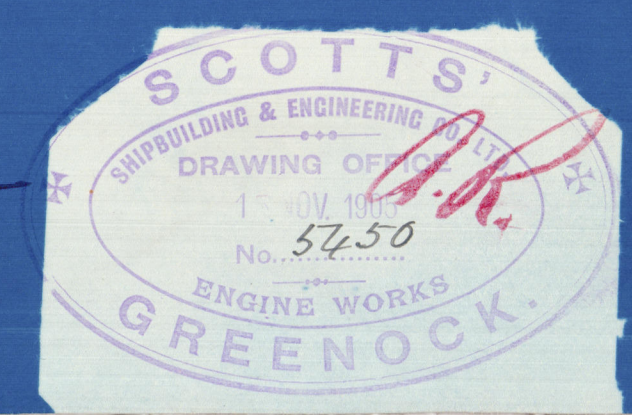

ENG. N^o 477
MAIN BOILERS. - 2 OFF.
SCALE 1" = 1 FOOT. DRAWING N^o 3081.

RETAIN

Mull: Steel Mann Berlin
N^o 444
by

Scotts & B. & Co. Ltd
for their R: 4074,

180 lbs working pressure

S.S. "Bardistan"

LLOYD'S REGISTER OF SHIPPING
RECEIVED
17 NOV. 1906
GREENOCK
LONDON

Ref No 14906

LLOYD'S REGISTER OF SHIPPING
RECEIVED
13 NOV. 1906
LONDON



© 2021

Lloyd's Register
Foundation

W795-0048