


15. 5. 13.
18. 11. 13.

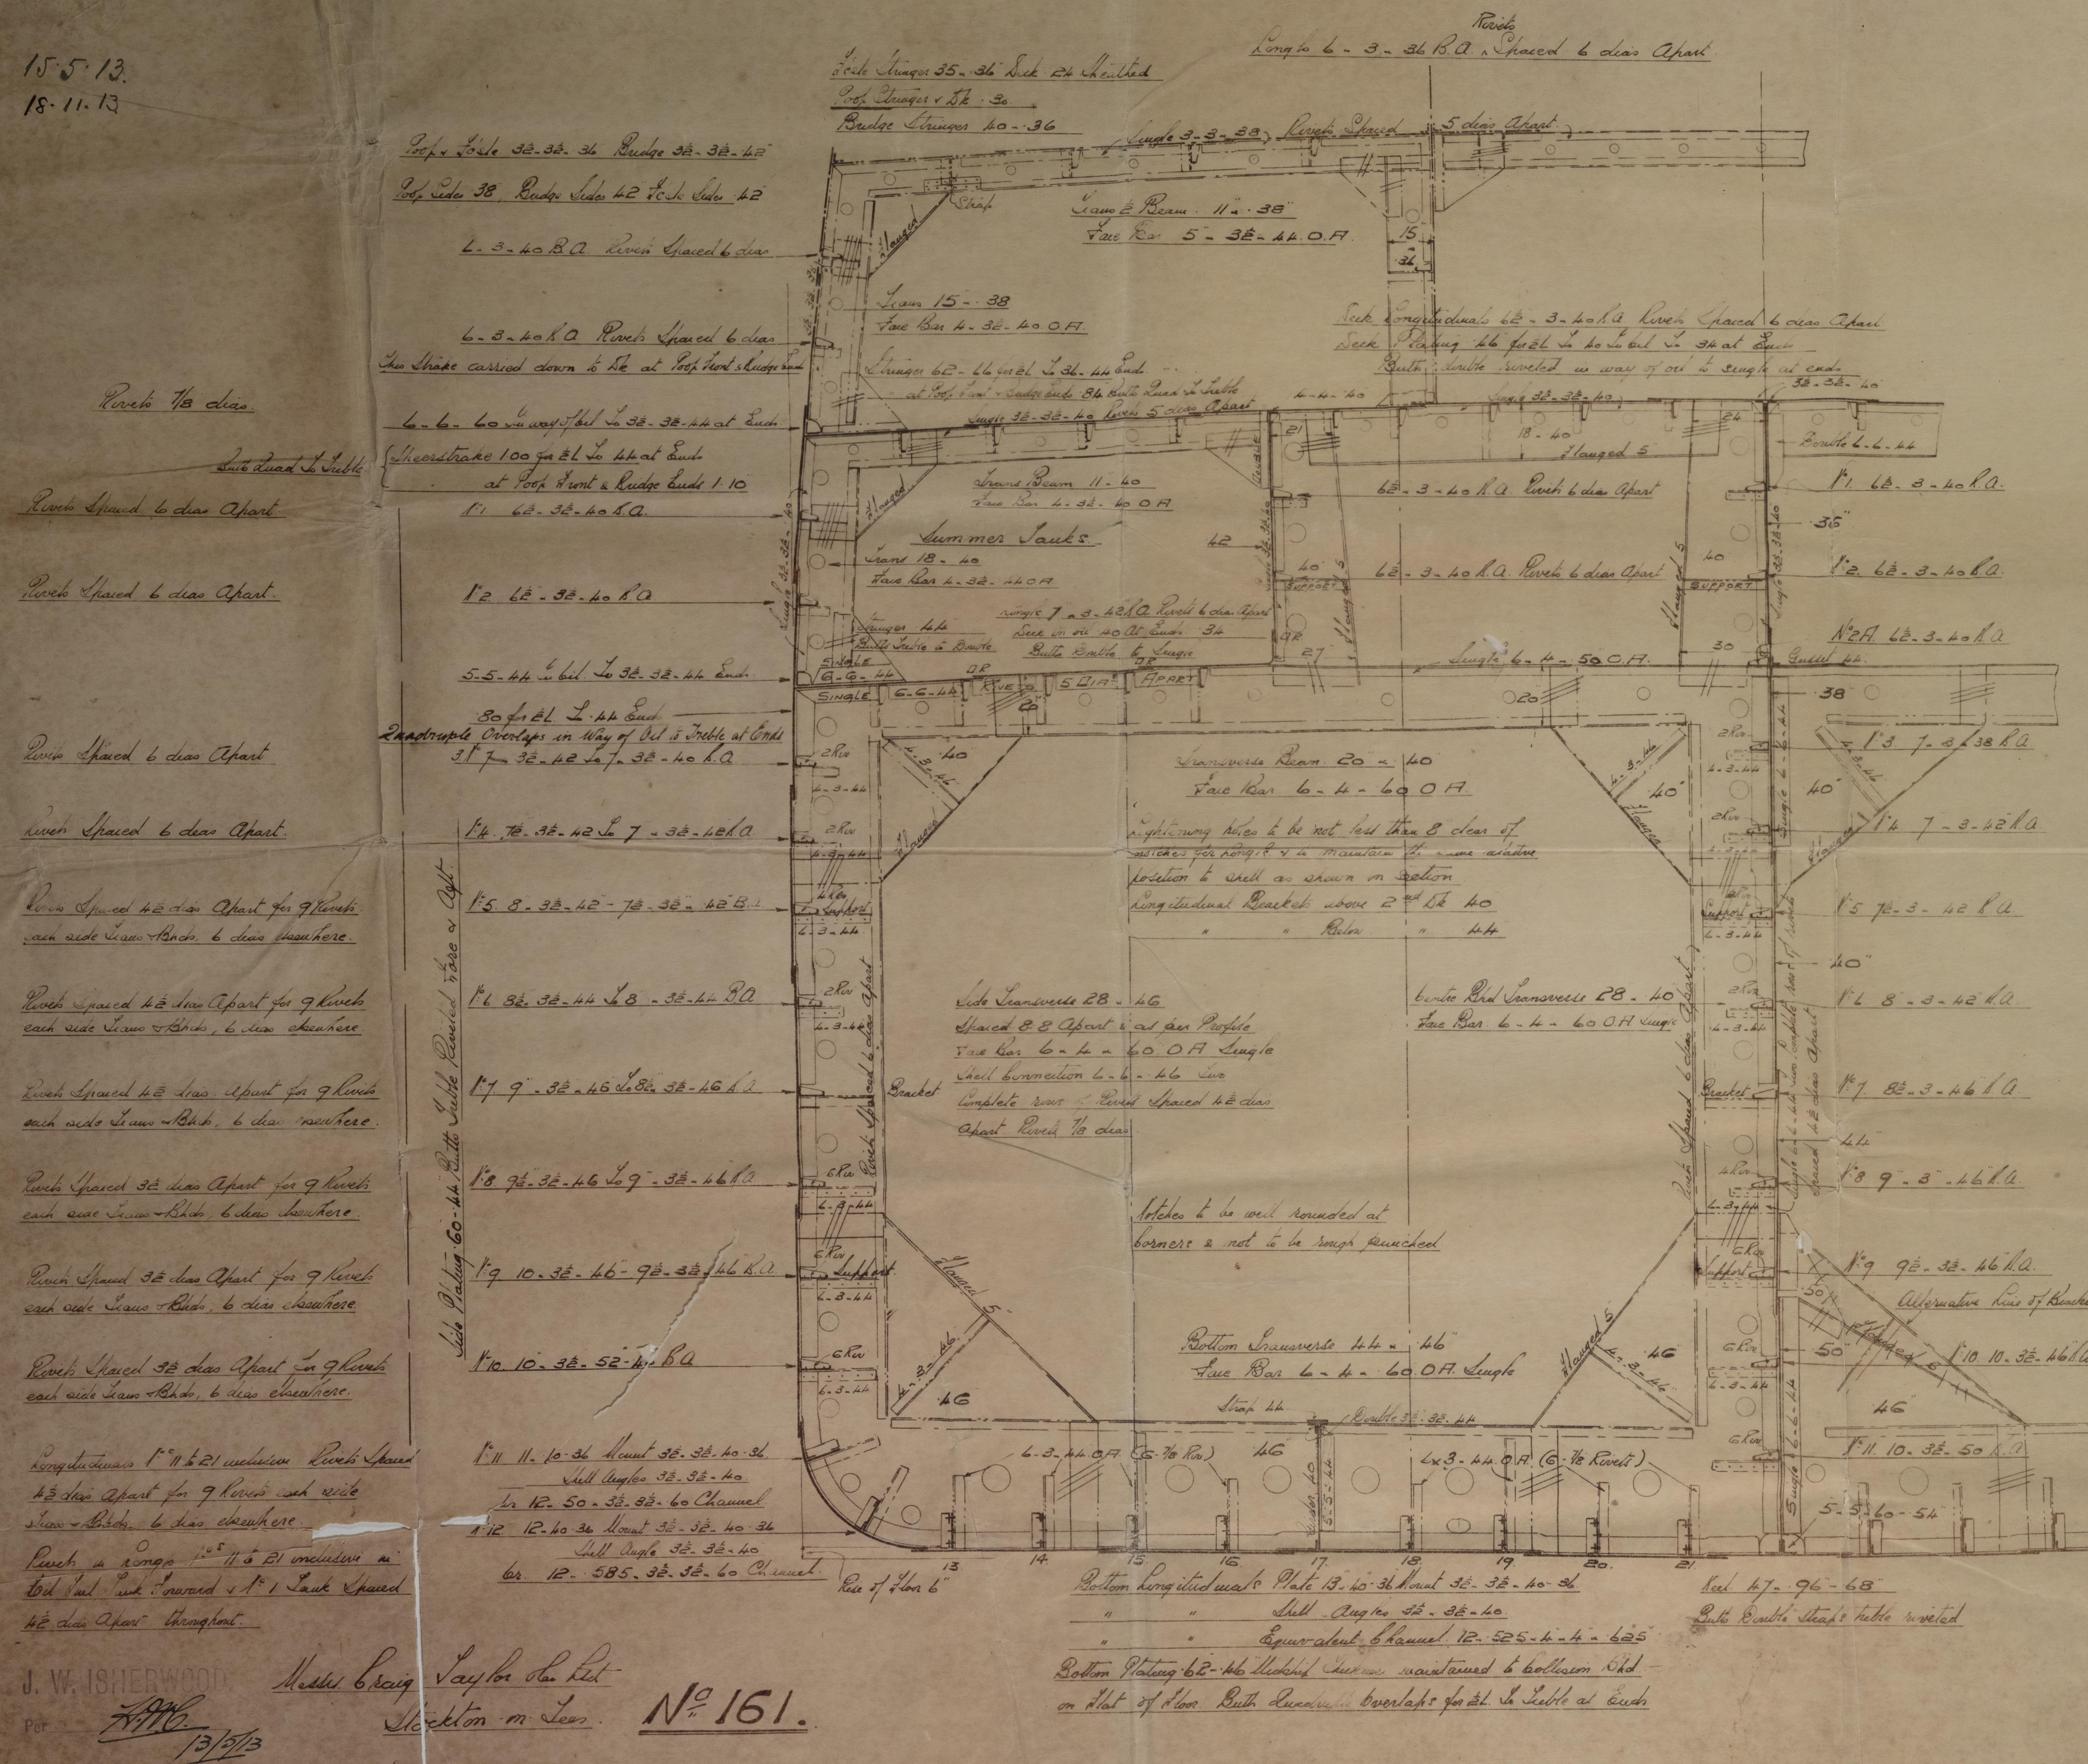

Length B^d 412'0" Breadth M^d 53'0" Depth M^d 31'0"

"Sherwood System" (Patent)


2 1/2" Scale.

Transverse $1^{\circ} 84' 0''$ Longitudinal $1^{\circ} 34608 \frac{L}{D}$ Upper Sk 13.29

Bracket attachments to be flanged as follows;

All bracket attachments to flat of bottom and to upper turn of bilge.

All other bracket attachments which require at least 10 rivets in either arm, i.e. of 3"3" breadth and upwards.

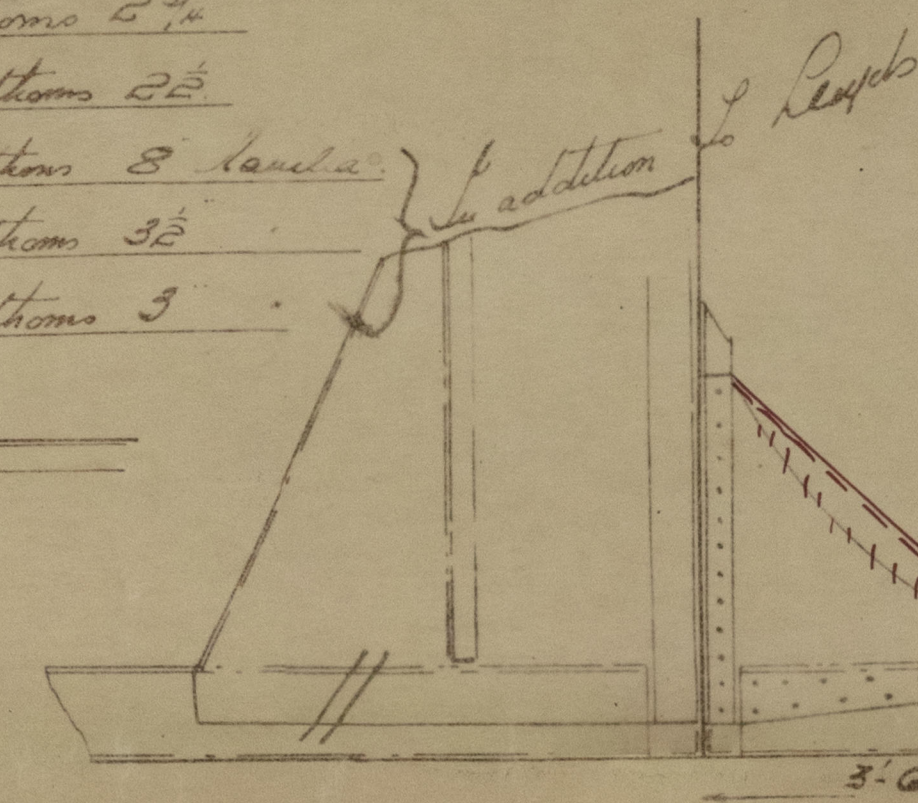
[illegible]

Alternative arrangement showing Brackets
Connecting Bottom Lugs to Ends of Channels are fitted


Feb 17-6 out from Centre

Feb 10-0" out from Centre

C. B.
15.5.13.

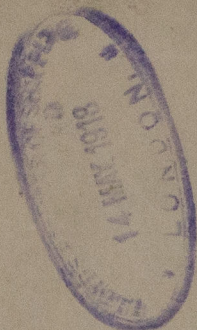

W80-0127

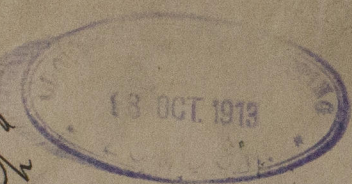

Messrs. Gray, Lang & Co.


No 764

Mid. Sec.

Santa

S/S. Melania

MIDDLESBRO' 8463

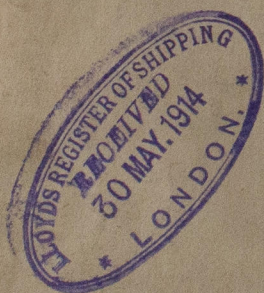

W80-0127

W80-0127

⊗
x



© 2020

Lloyd's Register
Foundation