

W80-0128

SOLANITE BRAND, REGD.
ALLOTT, JONES & CO., LIVERPOOL, MAKERS.

SOLANITE BRAND, REGD.
ALLOTT, JONES & CO., LIVERPOOL, MAKERS.

Trusts Craig Taylor & Co
Nr 161.


Mid Sec:

as Built

St. Melania

MIDDLEBRO' 8463.

Varita

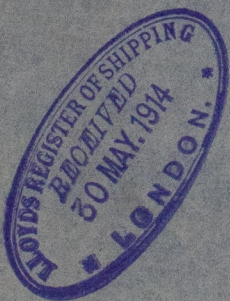

W80-0128



© 2020

Lloyd's Register
Foundation