

MAIN BOILER. ——— ENG<sup>S</sup>. NO<sup>S</sup>. 412-13-14-15.  
SCALES:—1" + 1/2" = 1 FOOT. 3-OFF FOR EACH NO.






Caid to Nos 412-13-14-15  
180 lbs to Penner


Caid to 10 lbs 352-3-4-5  
Standard Ship.

In 412 "War Enue" 1852  
See Report No 17343.

Sub. Rpt. 7 17343.

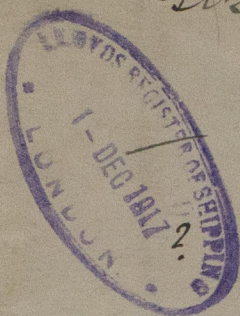

15/3/17

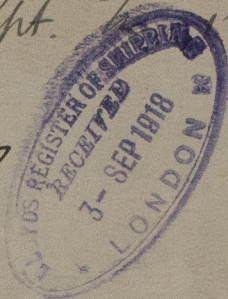

In 413

In 414

In 415 "War Anchusa"  
See Report No 17404.

Please return to Greenock

In Nos 413-414

J. Jones

W180-0181



© 2020

Lloyd's Register  
Foundation