


14.4.04

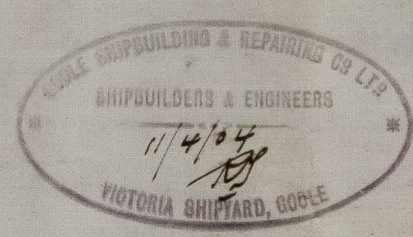

S.S. No 69.
MIDSHIP SECTION
OF A
STEEL SCREW STEAMER.
DIMENSIONS 143'-0.8" P x 23'-0" x 10'-6" MLD.
TO CLASS 100 A.1. LLOYDS.
SCALE 2" = 1 FT.

EQUIPMENT No = 6392.8


R.Q.D. = 2(57.75 x 2.0) + 15(7.0 x 6.7 + 17 x 5) + 5964.		
1 BOWER ANCHOR	8 1/2 CWTs.	STOCKLESS
1 " "	8 " "	" "
1 STREAM " "	2 3/4 " "	EX STOCK
1 KEDGE " "	1 " "	" "
165 FATHOMS	1 1/2 "	STUD CHAIN CABLE
45 " "	2 1/4 "	STEEL WIRE
75 " "	2 1/2 "	STEEL WIRE
90 " "	5 "	HAWSER

NUMERALS


1/2 BREADTH	11.50
1/2 GIRTH	19.50
DEPTH	11.00
LENGTH	142.00
	5964

1st No
2nd No

$\frac{L}{B} = 6.17$ $\frac{L}{D} = 12.91$

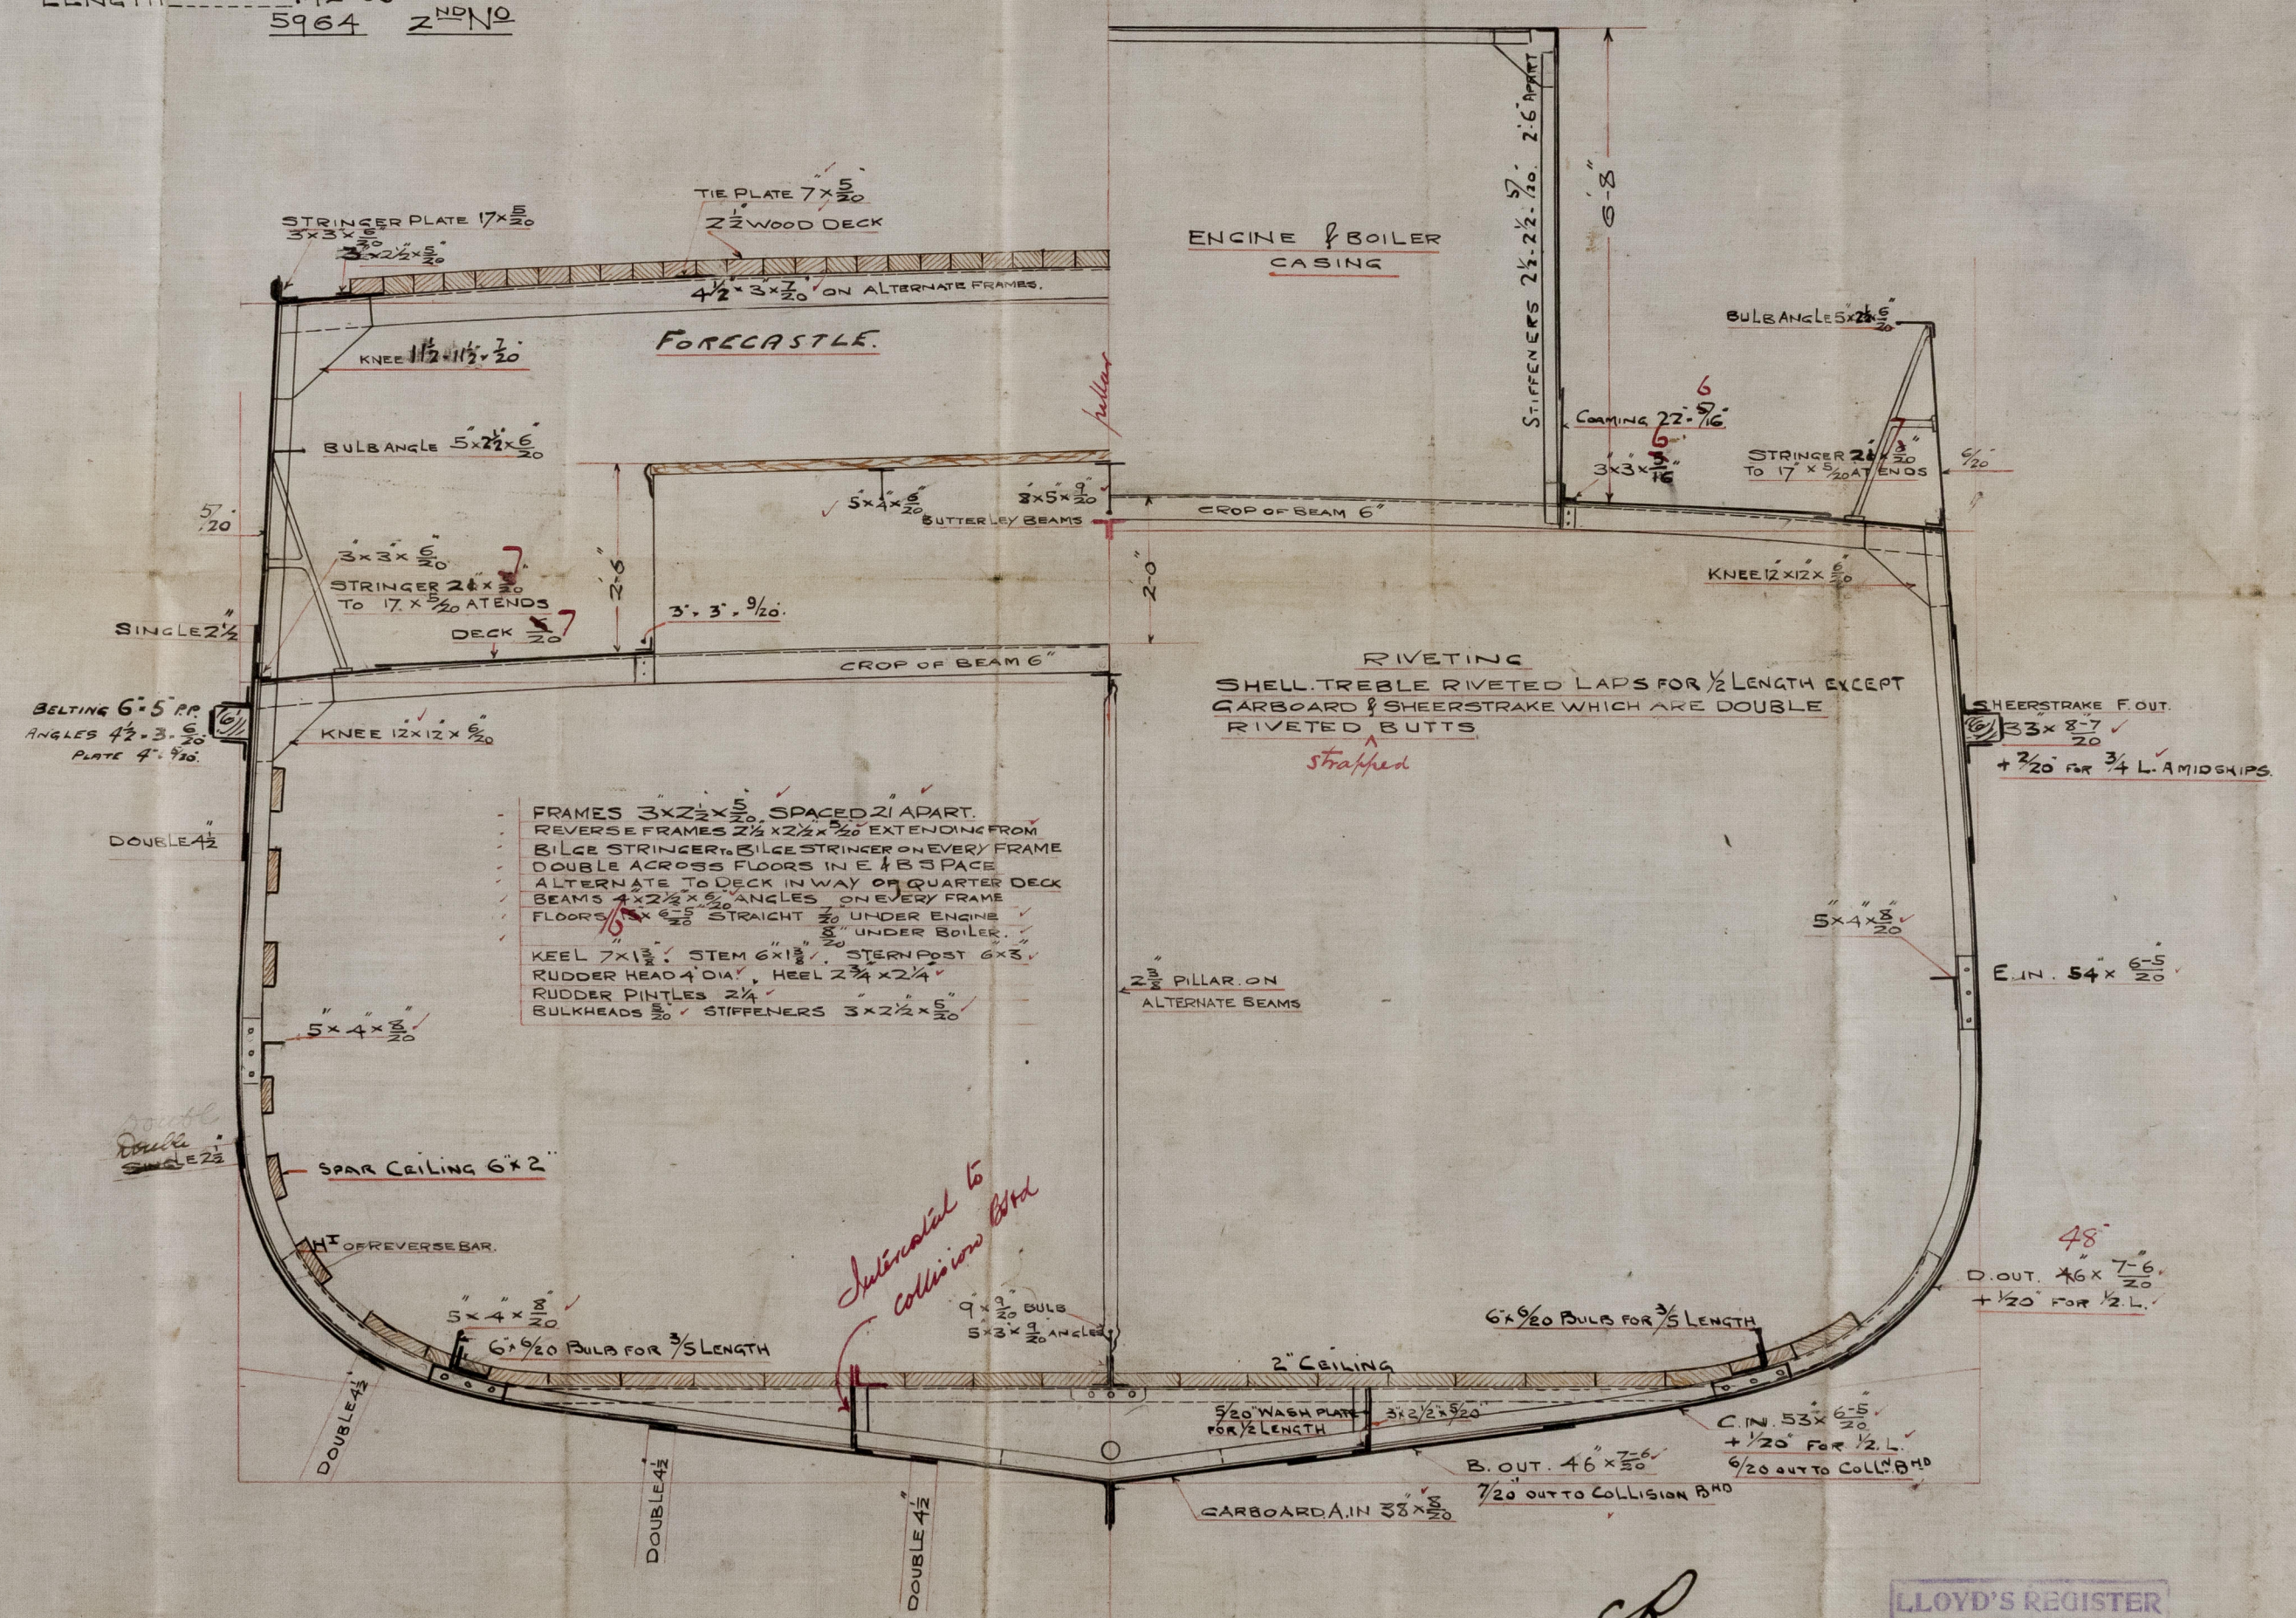

C.R.
14.4.04.

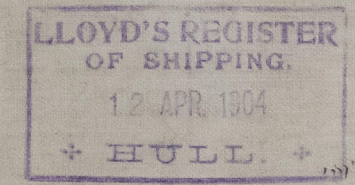

307
12-4-04

Midship Section

Goole S. & R. Co. Ld.
— No. 69 —

of Portsea

Hull Rpt. No. 16257



© 2021

Lloyd's Register
Foundation

W801-0076