


14.4.04

S.S. N^o. 69.
PROFILE & DECK PLAN
DIMS. 143'-0" BP x 23'-0" x 10'-6" MLD.
SCALE $\frac{1}{4}$ " = 1'.

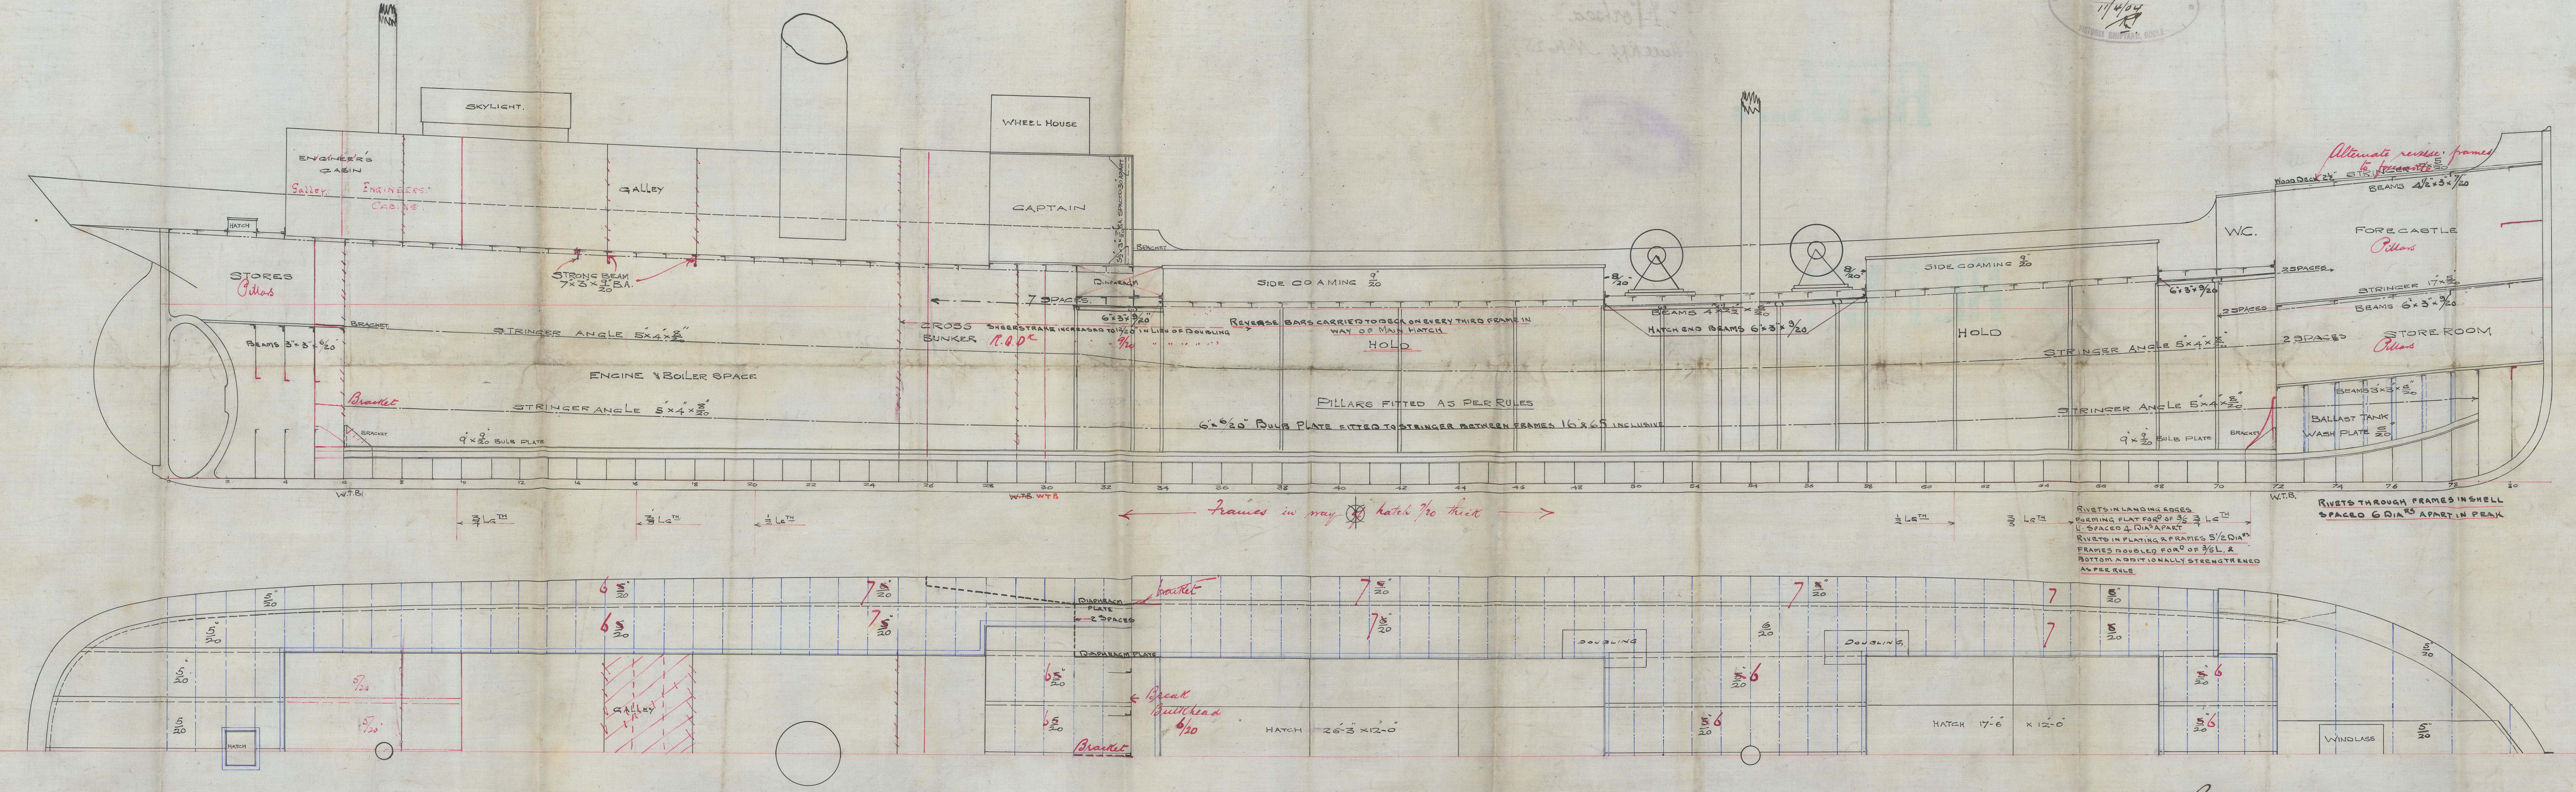

C.B.
14.4.04



2.27
12-4-04

W801-0077

Profile & Sk plan

Goble & Co.
No 69

% Portsea

Hull Rpt. No 16257



© 2021

Lloyd's Register
Foundation