



13. 11. 12

MID SECTION

No 270

LENGTH. B.P. 102'-6"

BREADTH. MLD 18'-5"

DEPTH. MLD 9'-0"

SHEER FORE & AFT 2'-3"

SCALE $\frac{1}{2}$ - 1 FOOT



EQUIPMENT

- TWO 5 CWT EX STOCK ANCHORS
- ONE 1 1/2" STREAM DO
- ONE 3/4" KEDGE DO
- 135 FATHS OF 1 1/8" STUD CHAIN CABLE
- 45 FATHS OF 5/16" STREAM CHAIN
- 75 DO " 5/16" HEMP
- 45 " 3/8" WARPS
- 45 " 2 1/2" DO OR
- 90 FATHS OF 1 3/4" WIRE

PROPORTIONS

- DEPTH TO LENGTH 11.08
- BREADTH TO LENGTH 5.5

NUMERALS

BREADTH MLD	18.416	1ST NO	18.42
DEPTH	9.25	2ND NO	9.25
LENGTH BP	102.5		102.5
	2810.4		2836.17

13. 11. 12





© 2021
Lloyd's Register
Foundation

J. Dean & Son
 No. 240
 Annand

Midship Section
 Page "Dolly Bridge"
 Hull Report No. 26580

2 - NOV 1912

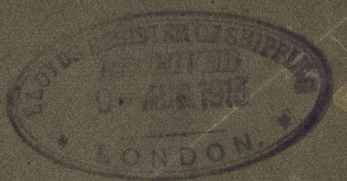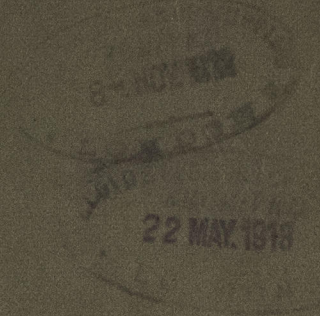


W802-0012

13/11/12

26580

26580

62

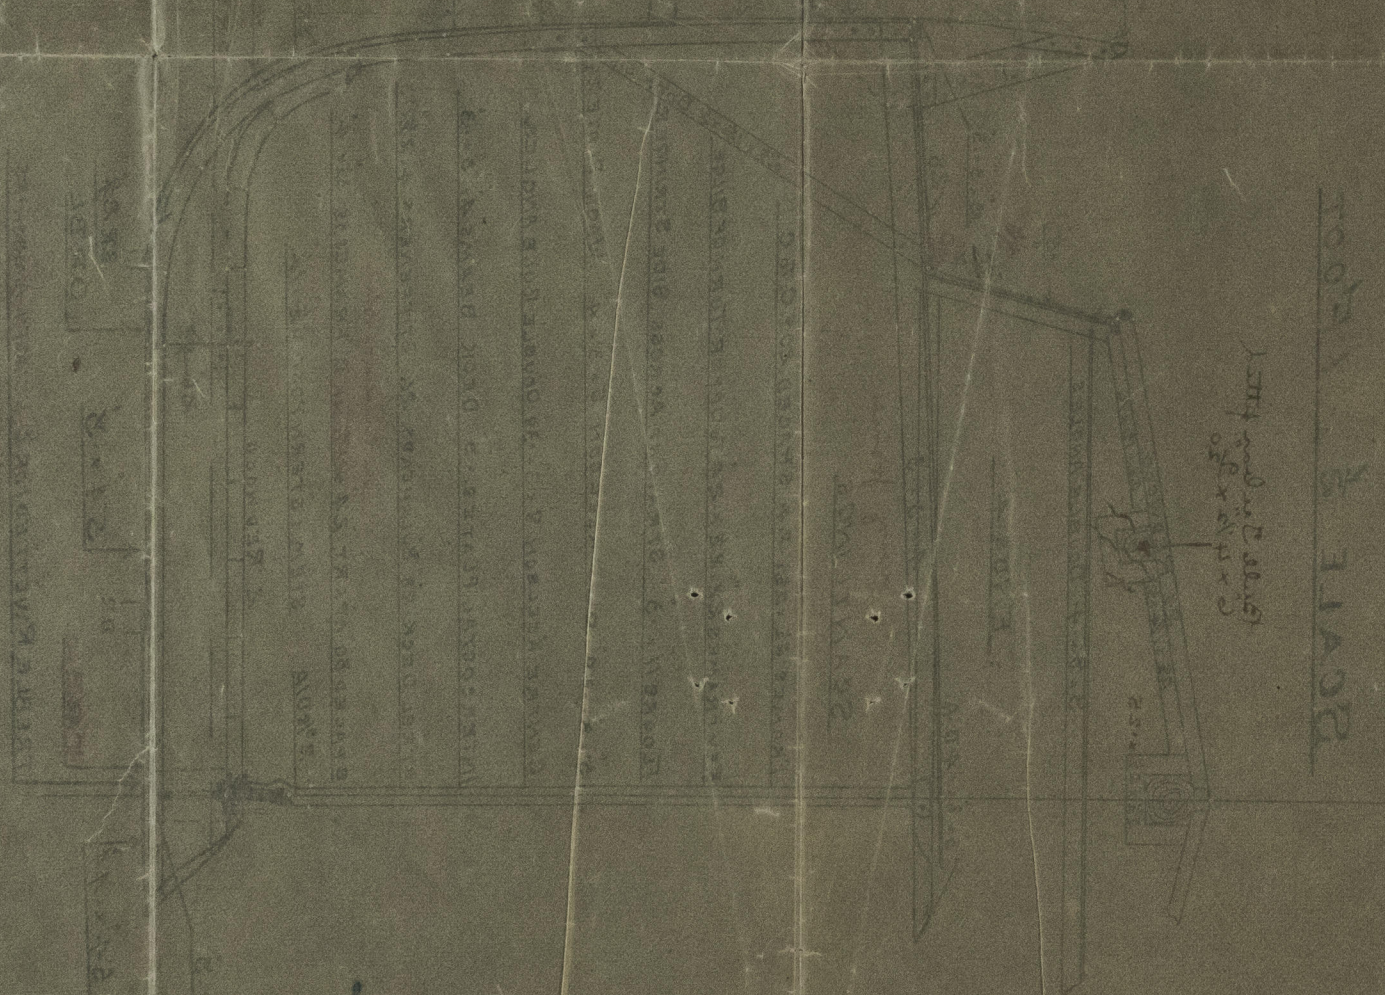

1/11/12

20' 0" 1/2








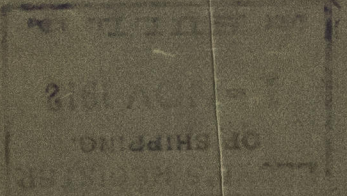




© 2021
 Lloyd's Register
 Foundation