


13. 11. 12

SEAGOING LIGHTER


DIMENSIONS	
LENGTH BP	102' 6"
BREADTH M ^{LD}	18' 5"
DEPTH M ^{LD}	9' 0 3/8"
SHEER FORE & AFT	2' 8"
SCALE	3/8" = 1 FOOT

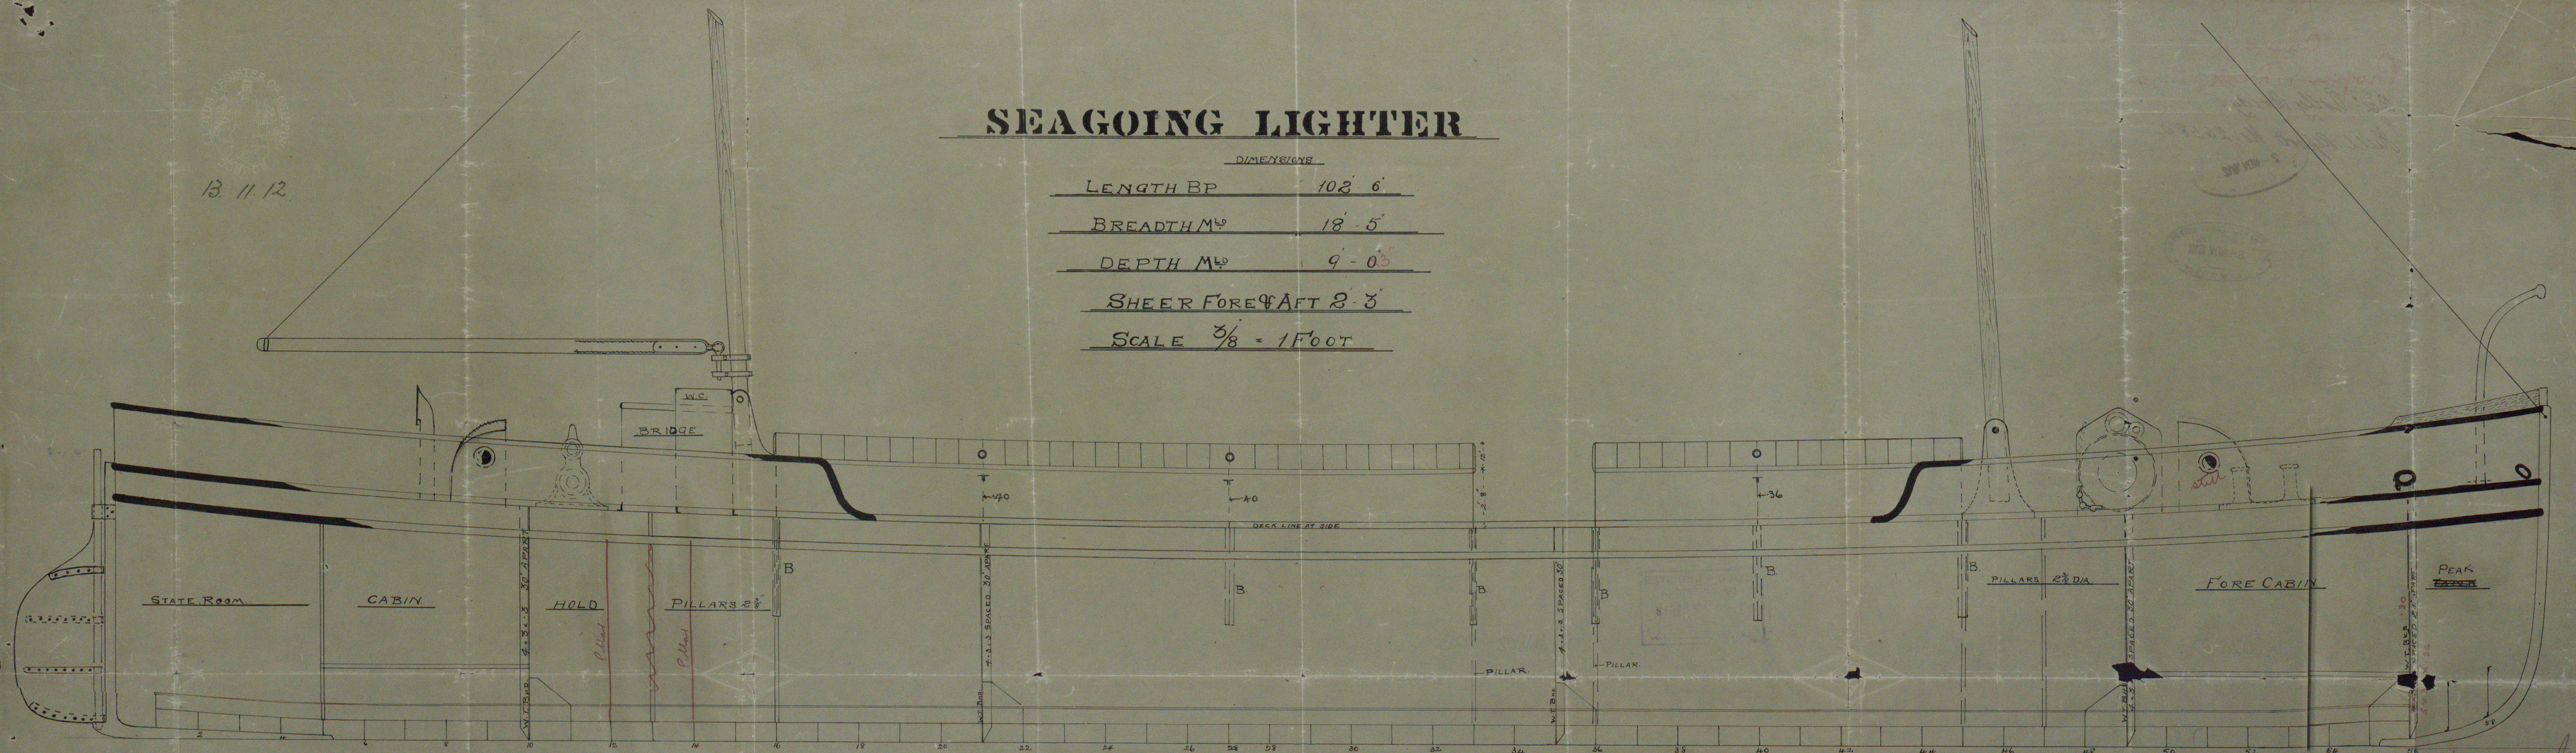

Masts supported to surveyor's satisfaction

Pillars throughout to surveyor's satisfaction


13. 11. 12

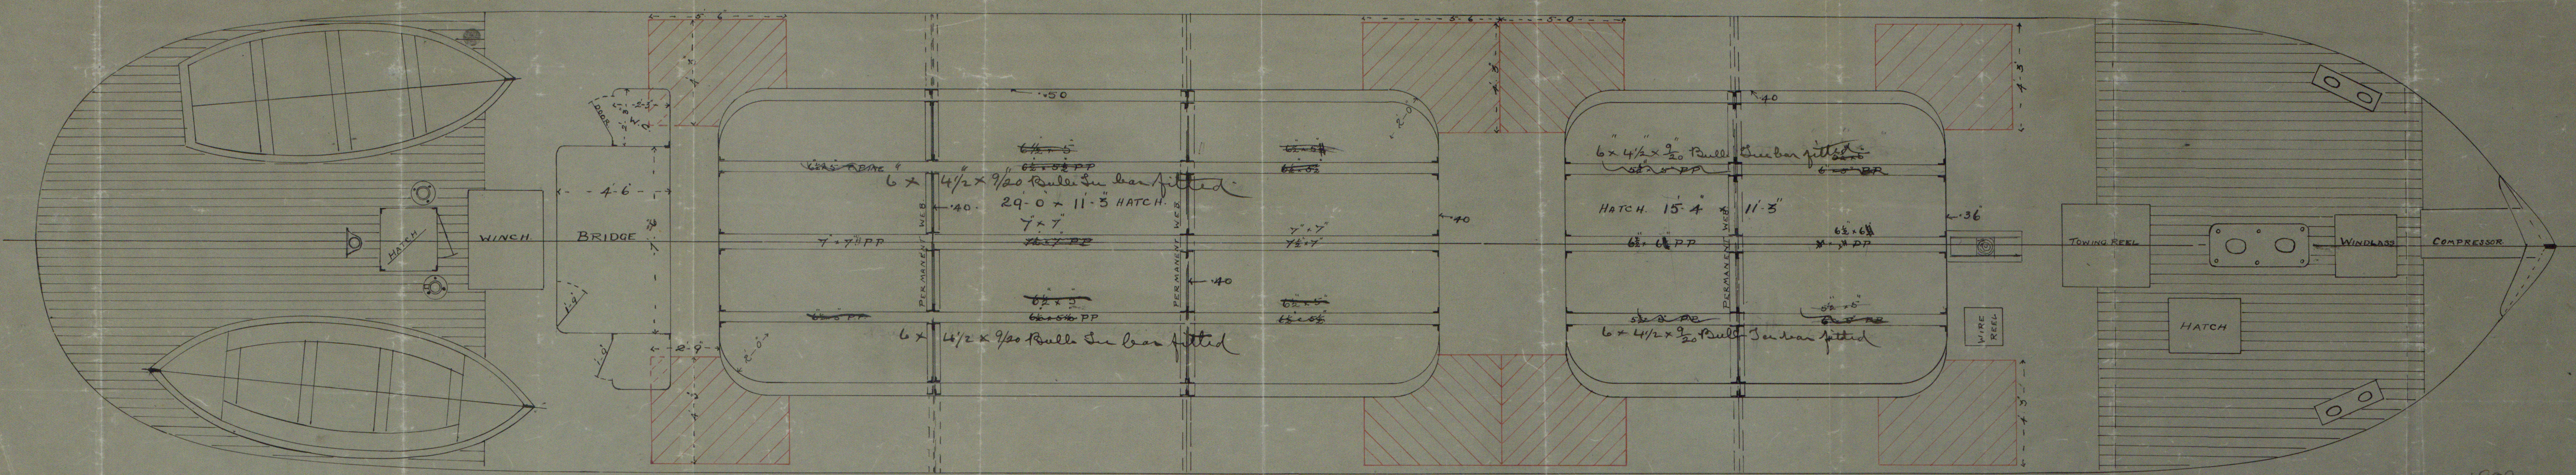

J. Dean &
 No 240.
 Amended.
 Profile & Deck Plan
 Bgs. Polly Bridge
 Hull Report No: 26580.

2 - NOV 1912

LLOYD'S REGISTER
 OF SHIPPING
 8 - NOV 1912

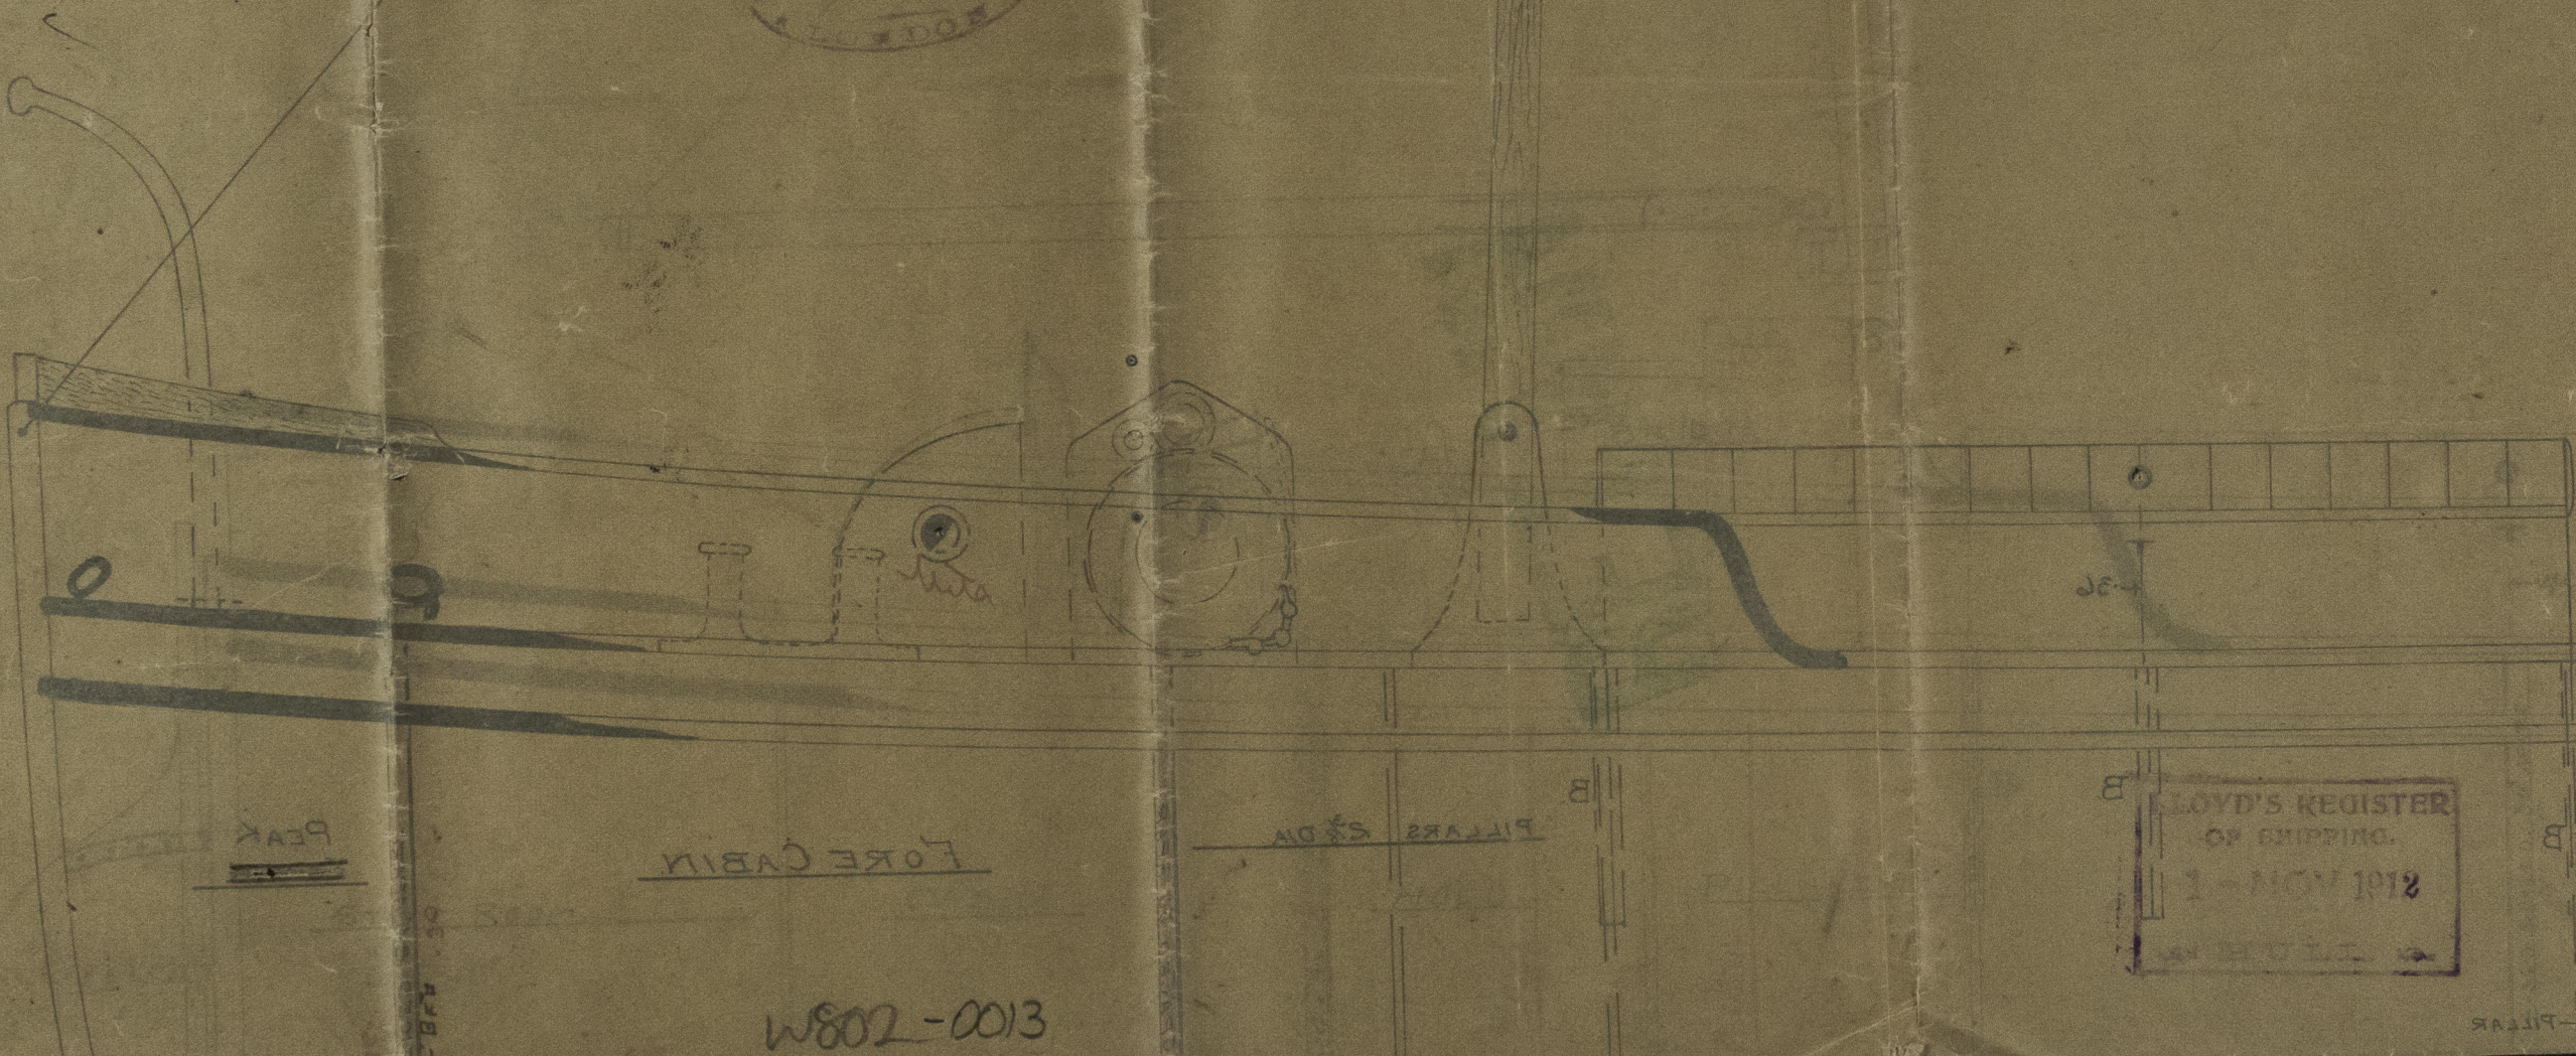

W802-0013

LLOYD'S REGISTER
 OF SHIPPING
 1 - NOV 1912

PIERS