


22.12.03
29.1.04
22.9.04

Midship Section of No 212 S.S.

440'0" 55'0" 33'3" Inld.

To Class 100A1. Three Deck Rule, with Shelter Deck.

Scale $\frac{1}{2}$ One Foot.

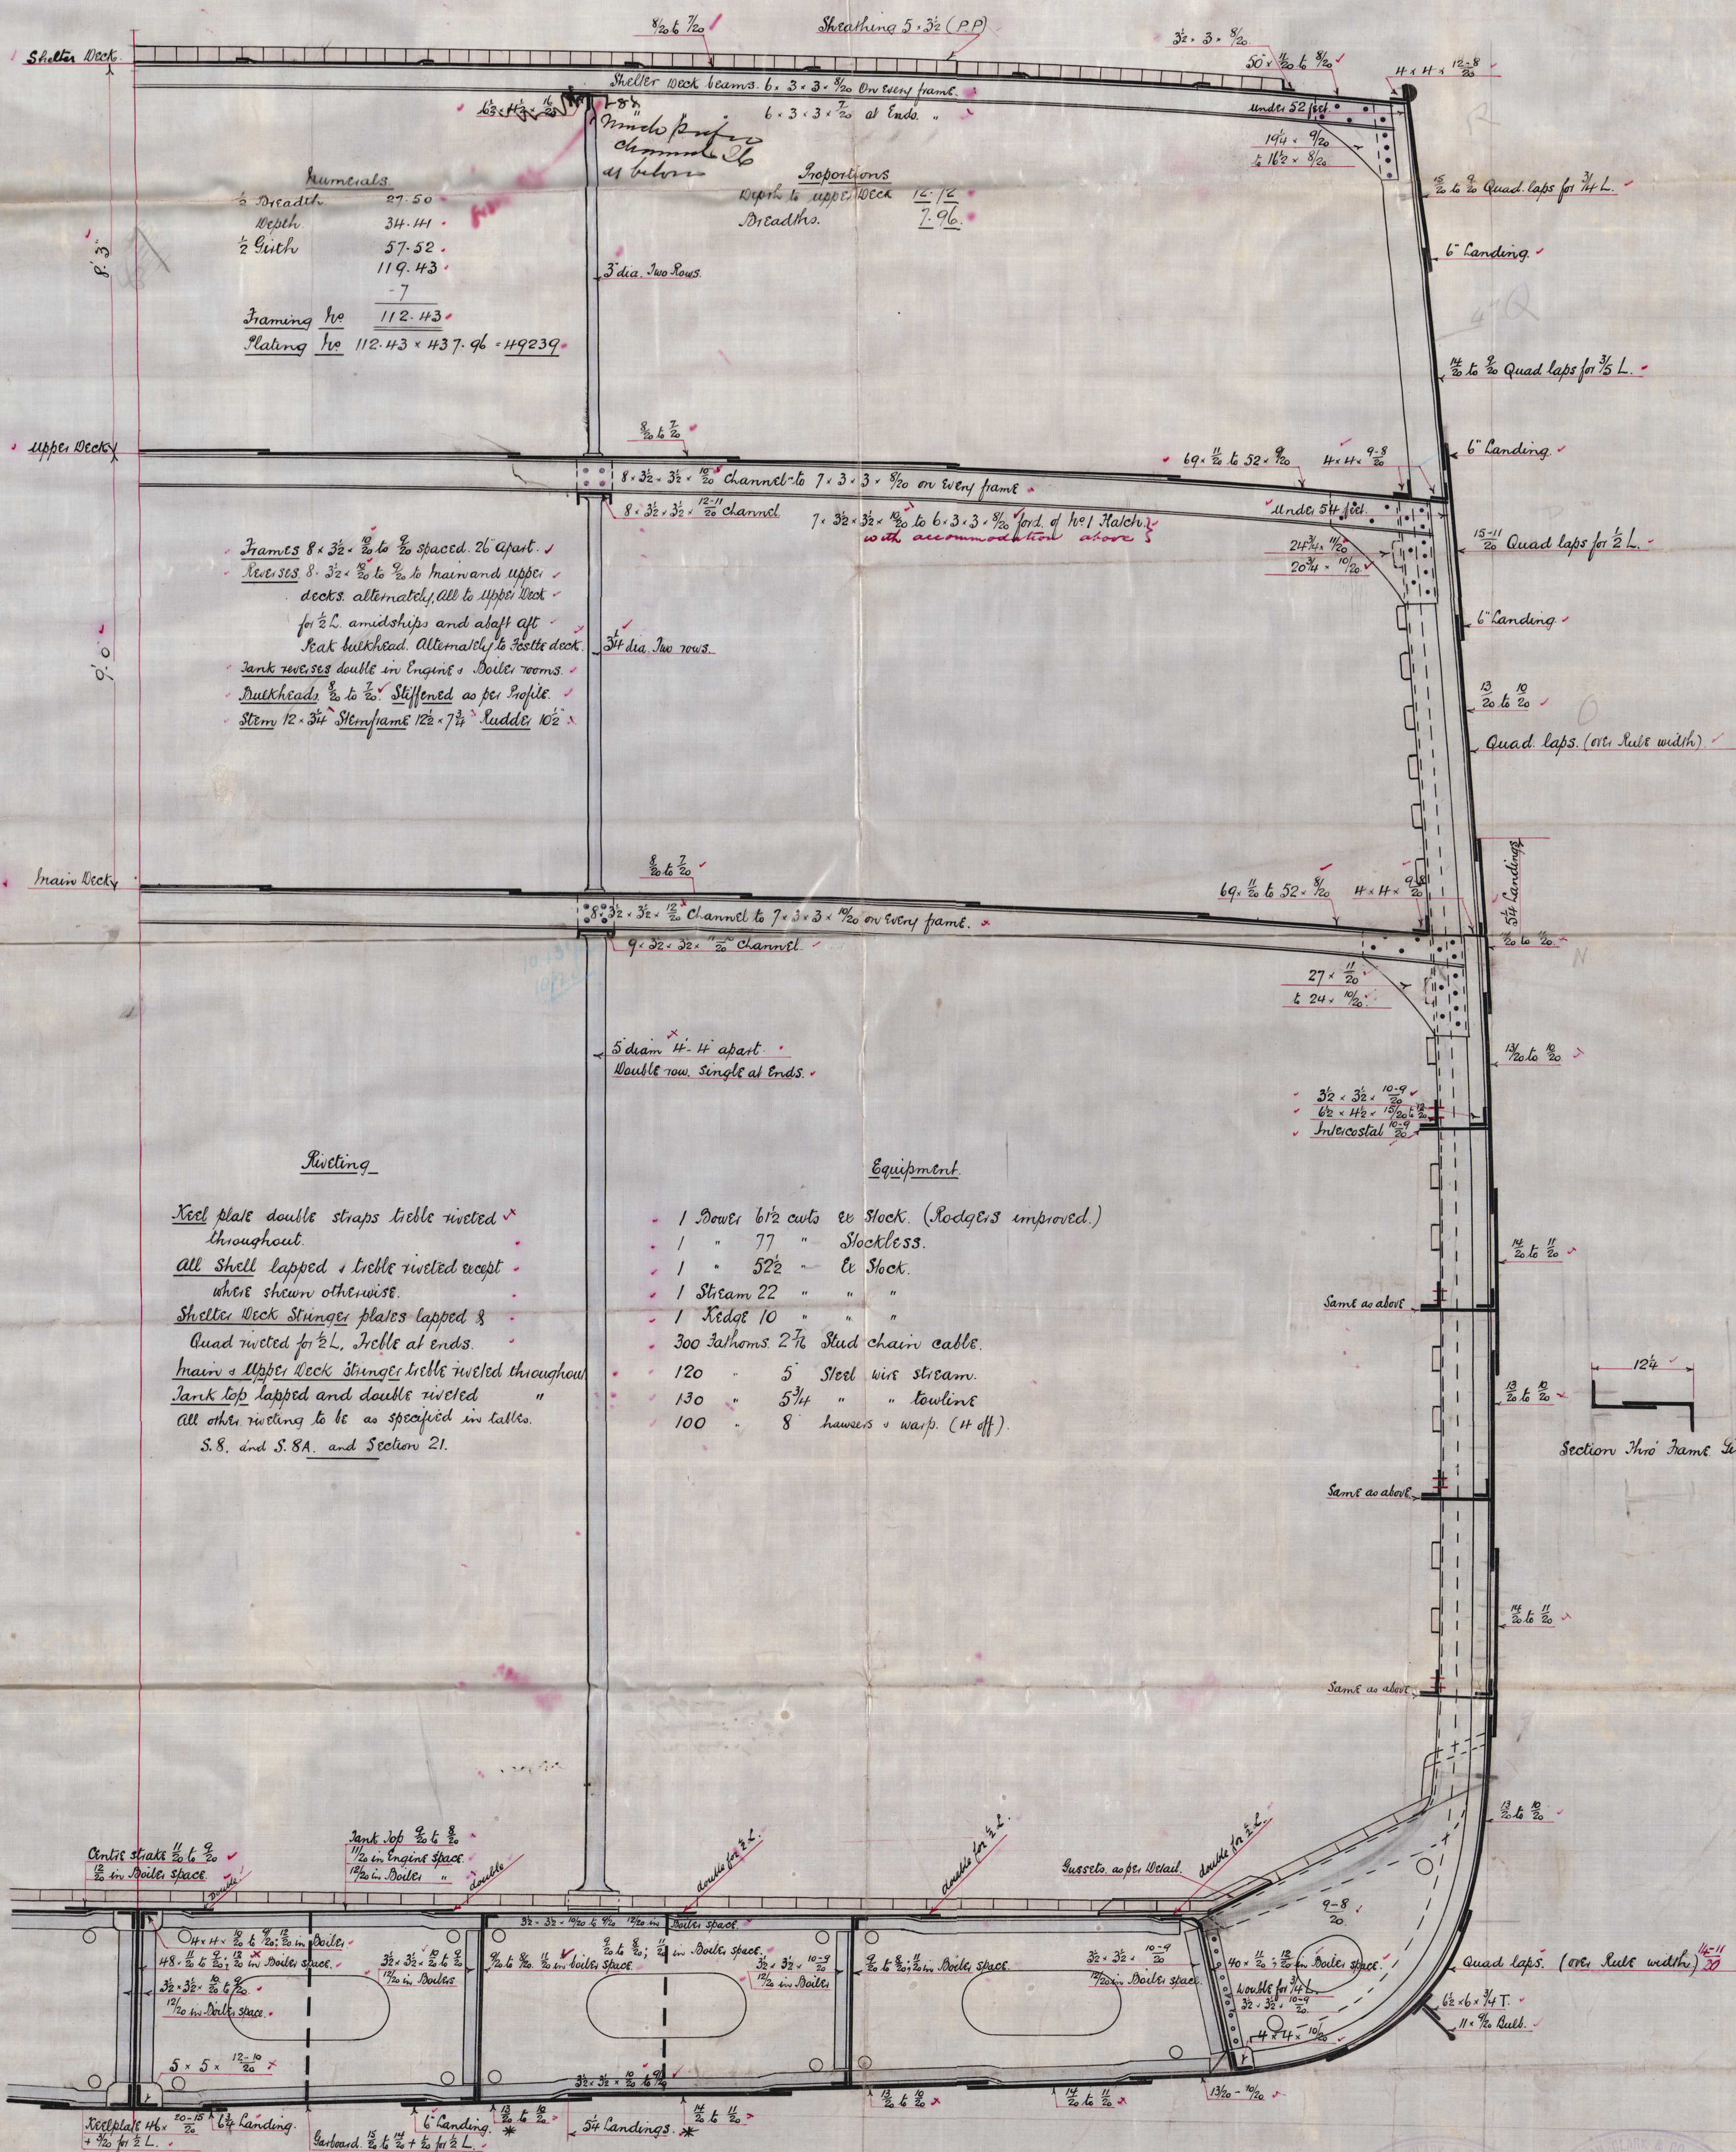

Press Workman Clark & Co

S.S. 212

Midship Section

J. P. Corry & Co

Star of Scotland

Vol. 5807

