


13.12.04
8.3.05

Longitudinal Section No 224 S.S.
Scale 1/8" = 1 Foot.

Mr. W. H. M. M. M.
22.22
Profile Plan
Report No. 224
S.S.

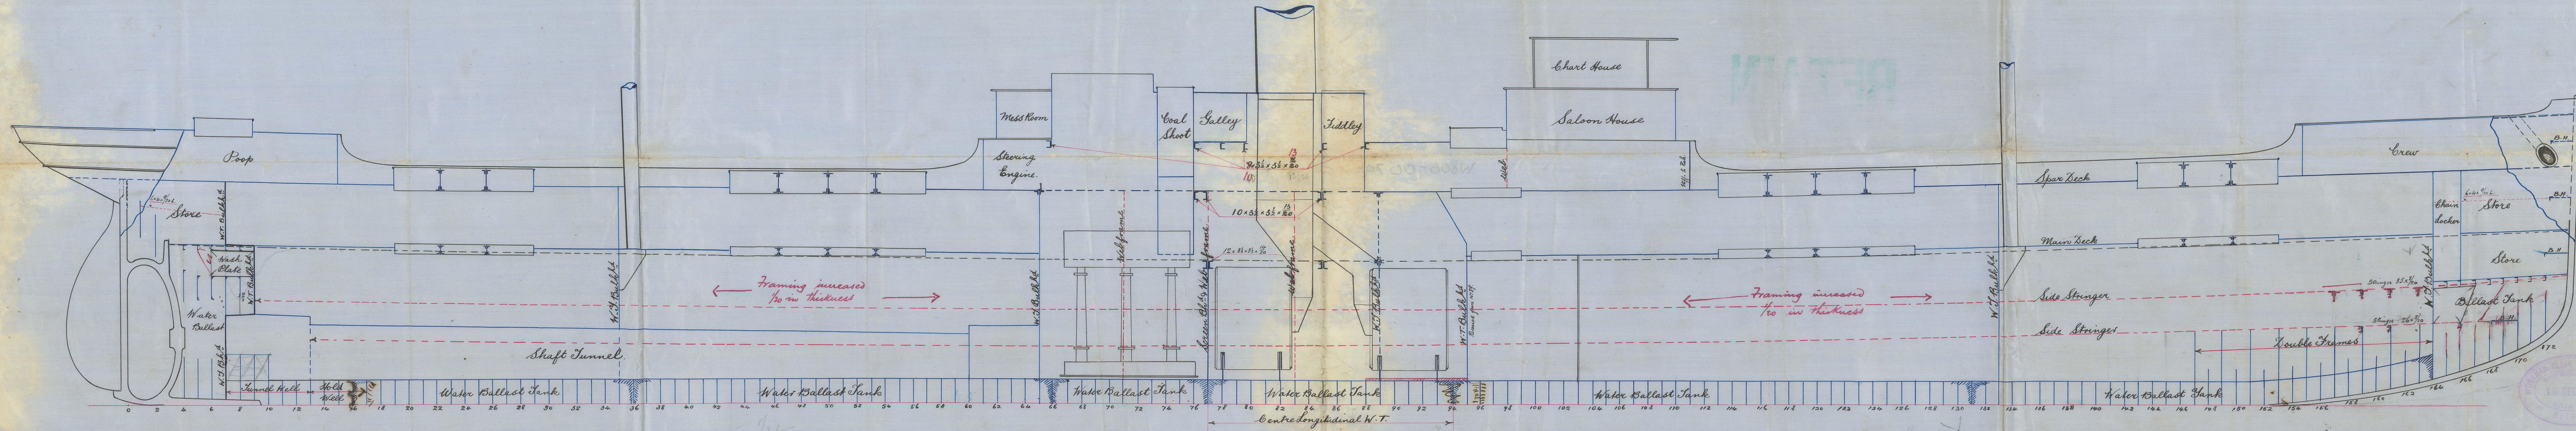

W. H. M. M. M.
13 DEC 1904
S.S.

C.B.
13.12.04

Press^{no} Workman Clark Ves


SS. 224.

Profile Plan

Report No. 5969

Orator

RETAIN

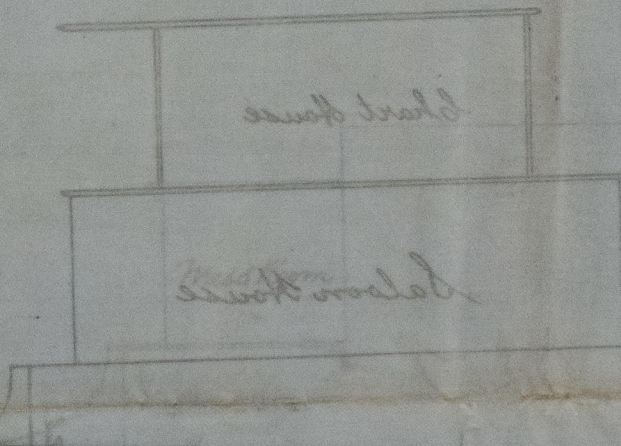

© 2021

Lloyd's Register
Foundation


W806-0079

7

PT 20-208W

13.11.04
6.3.05

13.11.04
JH

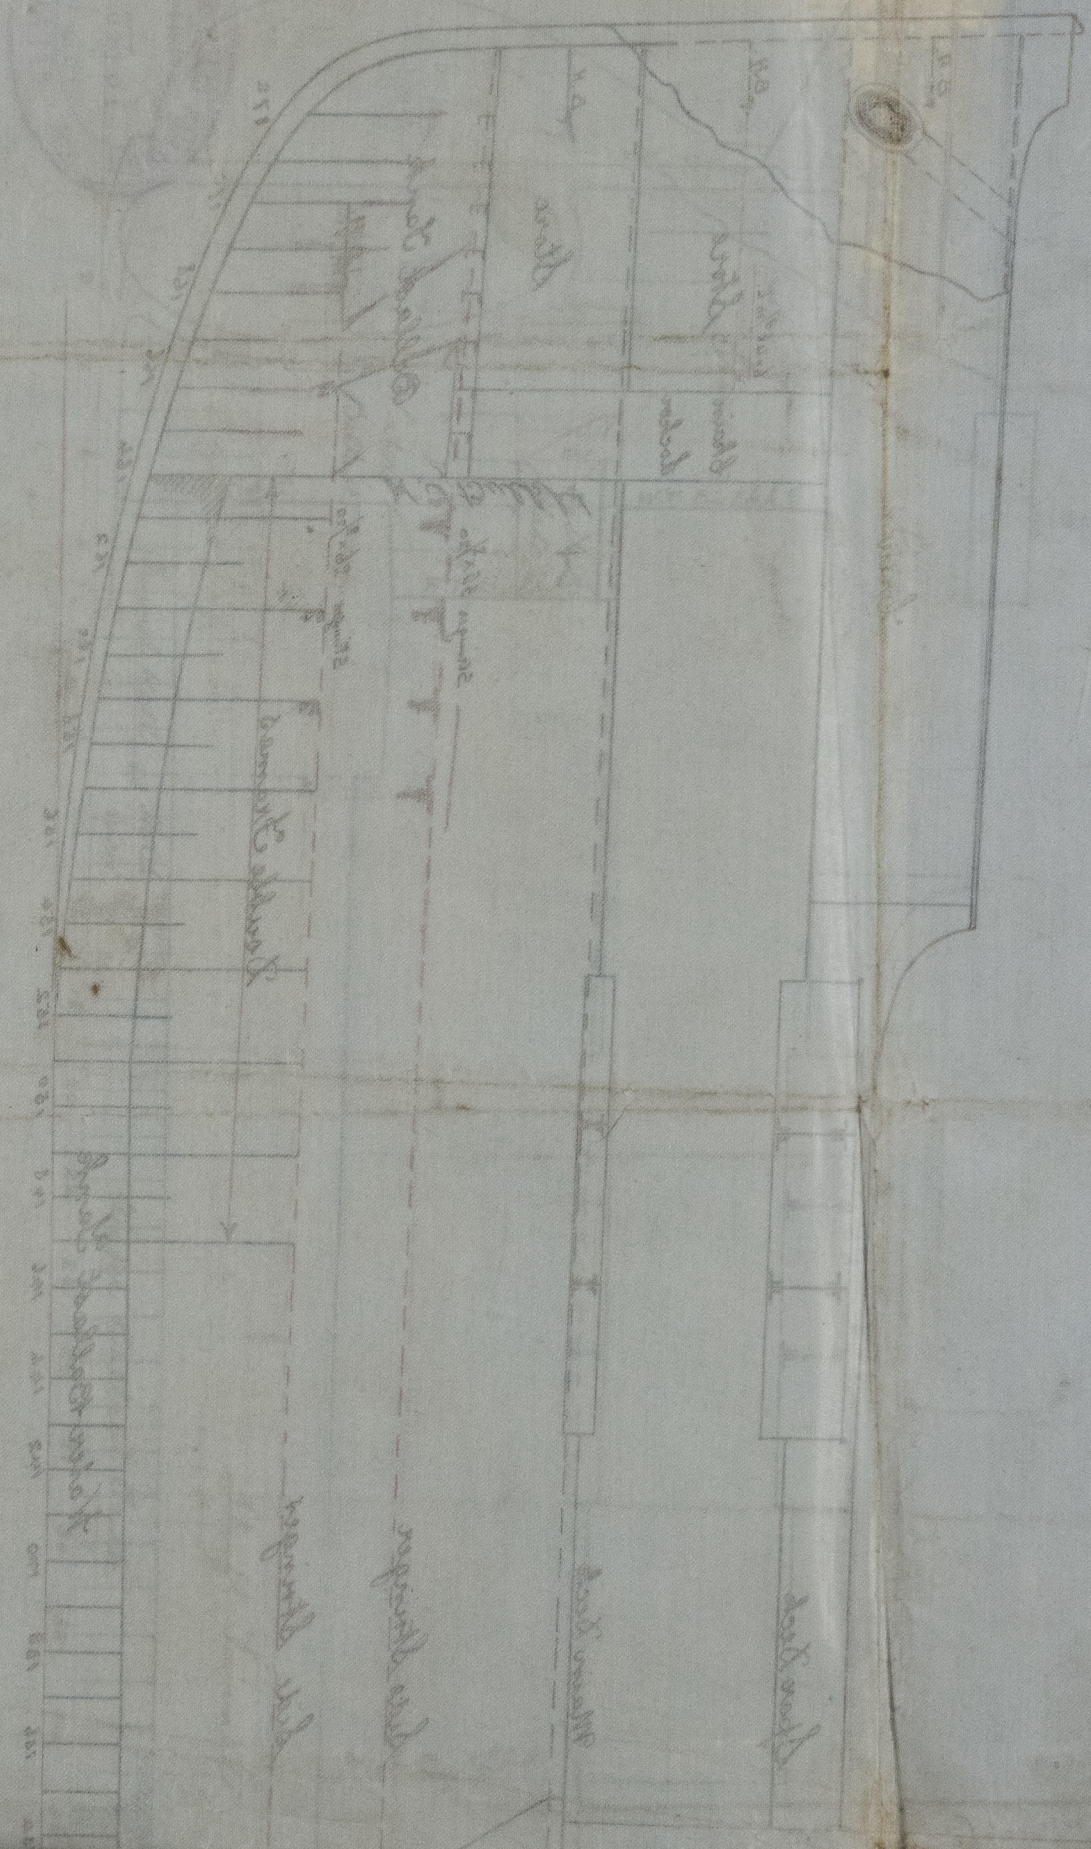

© 2021

Lloyd's Register
Foundation