

N<sup>o</sup> 590  
DIMS: 119'-0" B.P. x 22'-0" EXT. x 12'-9" MLD  
SCALE 1/4" INCH.

Nº 590

DIMS: 119'-0" B.P. x 22'-0" EXT. x 12'-9" MLD

SCALE 1/4 INCH



3255

Messrs Lloyd's Swireyott  
Hull

18/8/13



21. 8. 13.

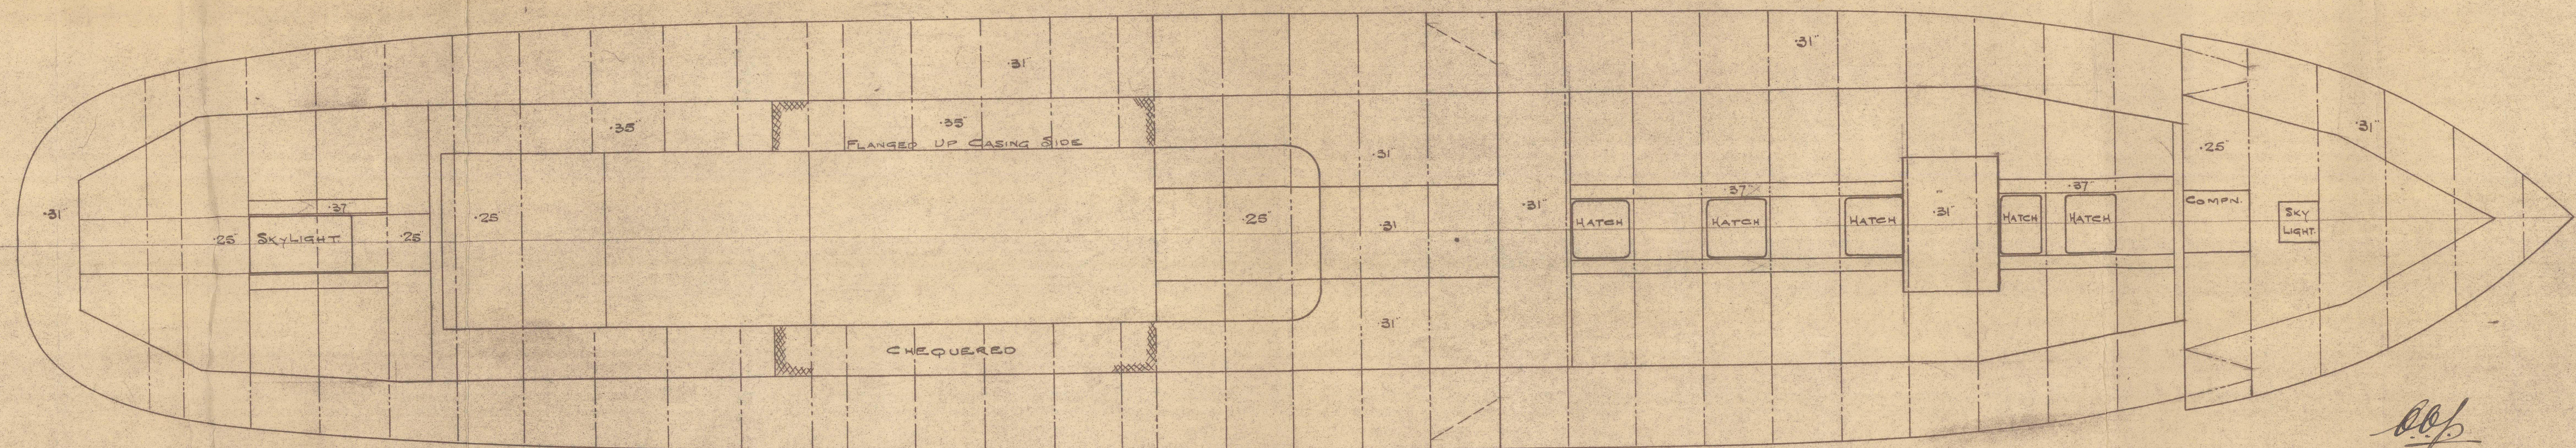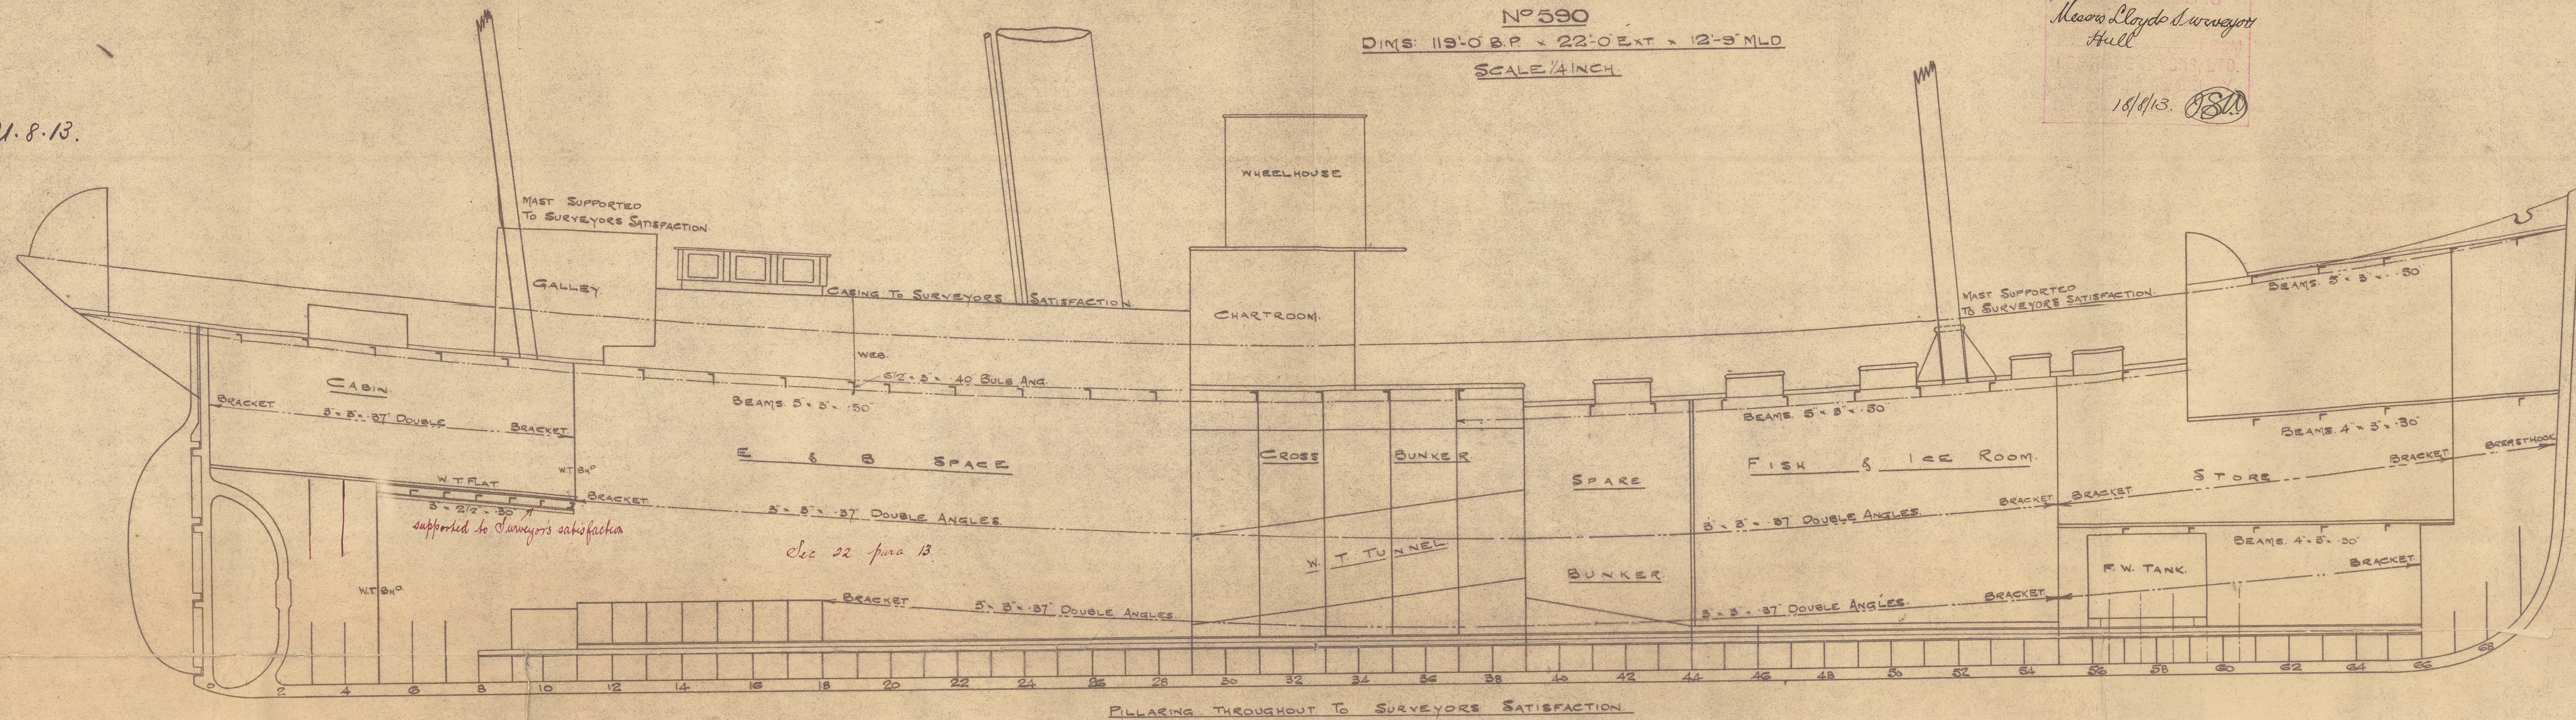

21.8.13.



Cochrane & Sons.

N<sup>o</sup> 590.


Profile of Weeks.

*Dimensions*

119-0 x 21-87 x 12-75.



s/s Okino  
Hull Rpt No. 27166

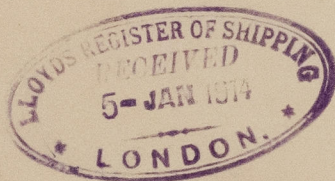

RETAIN



© 2021


Lloyd's Register  
Foundation

W807-0115



LLOYD'S REGISTER  
OF SHIPPING  
10 AUG 1913

HULL © 2021

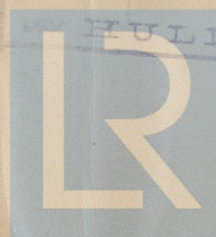

Lloyd's Register  
Foundation