

21. 8. 13.

MIDSHIP SECTION

STEEL SCREW TRAWLER

N° 590


DIMS 119'-0" B.P. x 22'-0" EXT. x 12'-9" MLD.

SCALE 1/2" INCH

TO CLASS 100-A1 STEAM TRAWLER

PLAN No. 3252.
FOR ENCLOSURE TO
Messrs Lloyd's Surveyors
FROM
COCHRANE & SONS, LTD.
SHIPBUILDERS, SEELY,
DATE 18/8/13. (B.W.)

DECK PLATED OVER IN WAY OF MACHINERY
E & B CASING AS PREVIOUSLY APPROVED.

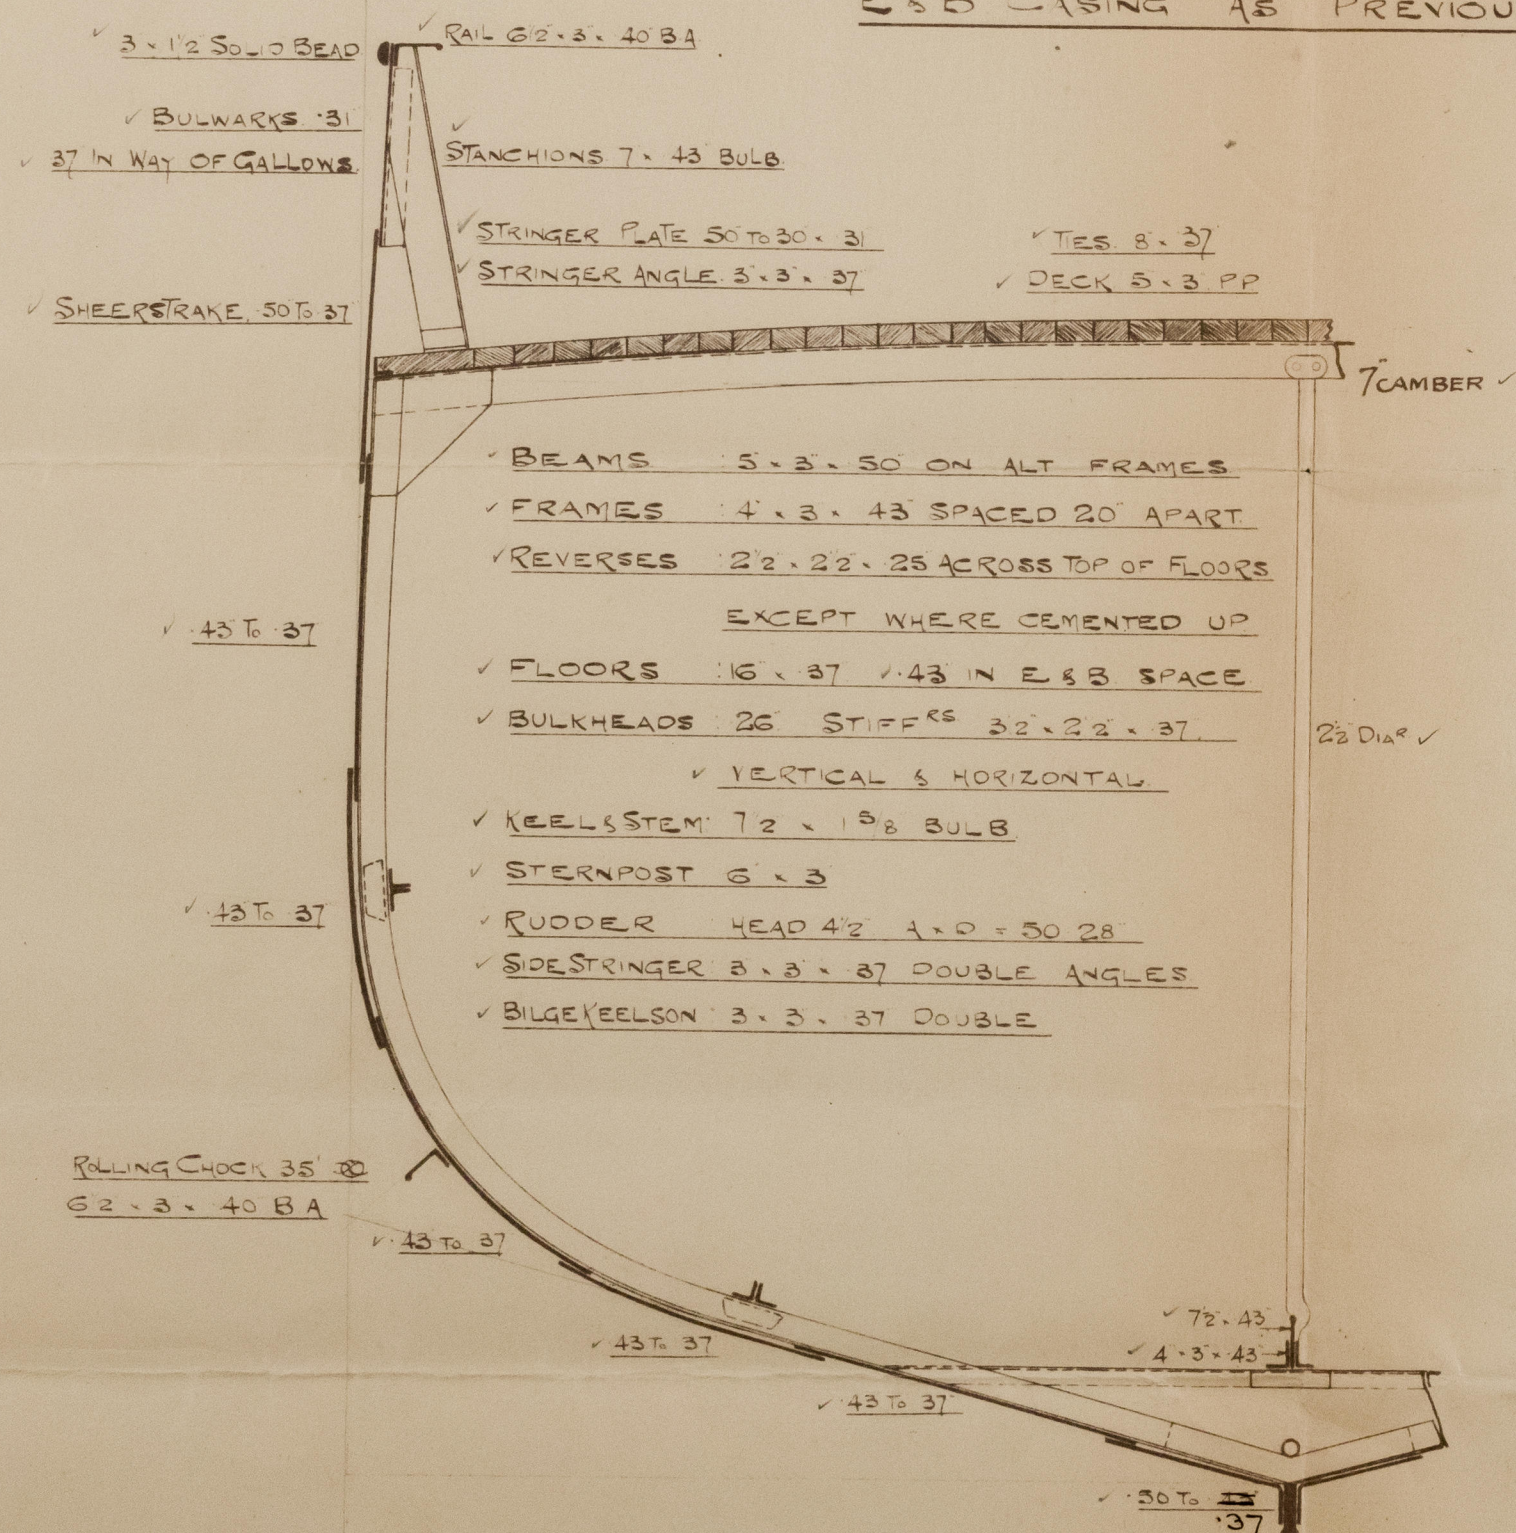

NUMERALS

B + D = 34 635

L x (B + D) = 4120 375

L = 11 41

EQUIPMENT

- ✓ 1 ANCHOR ✓ 5 1/4 CWTs EX STOCK OR 6 1/2 STOCKLESS
- ✓ 1 ✓ 4 3/4 " " " " ✓ 6 " " " "
- ✓ 1 ✓ 22 " " " " ✓ 22 " " " "
- ✓ 90 FATHOMS ✓ 1" STUPLINK CABLE
- ✓ 60 " ✓ 6" HAWSER
- ✓ 60 " ✓ 4 1/2" WARP

NEW.
19. 8. 13

RIVETING

- ✓ BUTTS OF GARBOARD & SHEERSTRAKE STRAPPED
- ✓ AND DOUBLE RIVETED. REMAINDER OF SHELL
- ✓ OVERLAPPED & DOUBLE RIVETED BULWARKS SINGLE RIV.
- ✓ LANDINGS DOUBLE RIVETED EXCEPT TOP EDGE OF
- ✓ SHEERSTRAKE WHICH IS TO BE SINGLE RIVETED
- ✓ RIVETS IN KEEL, STEM AND STERNFRAME 1" DIA.
- ✓ SHELL RIVETS ALL 3/4 DIA.

B.W.
21. 8. 13.




© 2021


Lloyd's Register
Foundation

W807-0116


Cochran & Son.
No 590.
Midships Section.
Dimensions.
119-0 x 21-87 x 12-75.

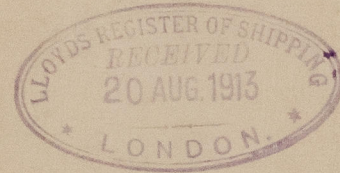

s/s 'Okino'
Hull Rpt No. 27166

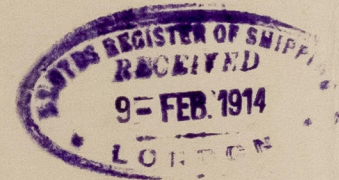

RETAIN

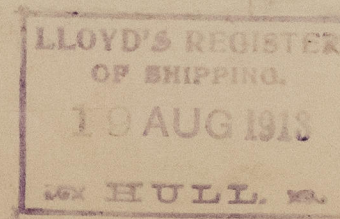

W807-0116



© 2021
Lloyd's Register
Foundation