

S.S.Nº 427.

DOLLARS THROUGHOUT TO
SURVEYORS SATISFACTION.



1949
 1948
connected to
concrete satisfaction

STYLE.
Pillars




außen
7.12.07

Cochran & Sons.

No 427

Profile & Deck Plan
s/s 'onward'

Hull Report No. 19990

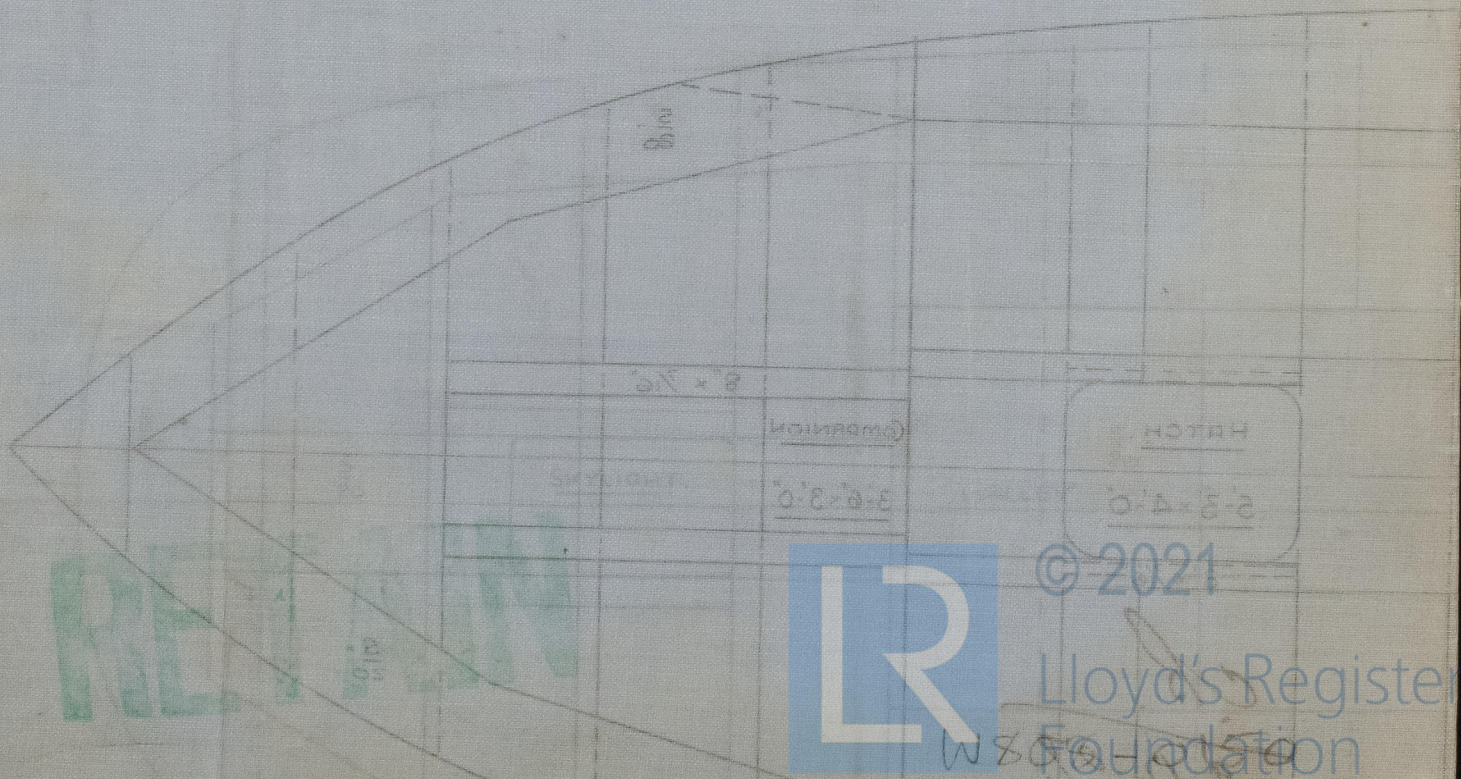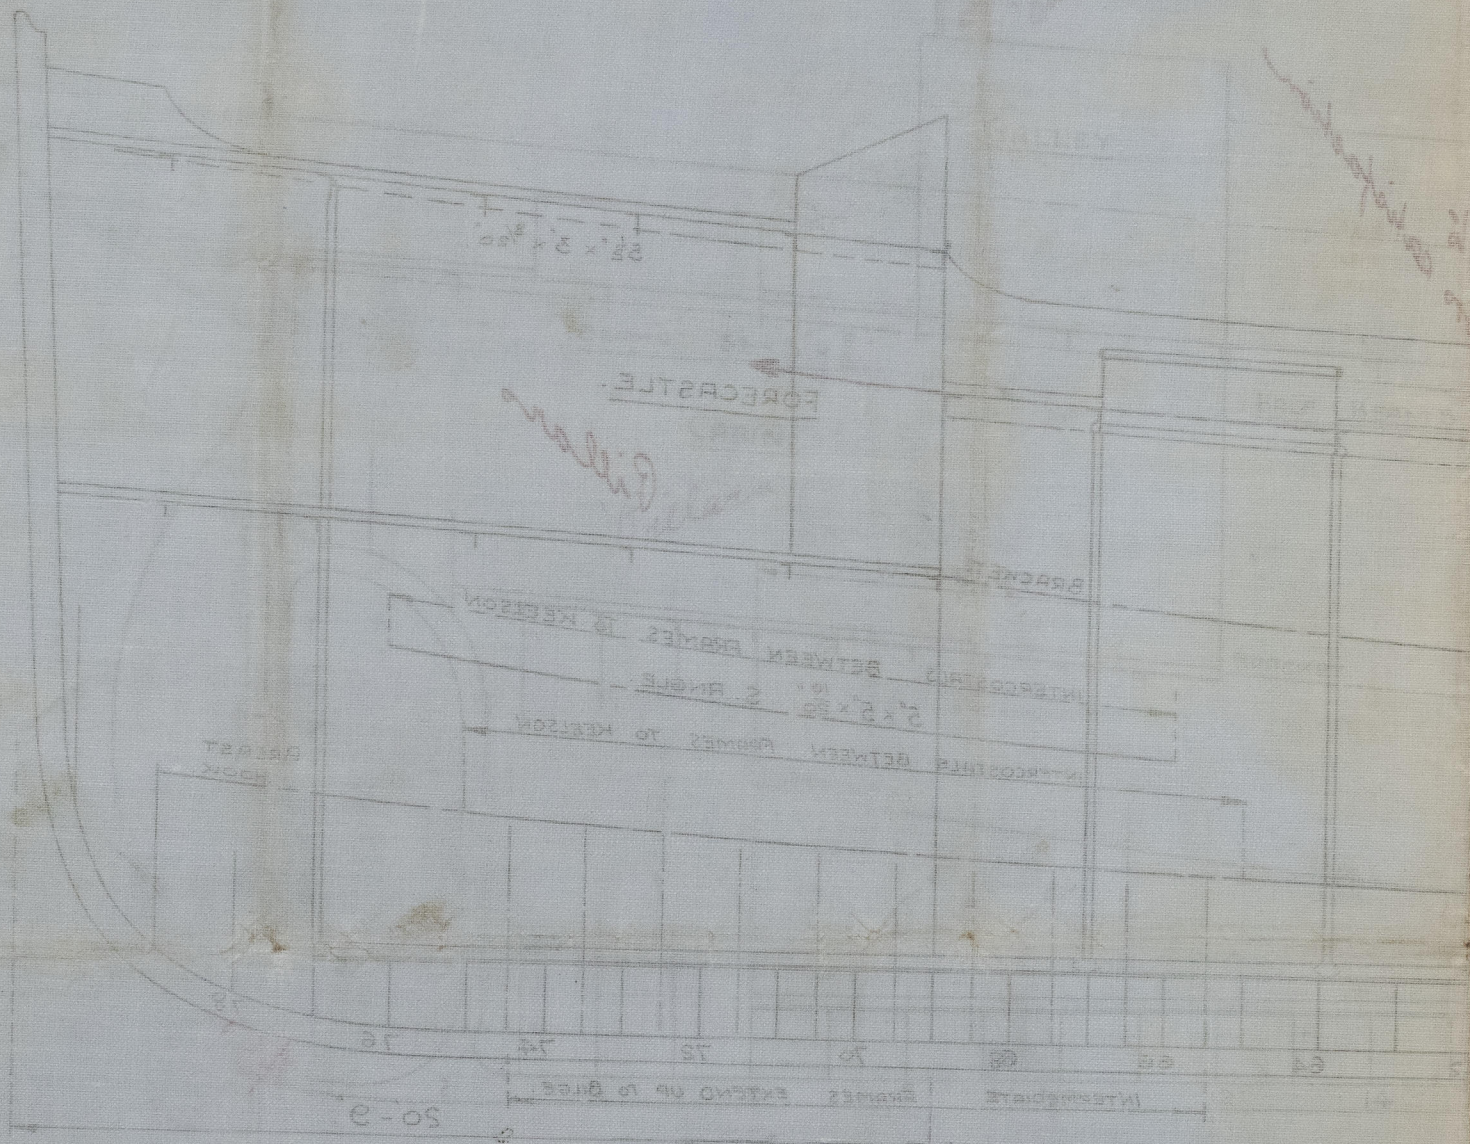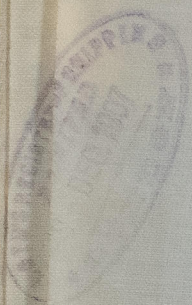

© 2021

Lloyd's Register
Foundation