

7.9.06

- N° 527 -



- PROFILE & DECK PLAN -

- DIMEN<sup>s</sup> 143'-4" BP X 23'-0" EX X 13'-4" M<sup>ED</sup> -

- CLASS -

- 100 A1 STEEL FOR FISHING PURPOSES -

- SCALE  $\frac{1}{4}$ " = 1 FOOT -

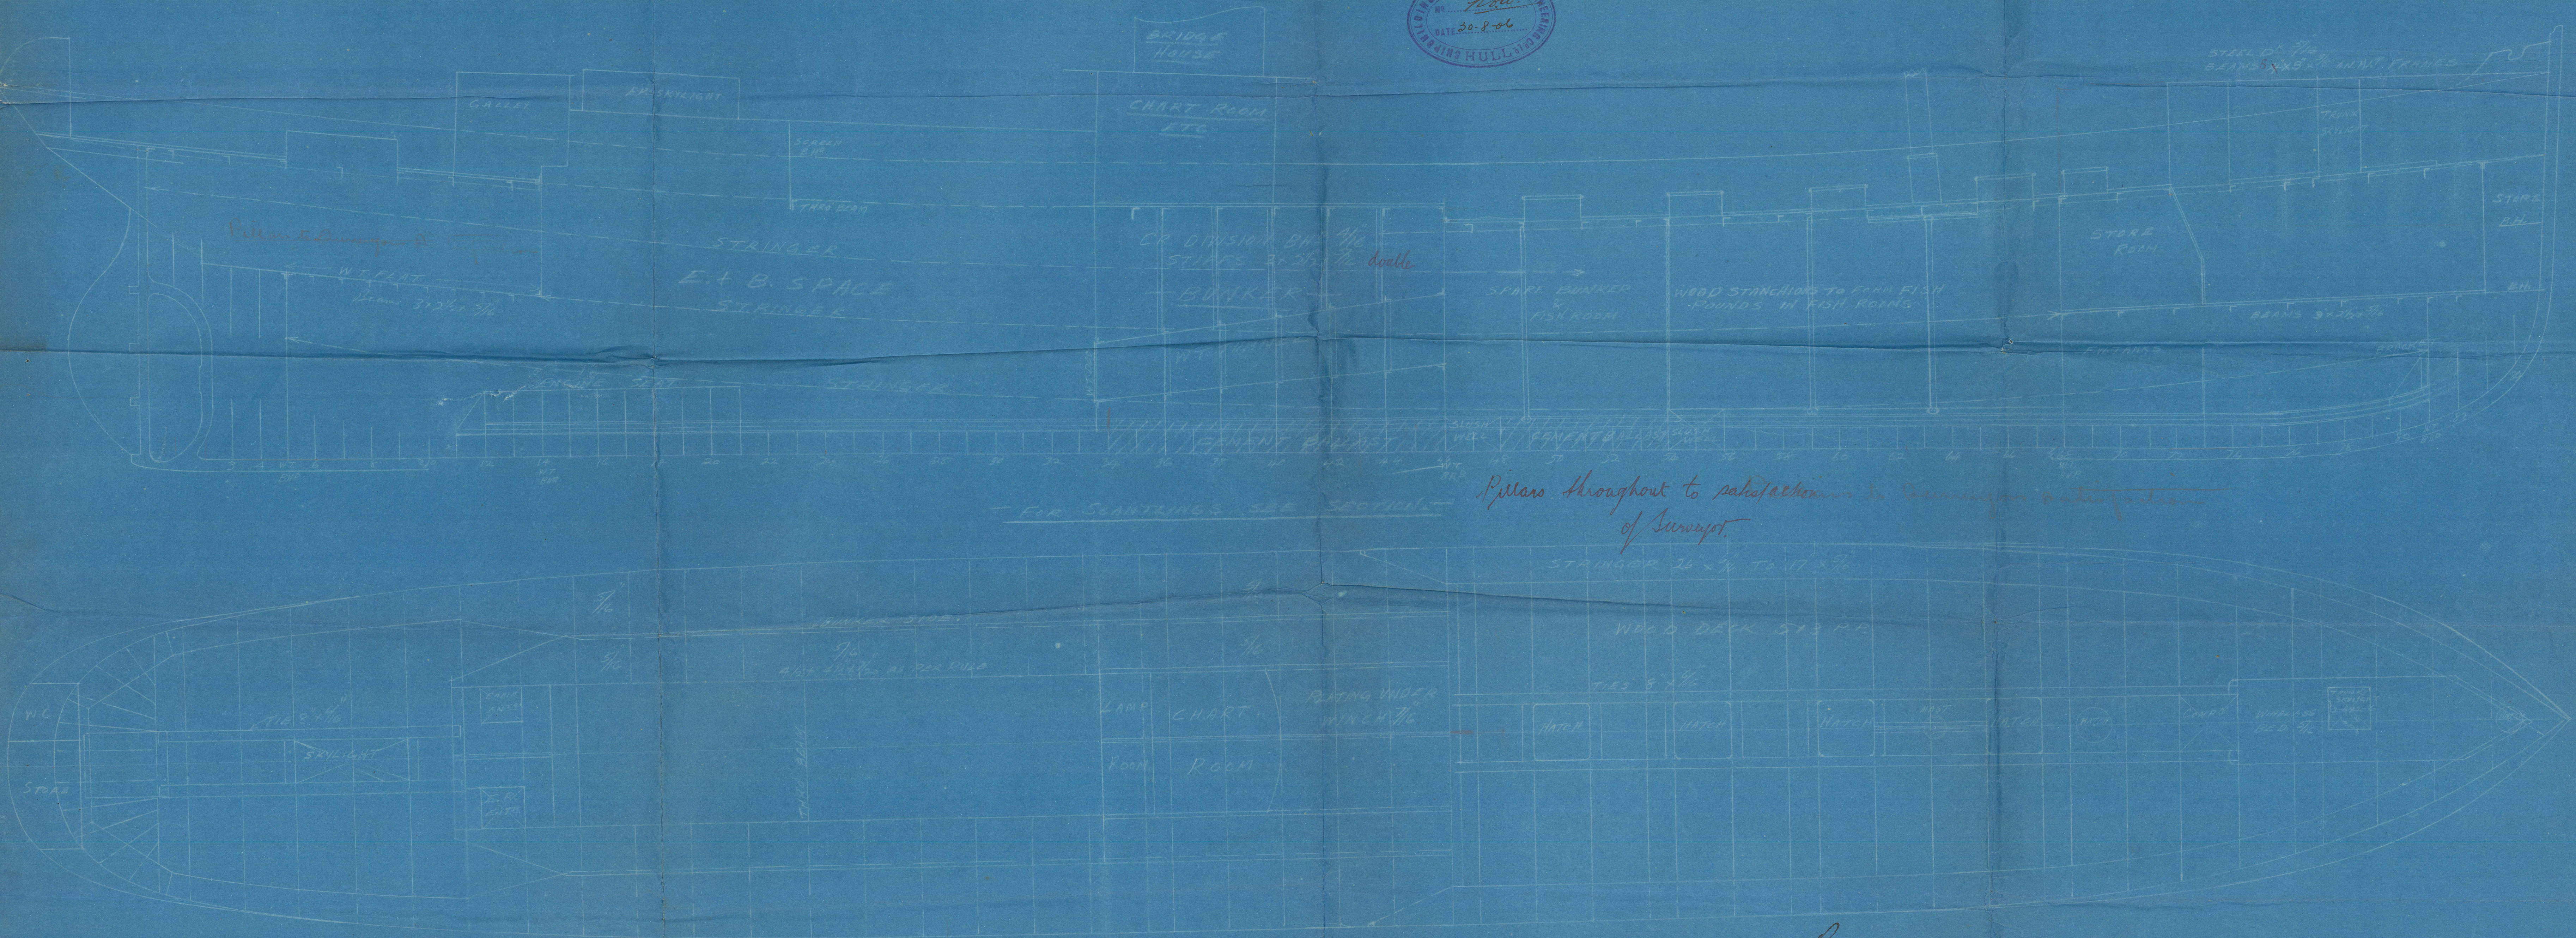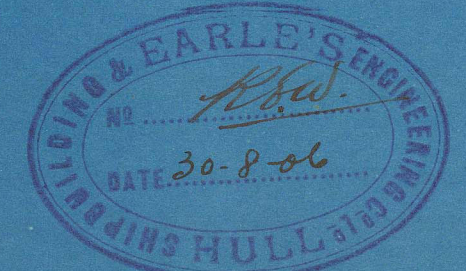


C.R.  
7.9.06.



*Amended.*  
Profile


No. 524

Sp. Onward Ho  
Hull Report No. 18853.



W808-0173

© 2021



Lloyd's Register  
Foundation