


# PROFILE

S.S. 345 x 47' 9" x 30'-2 1/2" (TO SPAR D<sup>2</sup>)

SCALE 1/8" = ONE FOOT.

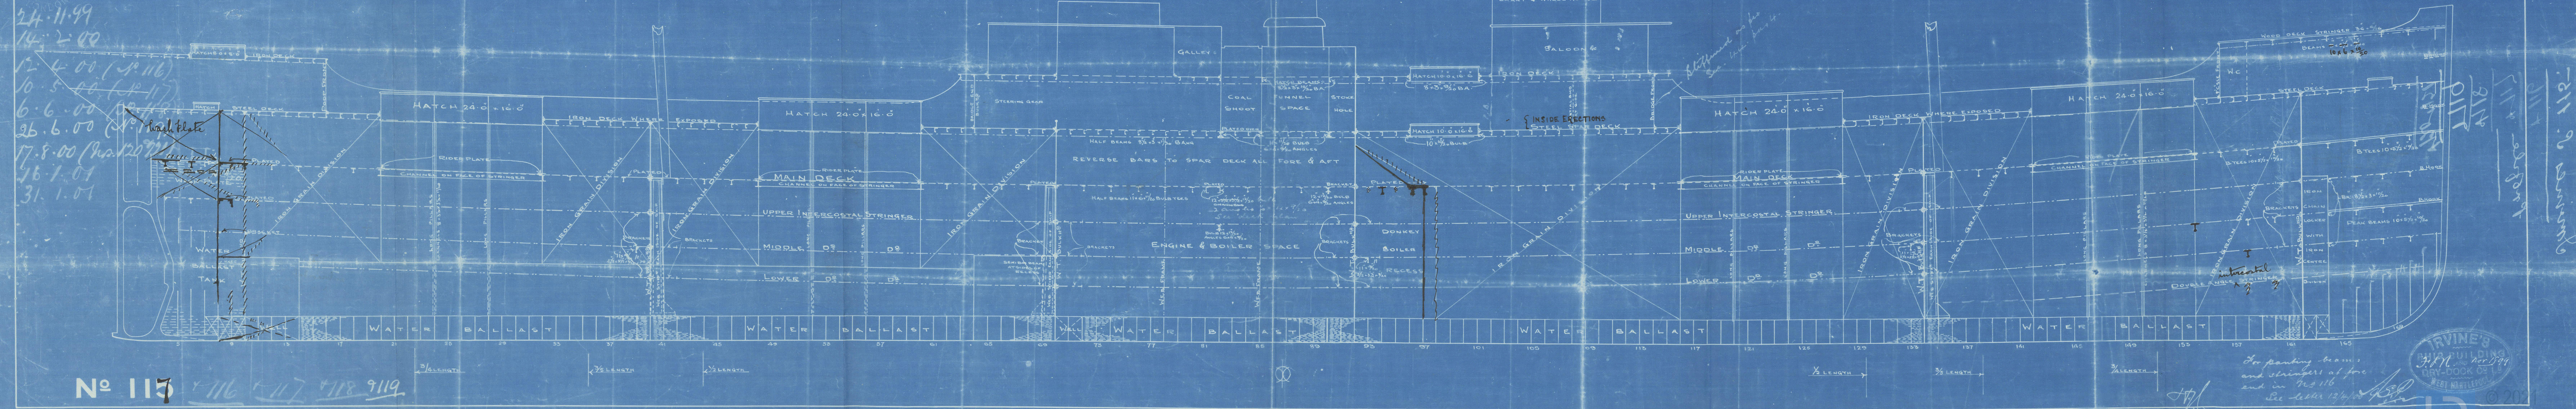

N<sup>o</sup> 117

IRVINE'S  
SHIP BUILDING  
J.M. 12/1/99  
DRY-DOCK ON L<sup>y</sup>  
WEST HARTLEPOOL

For painting beams  
and stringers at fore  
and in No 116  
See letter 12/1/99

IRVINE'S  
SHIP BUILDING  
J.M. 12/1/99  
DRY-DOCK ON L<sup>y</sup>  
WEST HARTLEPOOL

© 2021  
Foundation



Irwin's F.B. by Docks Co

No. 117

Profile

"Polamtiell"

Hpl. Report No. 11476

RETAIN



© 2021

Lloyd's Register  
Foundation

W809-0183