

PLAN No. 264
FOR ENCLOSURE TO
Messrs Lloyd's Surveyors
Hull FROM
COCHRANE & SONS,
SHIPBUILDERS, SELBY.
DATE 4/5/11 *RR*

MIDSHIP SECTION


STEEL SCREW TRAWLERS

N^{OS.} 480-1

DIM^S - 126'-8" x 22'-0" M^{LD}. x 12'-6" M^{LD}.

SCALE 1/2" = 1 FOOT

TO CLASS 100.A.1. FOR FISHING PURPOSES. DECK PLATED OVER
IN WAY OF MACHINERY SPACE. ENGINE & BOILER CASING AS
PREVIOUSLY APPROVED.

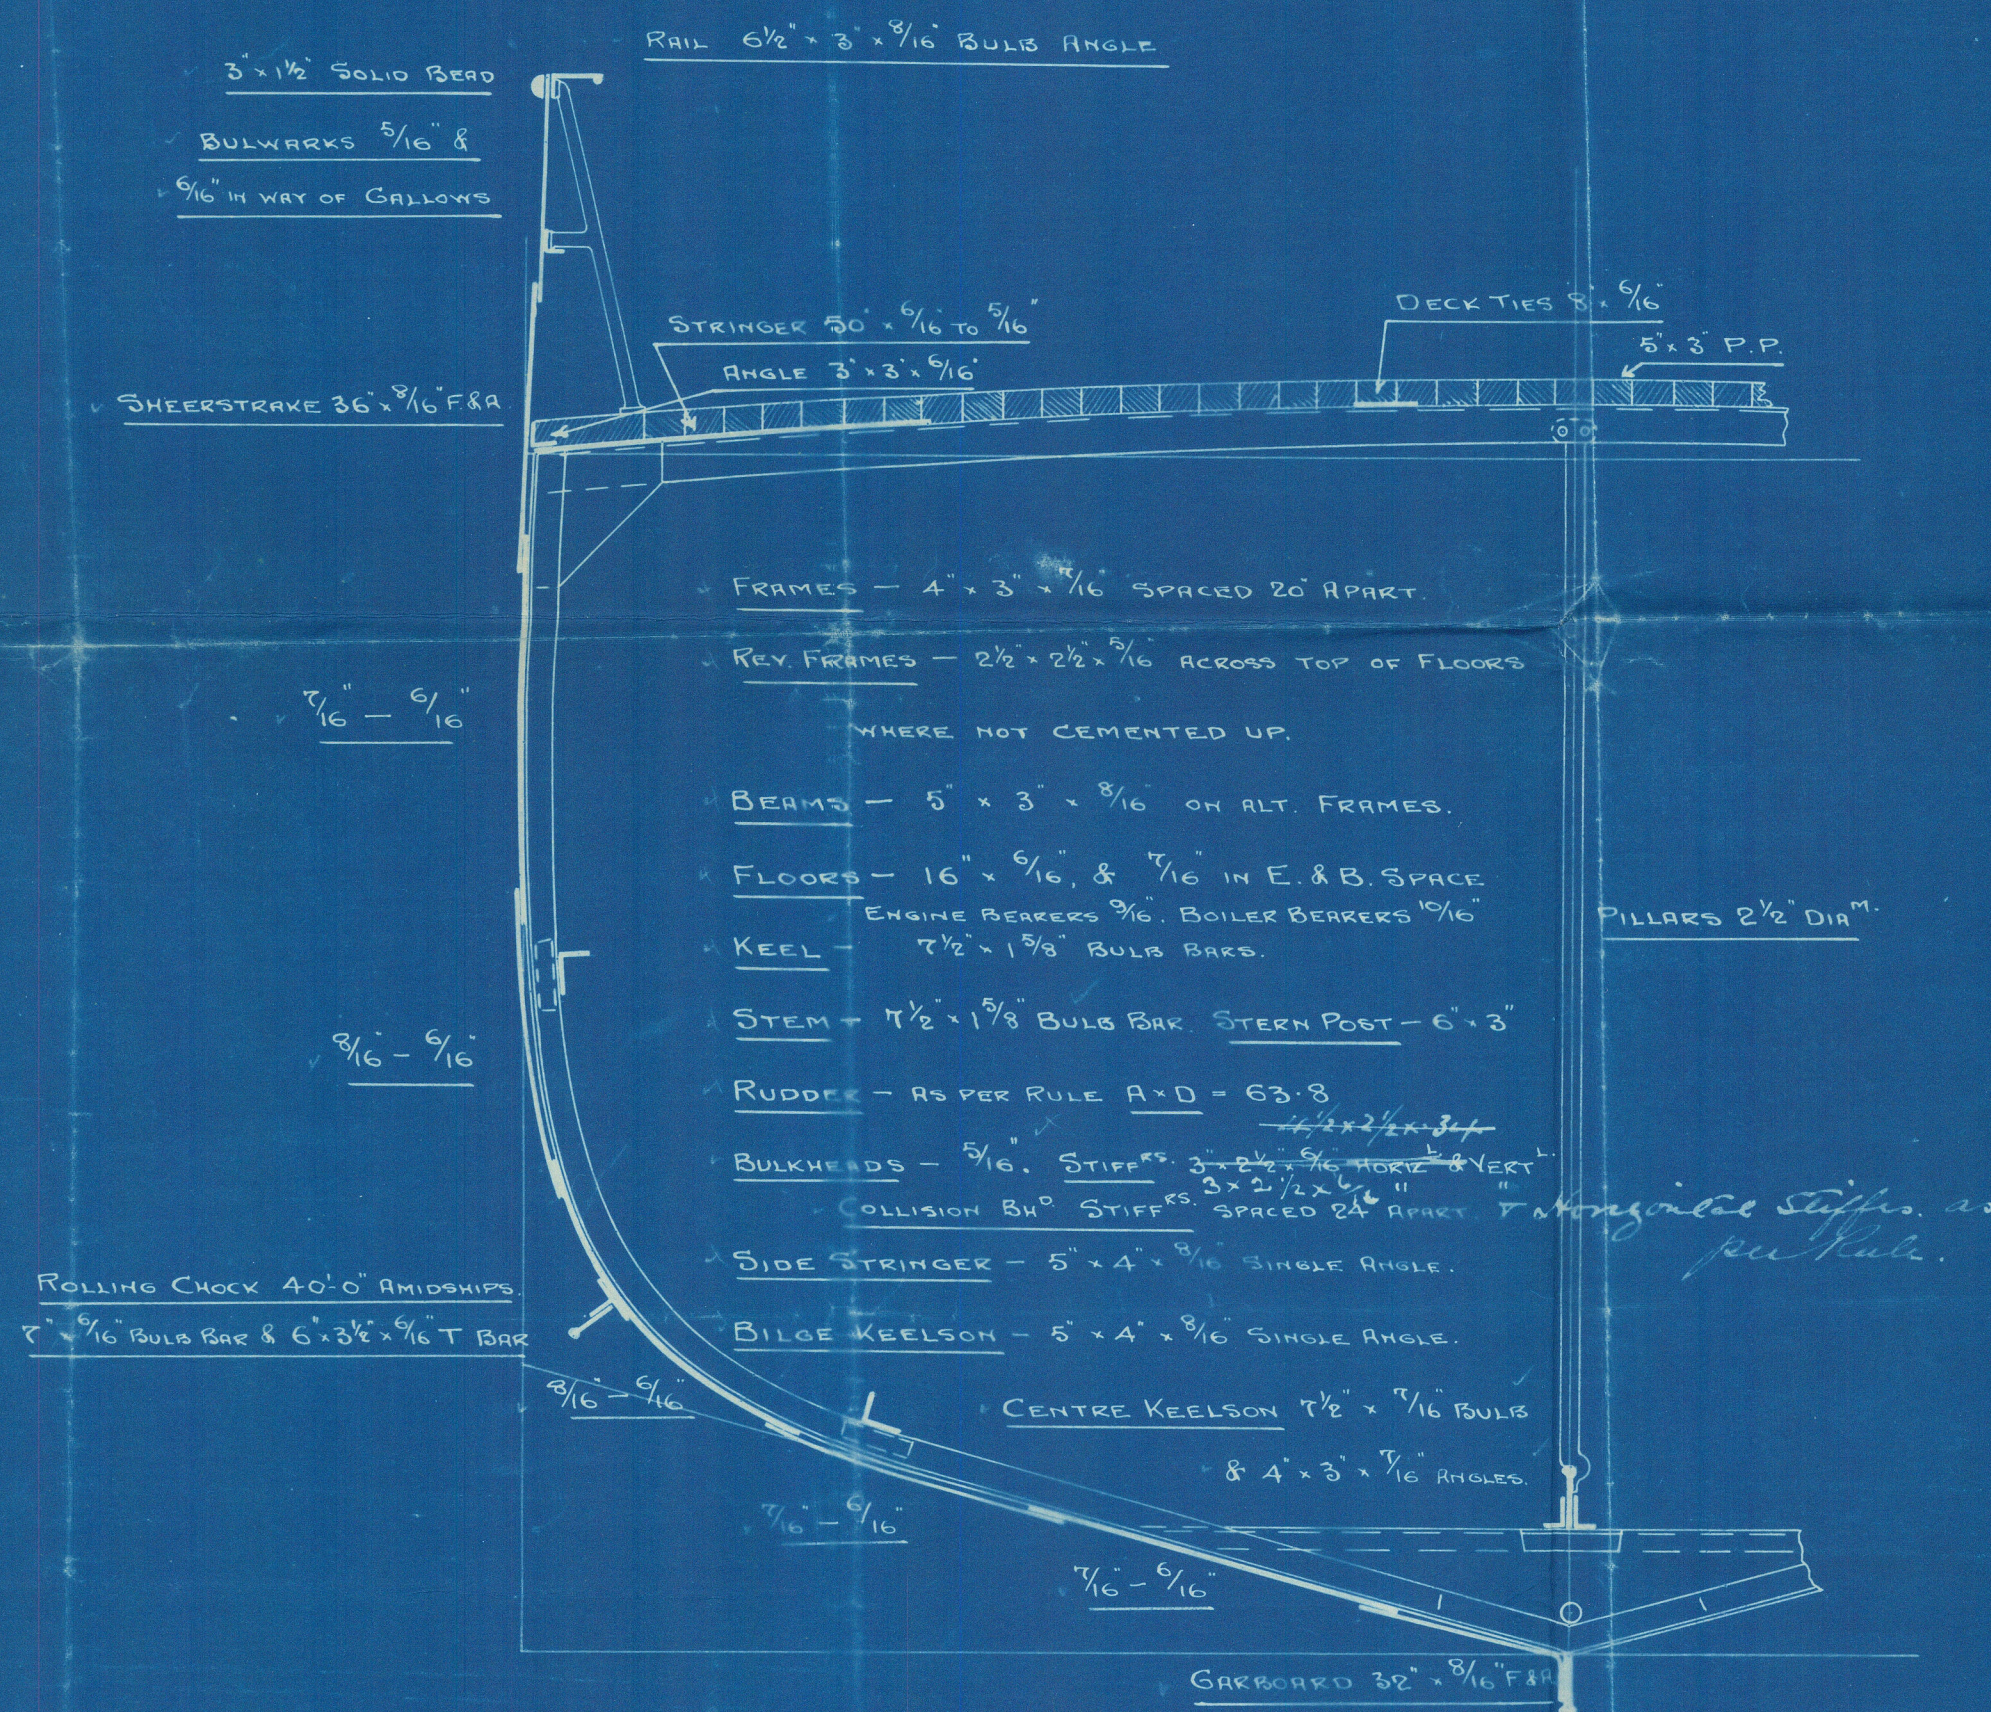

NUMERALS

$$B + D = 34.5$$

$$L \times (B + D) = 4369.77$$

PROPORTIONS

$$\frac{L}{D} = 10.04$$

$$\frac{L}{B} = 5.75$$

EQUIPMENT

| | | |
|------------------|--------------|----------------------------|
| 1ST BOWER ANCHOR | 5 1/2 CWTSEX | STOCK OR 10 CWTs STOCKLESS |
| 2ND " | 5 | " " 6 1/4 " " |
| KEDGE ANCHOR | 2 3/4 | " " " " |
| 105 FATHOMS | 1 1/16 | CABLE |
| 60 " | 6 | HAWSER |
| 60 " | 4 1/2 | WARP |

RIVETING

BUTTS OF SHELL PLATING LAPPED & DOUBLE RIVETED
EXCEPT GARBOARD, SHEERSTAKE & STRAKE NEXT TO
SHEERSTAKE, WHICH ARE TO BE STRAPPED AND DOUBLE
RIVETED. LANDINGS DOUBLE RIVETED EXCEPT TOP EDGE
OF SHEERSTAKE, WHICH IS TO BE SINGLE RIVETED.
BUTTS OF STRINGER PLATE OVERLAPPED & DOUBLE RIVETED.






Lloyd's Register
Foundation

W810-0090

Cochrane & Sons

N^o 480-481.

Duplicate.
Midship Section.

of Persimow
Hull Report No. 23649

RETAIN

W810-0090



© 2021

Lloyd's Register
Foundation