

27.10.10  
14.11.10

PLAN No. 265  
FOR ENCLOSURE TO  
Messrs. Lloyd's Surveyors  
Hull FROM  
COCHRANE & SONS,  
SHIPBUILDERS, SELBY.  
DATE 4/2/11. RK

# PROFILE & DECK PLAN



STEEL SCREW TRAWLERS

N<sup>o</sup>. 480-I

DIM<sup>s</sup> - 126'-8" x 22'-0" M<sup>LD</sup> x 12'-6" M<sup>LD</sup>.

SCALE 1/4" = 1 FOOT.

1721  
Messrs. Lloyd's Surveyors  
Hull

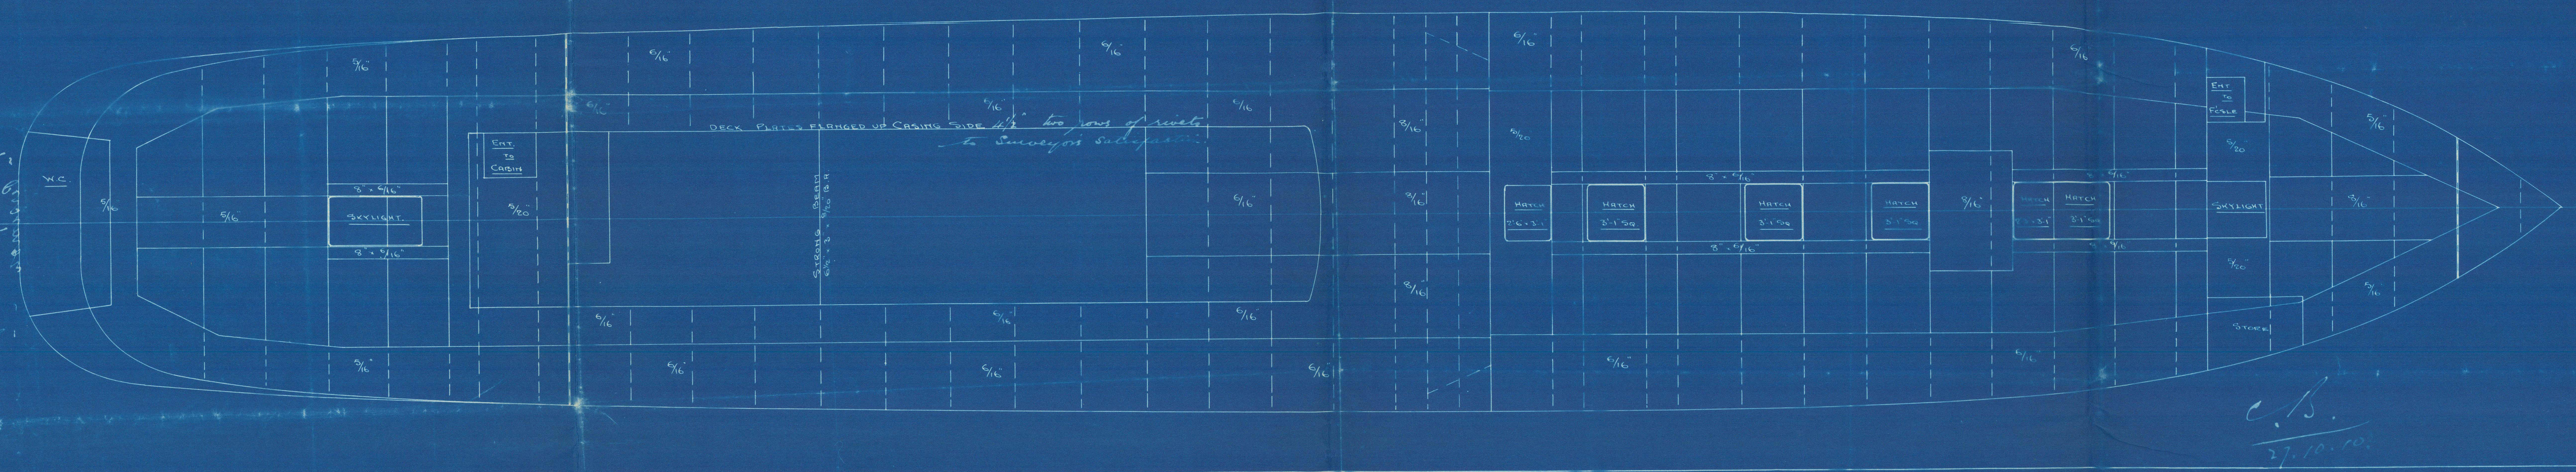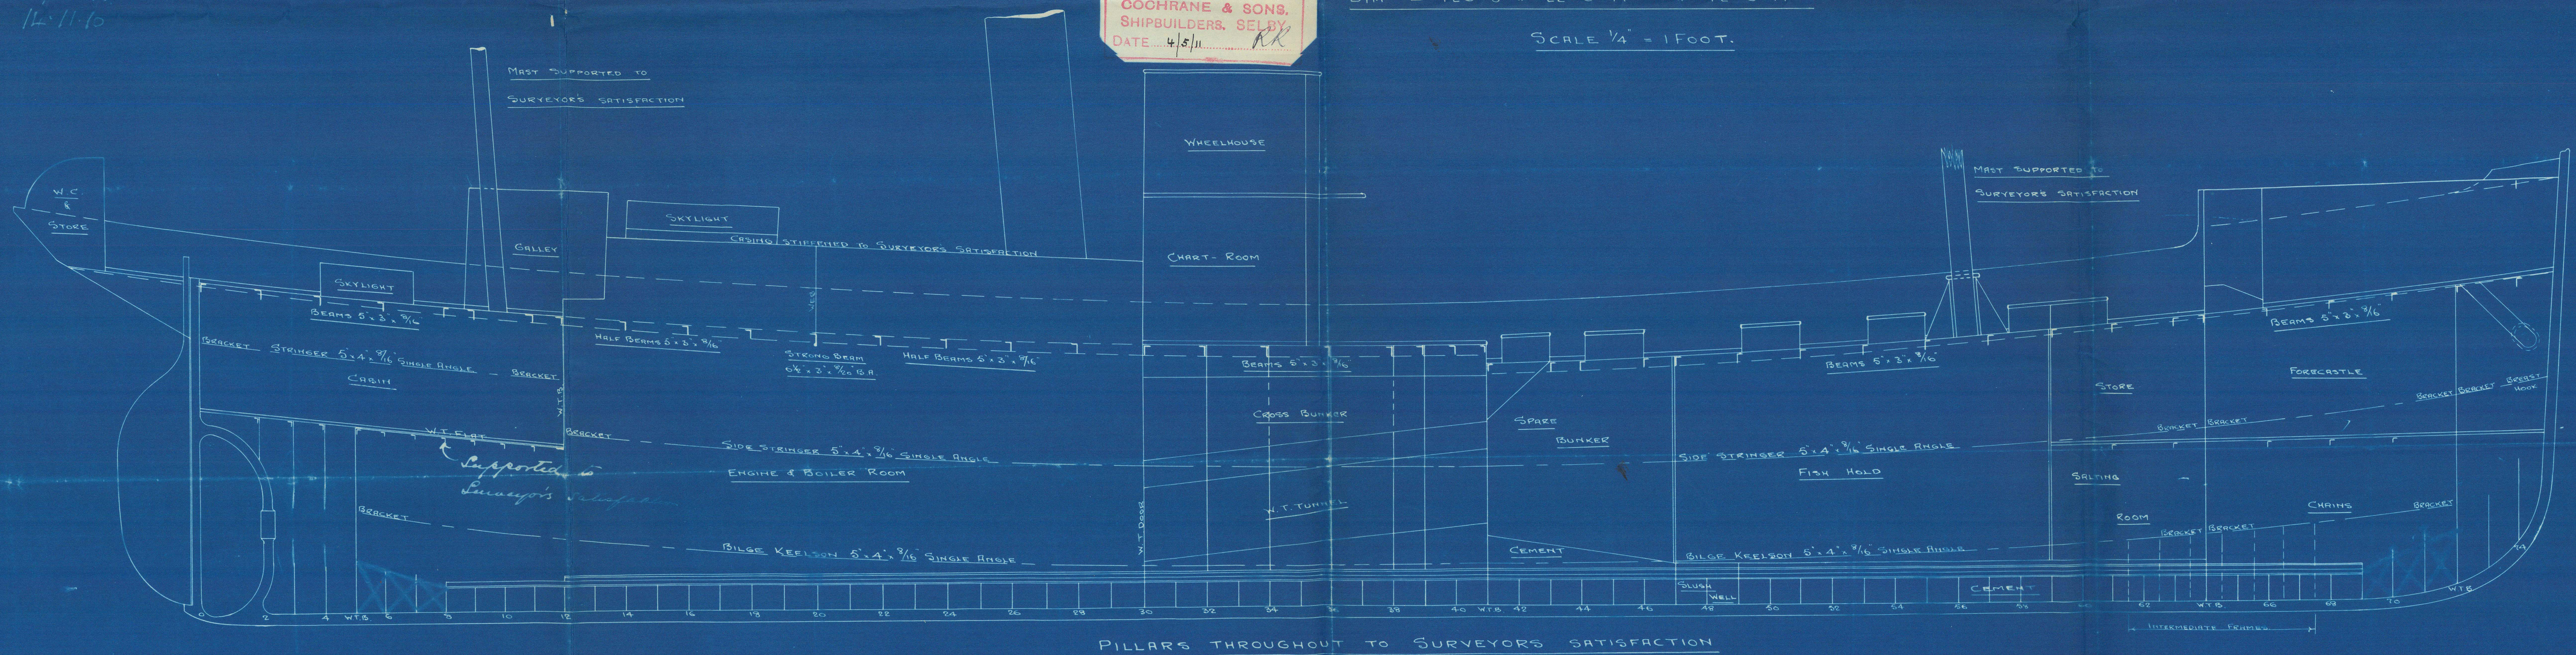

COCHRANE & SONS  
SHIPBUILDERS  
SELBY

C.B.  
27.10.10.



W810-0091

Cochran + Sons.

N<sup>o</sup> 480-481

Profile & Deck plan.  
<sup>Duplicate.</sup>

s/s Persimmon

Hull Rpt n. 23649

RETAIN



© 2021

Lloyd's Register  
Foundation