


— Heating Surface —	
Tubes	950 sq. feet
Combustion chambers	185 " "
Furnaces	99 " "
Tube plates	59 " "
Total Heating Surface	1293 " "
Grate area 4'-6" Furnaces	41.5 " "

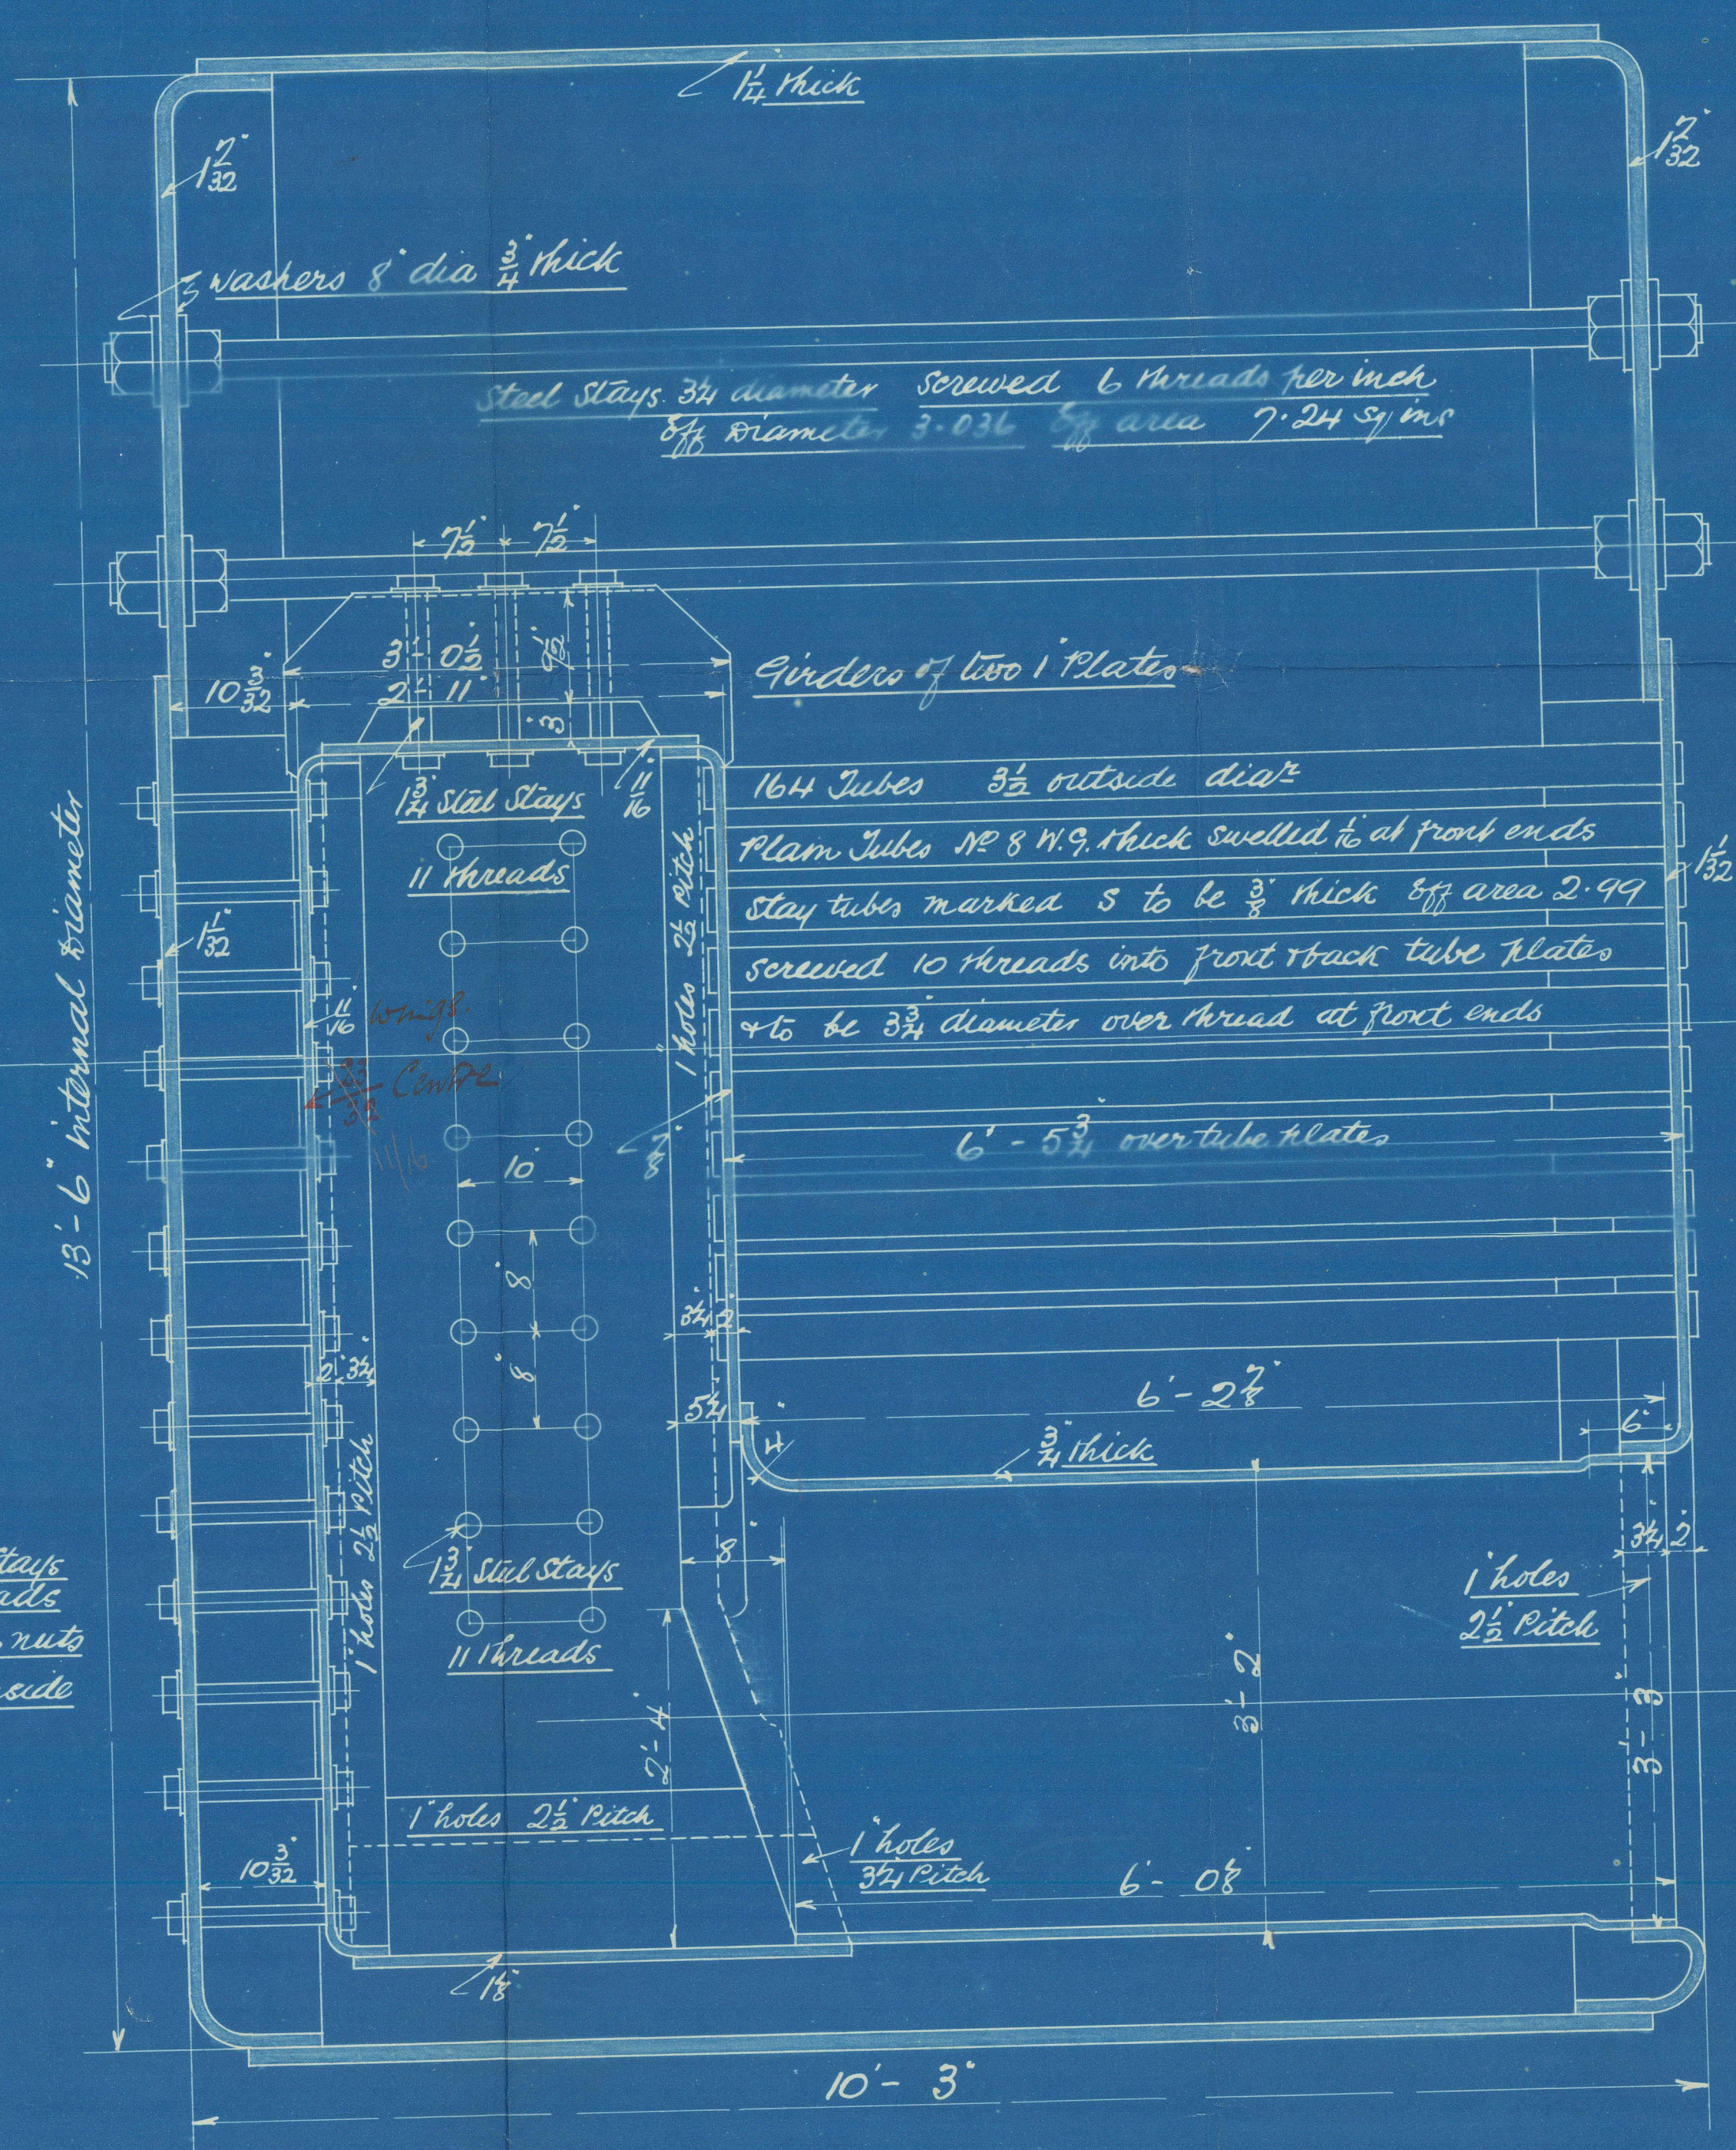


Nº A7S

Boiler A 78.

for S/s Persimmon.

Gr Central Co-op Eng?
& Ship Repair? Co Ld

GRIMSBY.

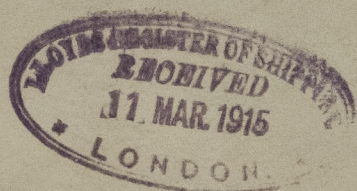

Persimmon

RETAIN



© 2021

Lloyd's Register
Foundation