

1-10-00


Nº 23 & 24

CARGO STEAMERS WITH ONE DECK
OF STEEL AND ONE SCREW


LENGTH BETWEEN PERPS. 279'-10 $\frac{1}{2}$ "
BREADTH MOULDED 39'-0 $\frac{1}{2}$ "
DEPTH MOULDED 21'-8"
ROUND OF BEAM 0'-9 $\frac{1}{2}$ "

SCALE $\frac{1}{100}$


LONGITUDINAL SECTION

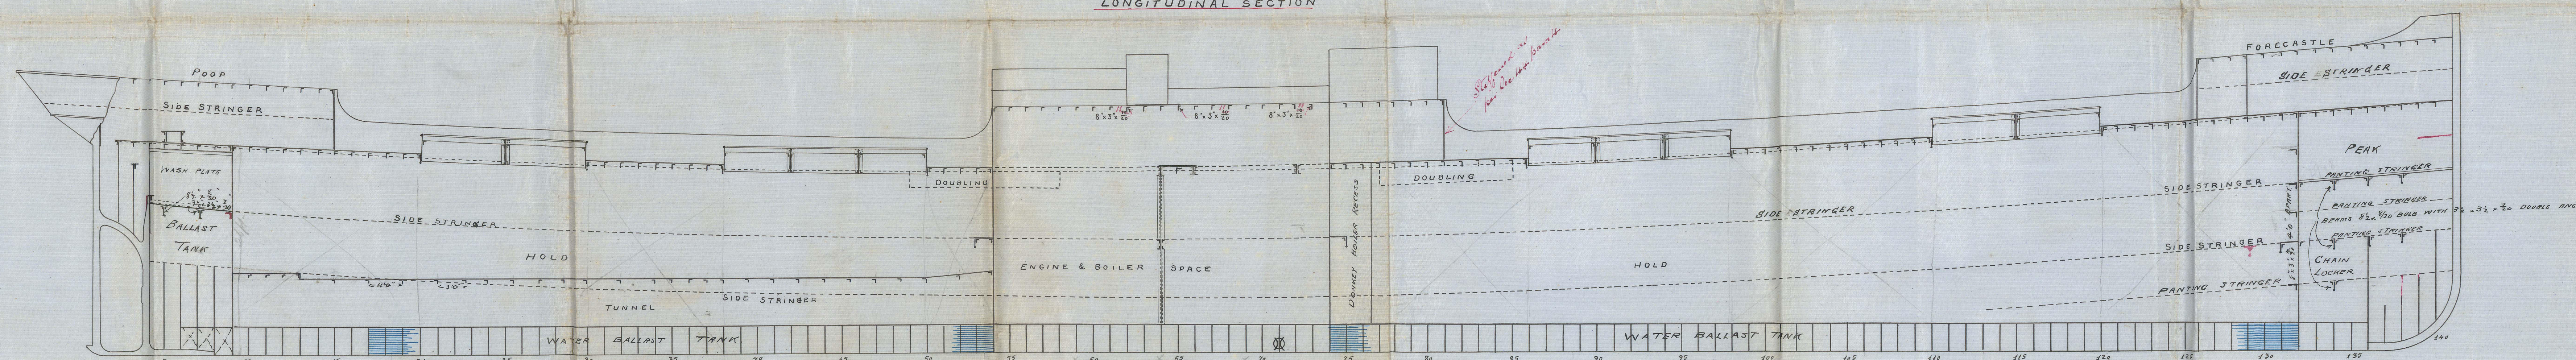

DECK PLAN

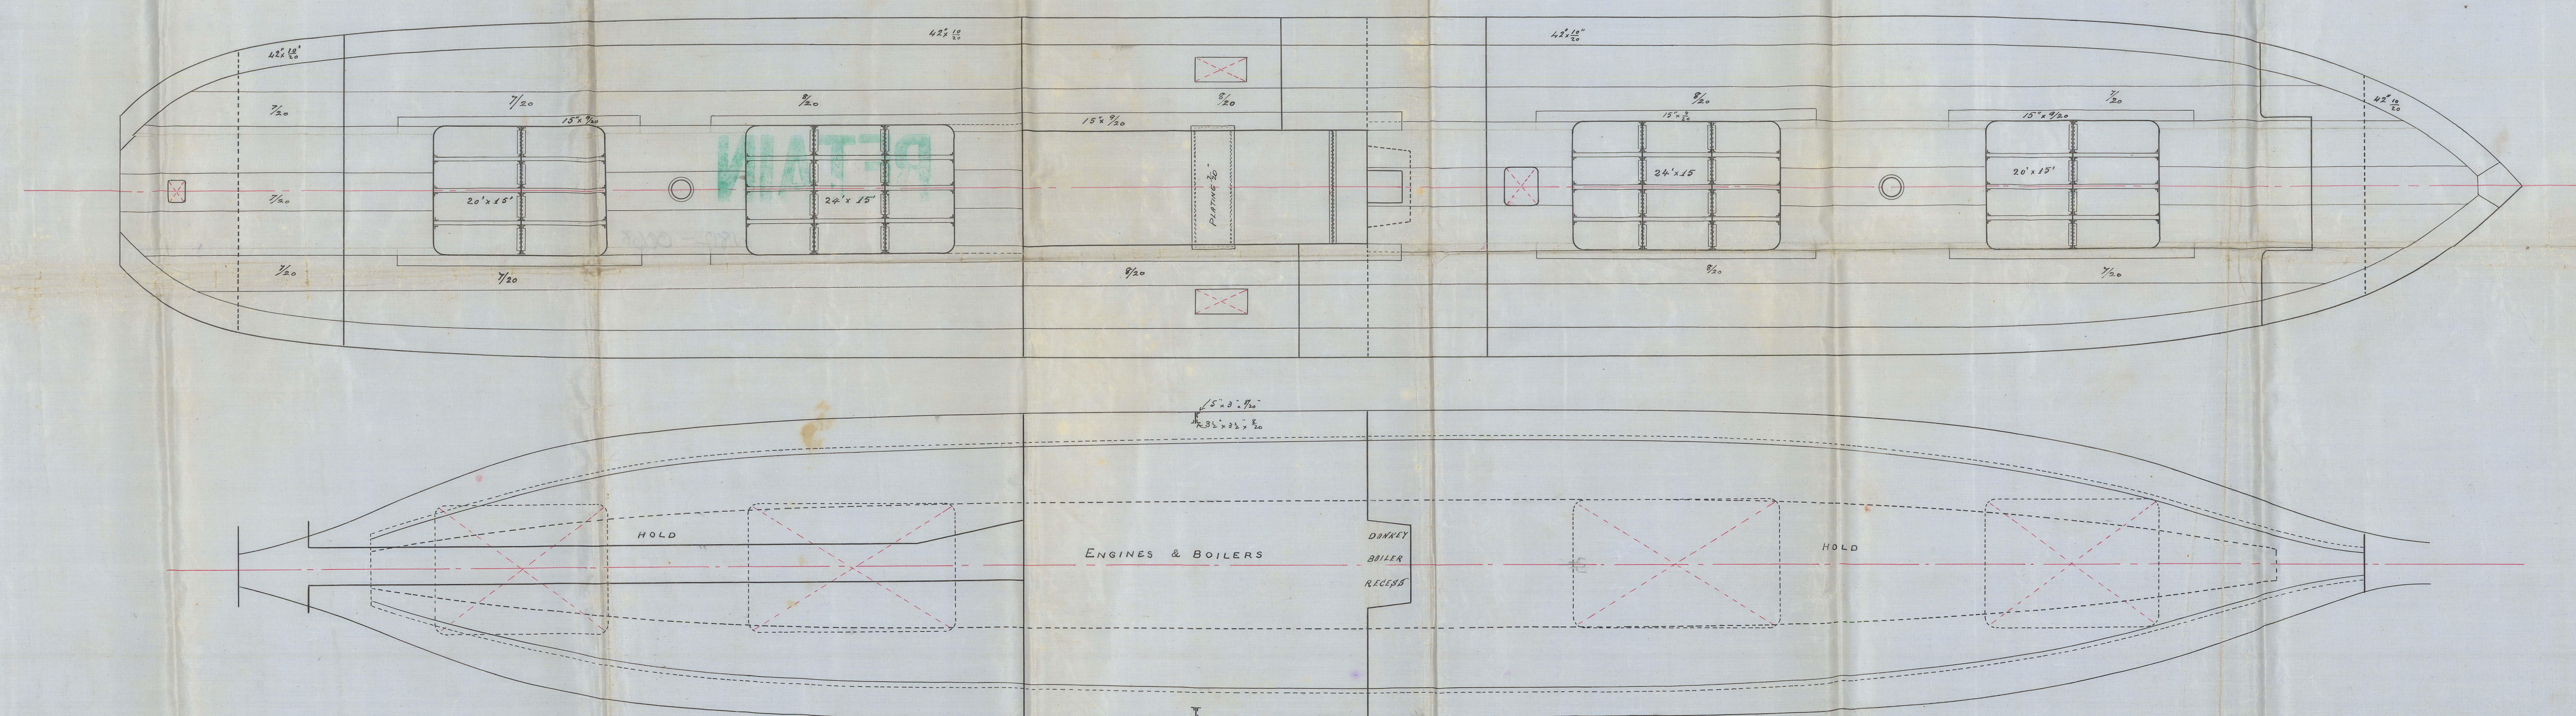


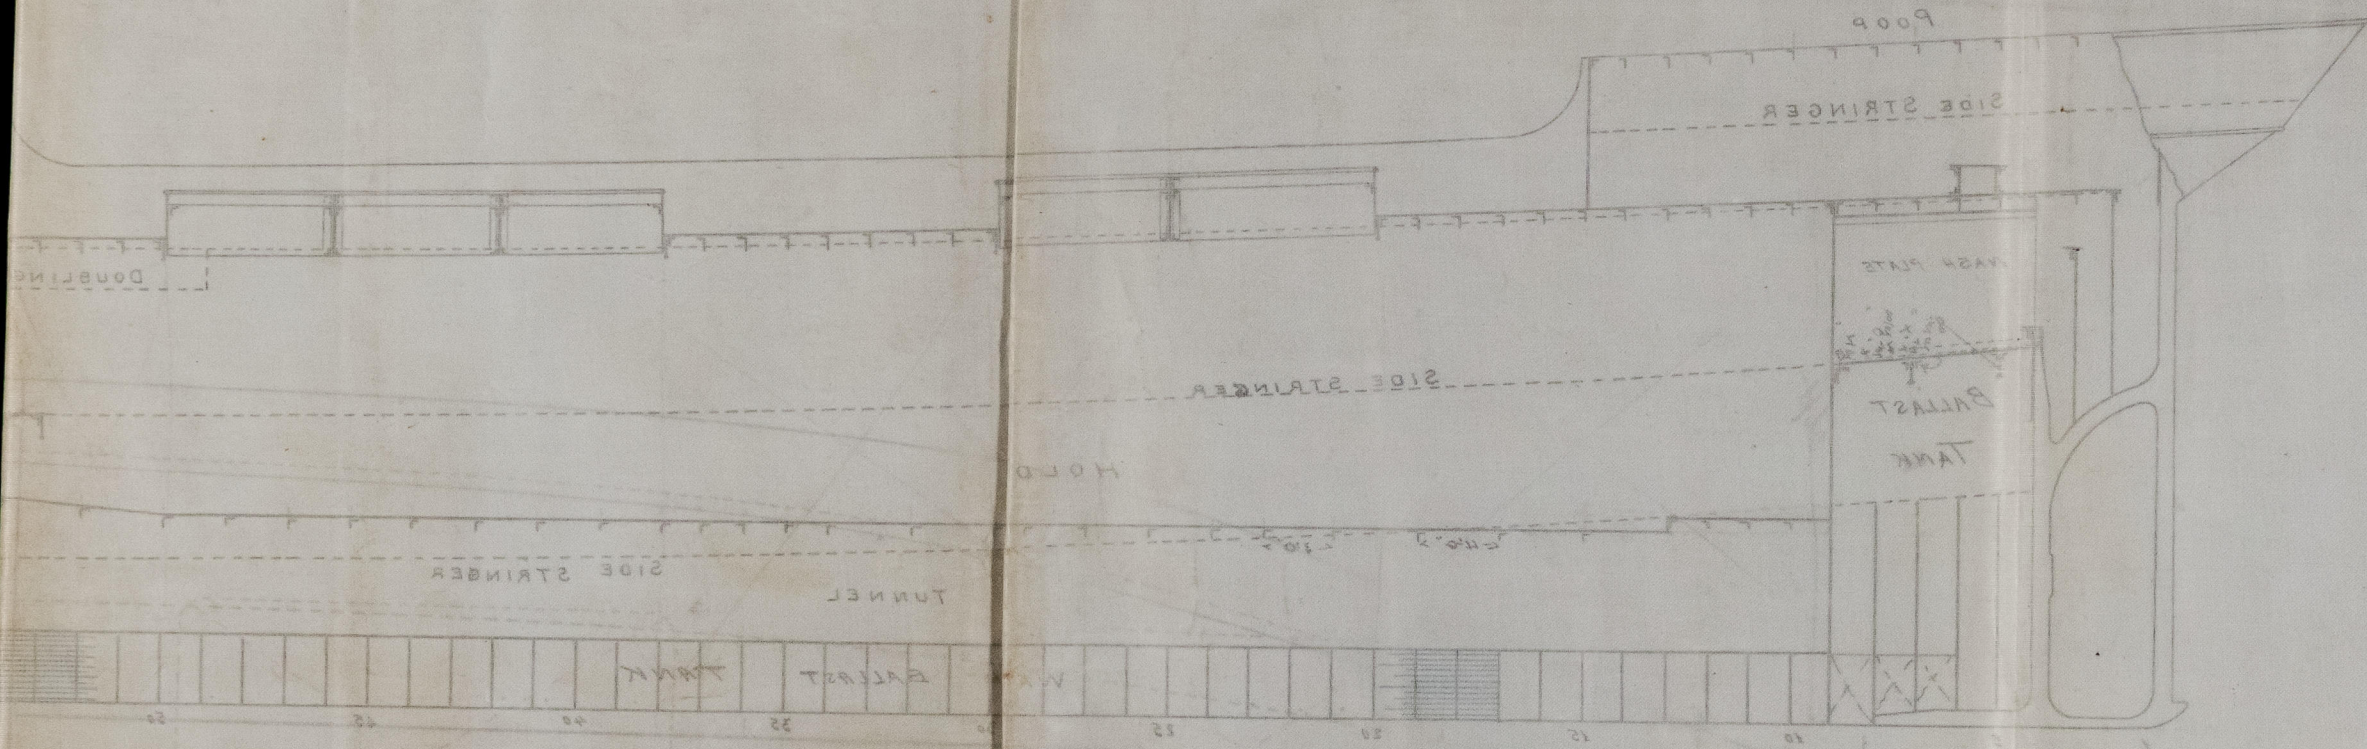

27 SEP 1930
LONDON

RETAIN

W812-0068

50' x 12'



© 2021
Lloyd's Register
Foundation