


From Feb. to 1830  
 Standing with 8100  
 Rapidities 1400  
 The whole is 9500

12:10:07

HOWALDTSWERKE  
KIEL.  
Nr 18188 d. 8.10.07  
EIGENTUMS- & VERVIelfÄLTIGUNGSRECHT VORBEHALTEN



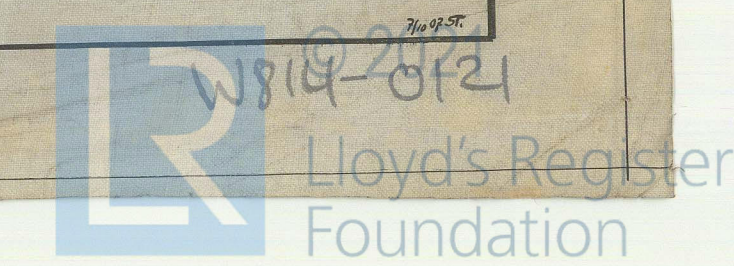


S. S. „Johanne“

Howaldswerke steamer N<sup>o</sup> 486

Longitudinal Plan

Hamburg Letter 8/10/04

Ham Rept. No 10304

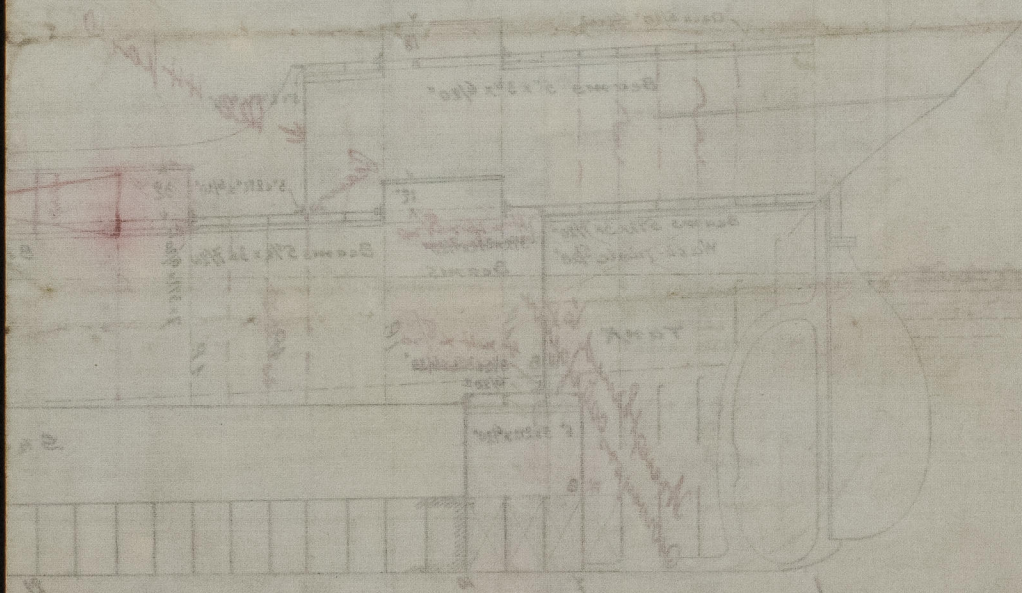

RETAIL



© 2021

Lloyd's Register  
Foundation

W814-0121