




14.2.11
6.9.11

See San Arthur & Sir Francis
No 254-5.

— No 258 —
ARRANGEMENT OF HATCHES —
SCALE 8" = 1 FOOT




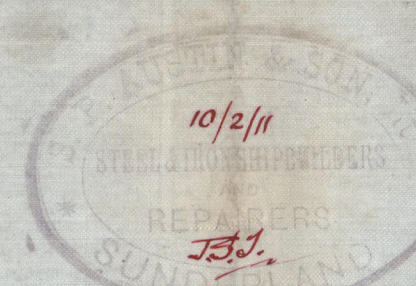


DECK PLAN

14.2.11

87591

Spec. for 1st class
passenger
cabin

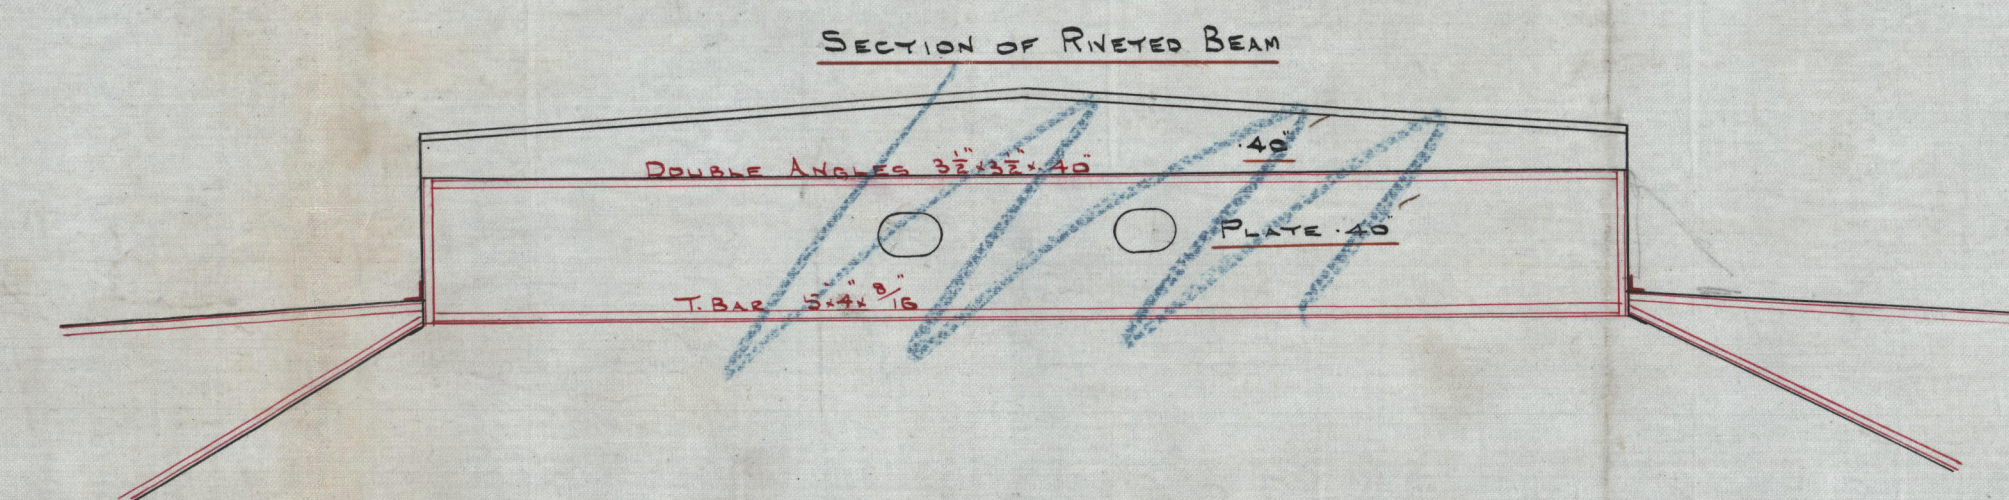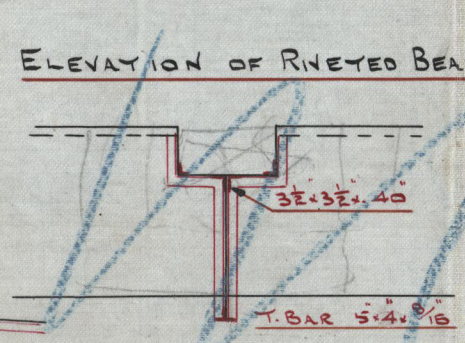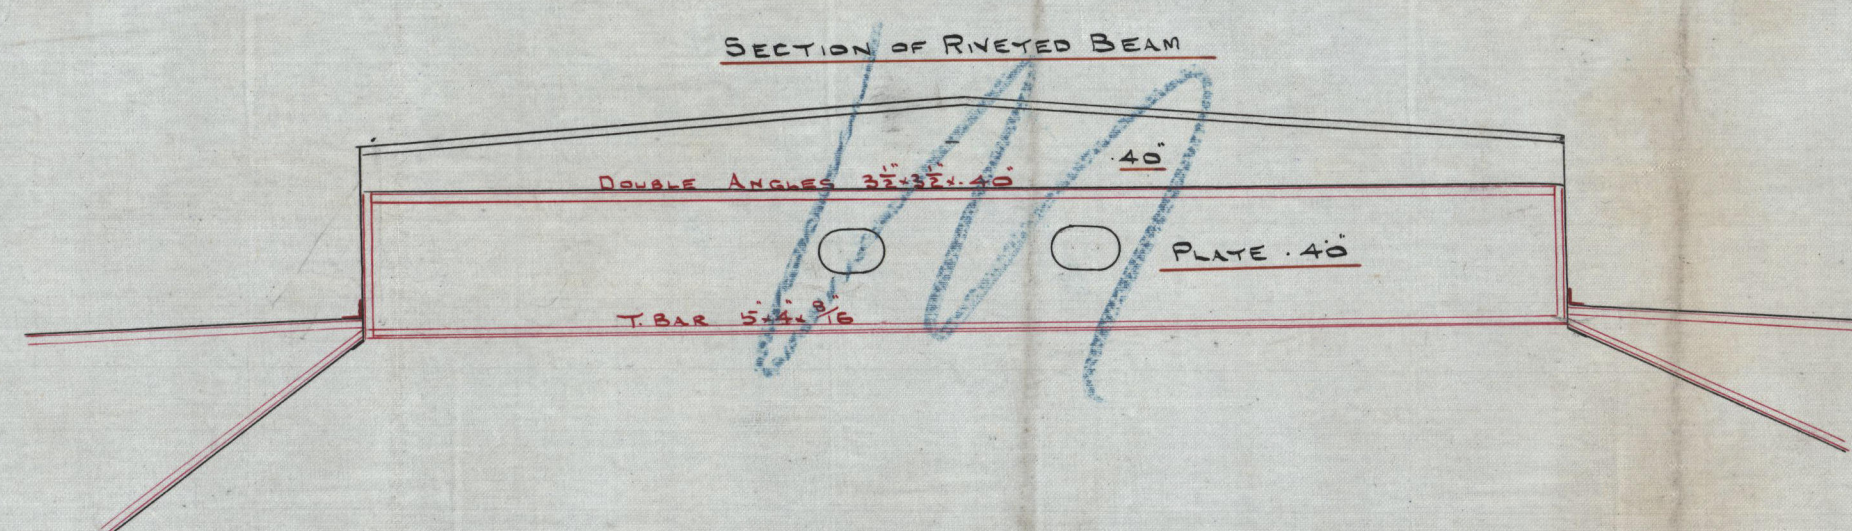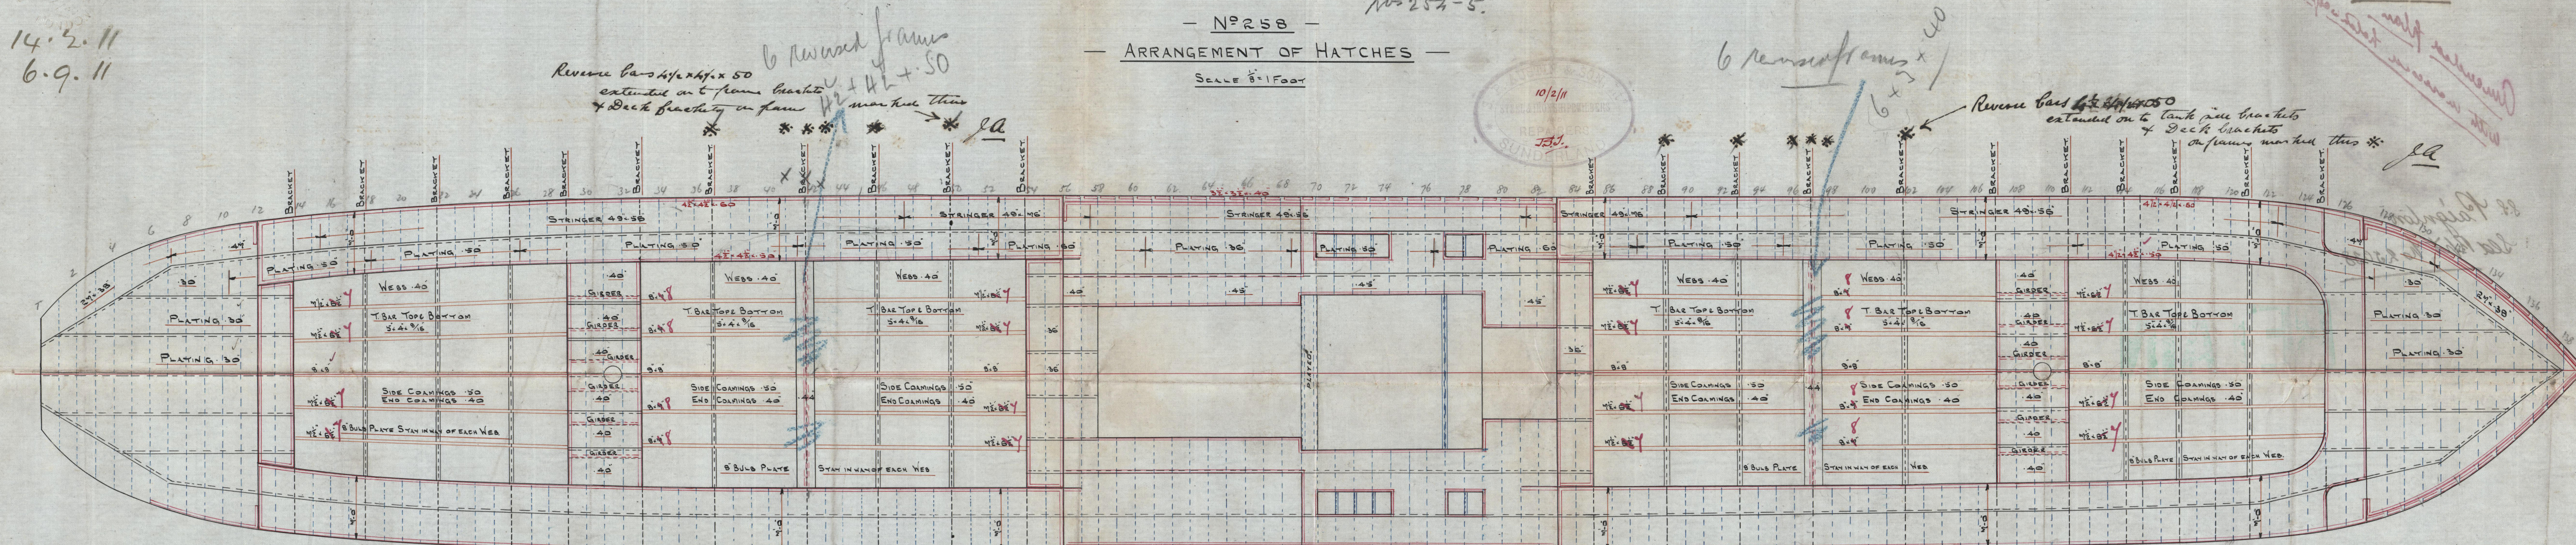

C.F.
14.2.11



W916-0041


DECK PLAN

My: S. P. Austin & L

Nº 258

*Amended plan
with measure holdways*

S. P. Paignton
Sea Rpt No 25038.

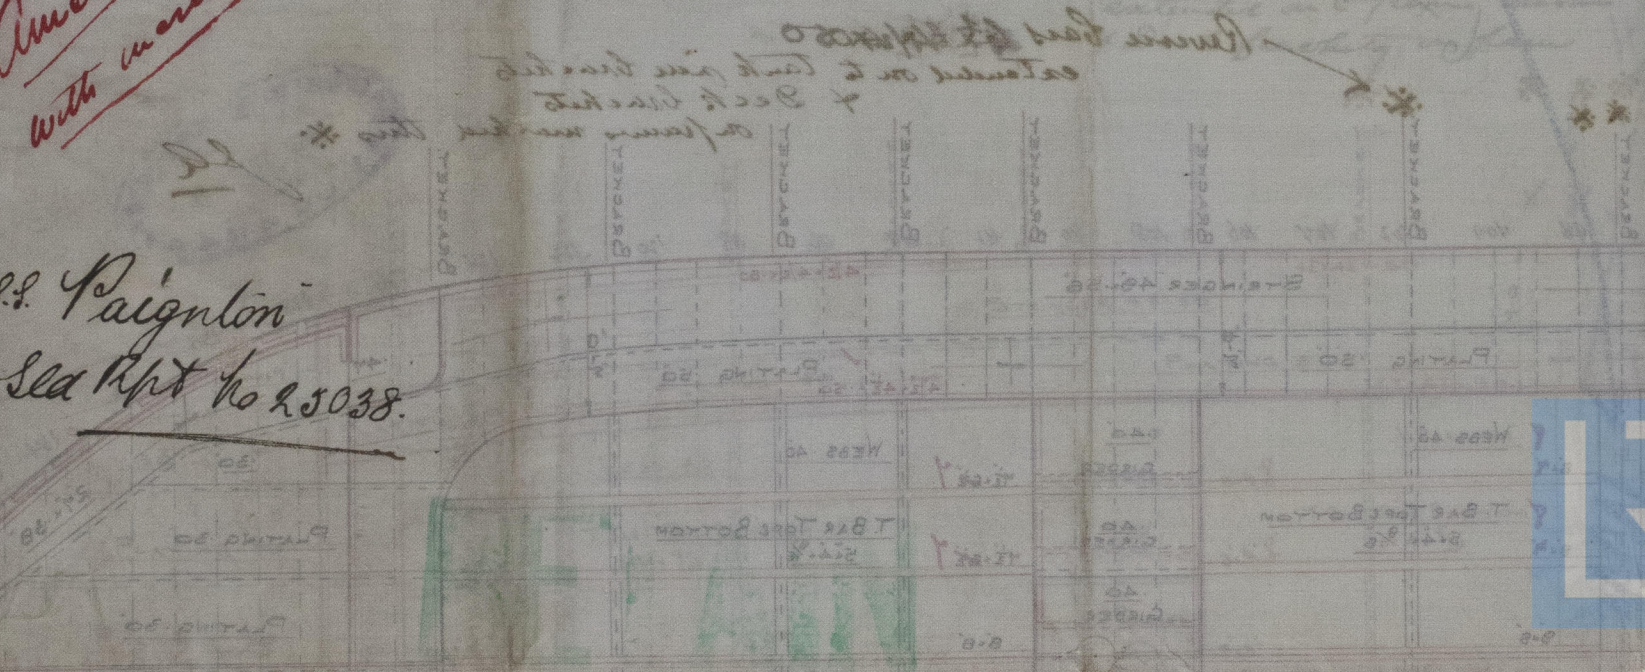

© 2021

Lloyd's Register
Foundation