
 


TSS N° 459
535-0 x 63-0 x 38-0
PROFILE
SCALE 1/8" = 1 FOOT

25. 2. 08

10. 3. 08

19. 3. 08

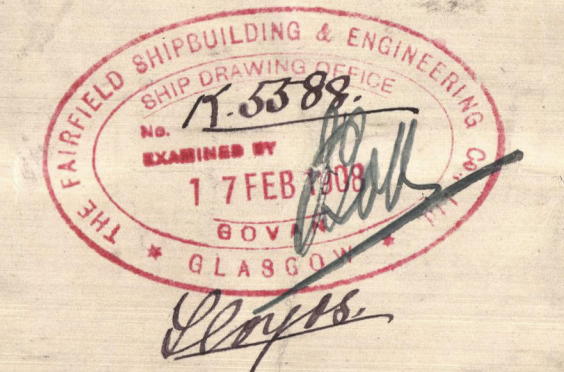

FRS 6" 3/2" x 1/20 ANGLE TO SHELTER DK. REV. FRS 4 1/2" x 1/20 ALT TO UPPER & SHELTER DKS. FORMING 'Y' GIRDER

FRS 8" 3/2" x 1/20 CHANNEL TO SHELTER DK.

FRS IN DOUBLE BOTTOM 3 1/2" x 3 1/2" x 1/20

REV. FRS 3 1/2" x 3 1/2" x 1/20

EXTENT OF DOUBLE BOTTOM

FRAMES 8" 3/2" x 3 1/2" x 1/20 CHANNEL CARRIED TO SHELTER DECK

FRAMES IN DOUBLE BOTTOM 3 1/2" x 3 1/2" x 1/20

REVERSE FRAMES IN DOUBLE BOTTOM 3 1/2" x 3 1/2" x 1/20

FRS 8" 3/2" x 1/20 CHANNEL TO SHELTER DK.

FRS 6" 3/2" x 1/20 ANGLE TO SHELTER DK. REV. FRS 4 1/2" x 1/20 ALT TO UPPER & SHELTER DKS. FORMING 'Y' GIRDER

FRS IN DOUBLE BOTTOM 3 1/2" x 3 1/2" x 1/20

REV. FRS 3 1/2" x 3 1/2" x 1/20

EXTENT OF DOUBLE BOTTOM







25/2/08

The Fairfield S. 13560

No 459

Profile

S.S. "Otway"
Glasgow Report
No 24811.

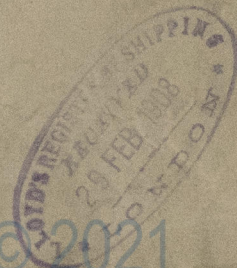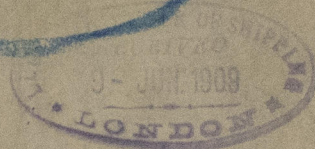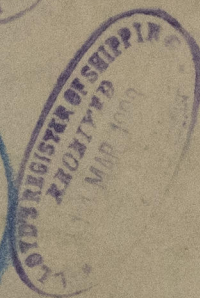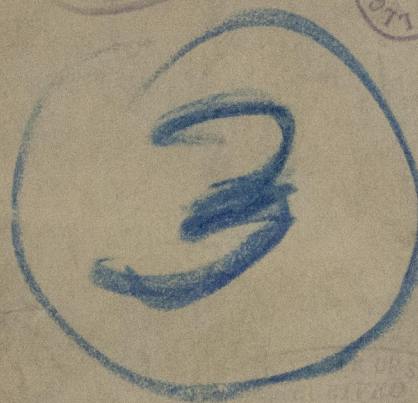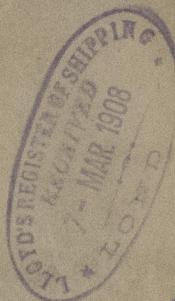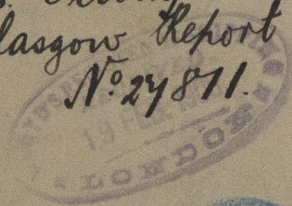

REMAIN



5910-918M



©2021

Lloyd's Register
Foundation