
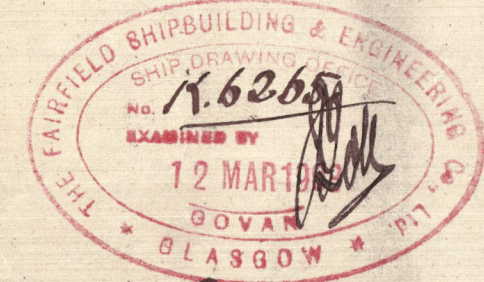
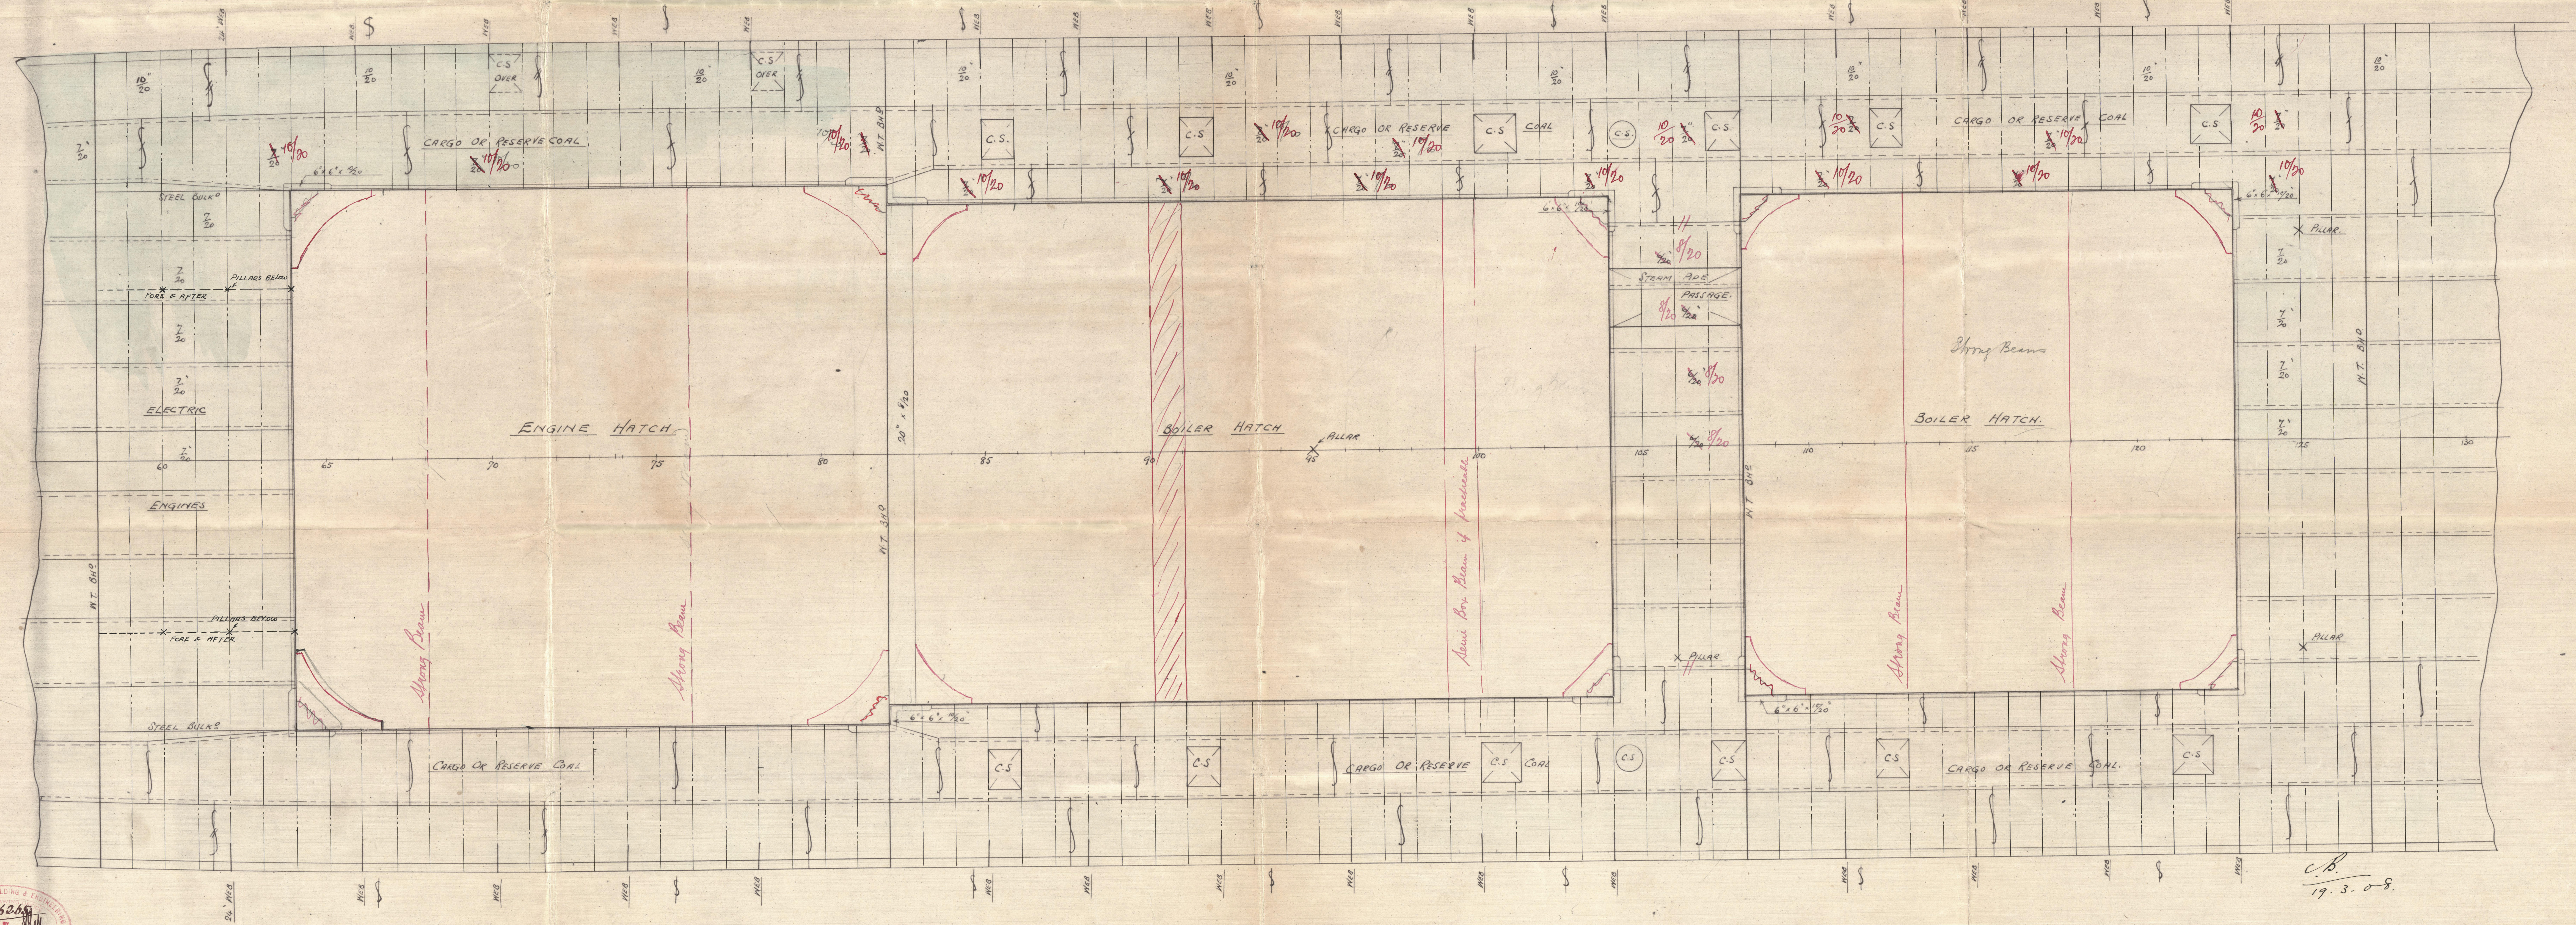


Nº 459.

PLATING & STIFFENING IN WAY OF E.&B. SPACES LOWER DECK


SCALE $\frac{1}{4}$ " = 1 FOOT

19.3.08

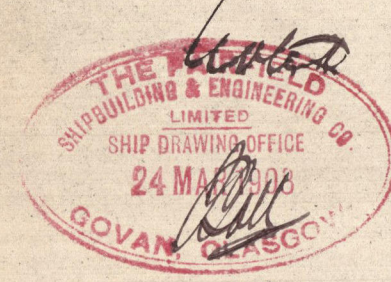


The Fairfield S. B. & Co
No 459

Plan of Lower Deck
in way of Machinery spaces

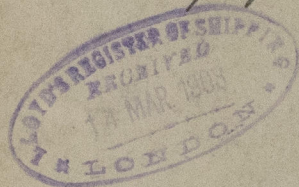

S. S. "Otway"
Glasgow Report
N^o 24811.

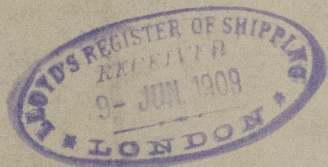

X

//

RETAIN



© 2021

Lloyd's Register
Foundation

W816-0167