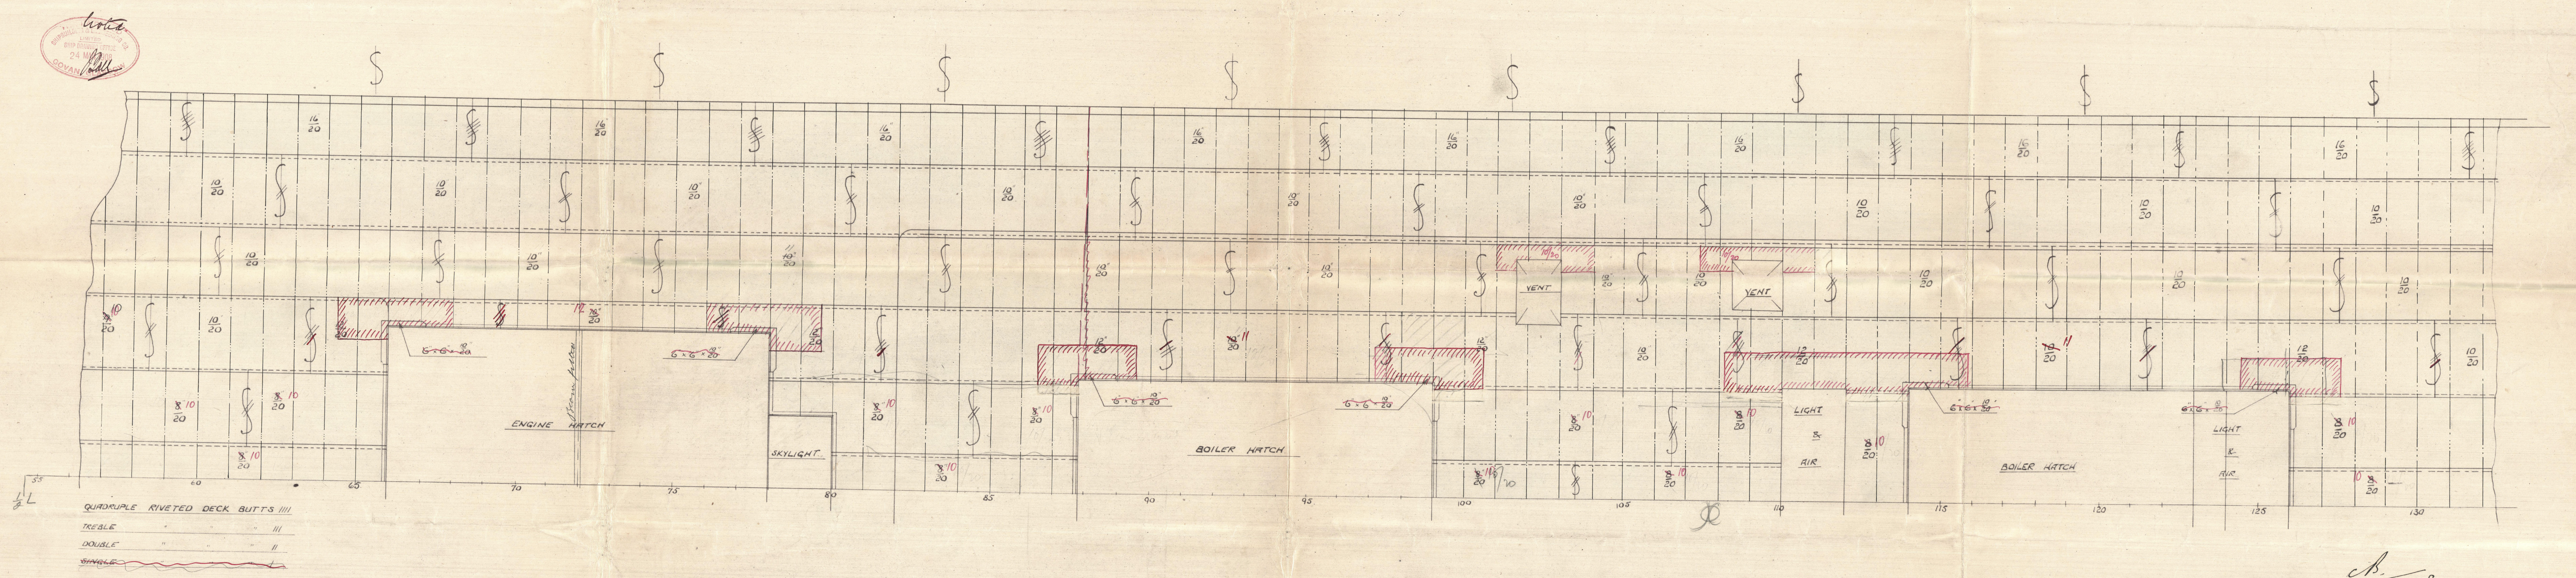

N° 459
SHELTER DECK PLATING IN WAY OF E & B SPACES.
 19.3.08 **SCALE 1/4" = 1 FOOT.**




 156267
 12 MAR 1908
 C.B.

The Fairfield S. B. & Co.

No 459



Plan of Shelter Deck

in way of Machinery spaces

S.S. "Otway"

Glasgow Report

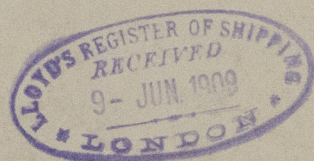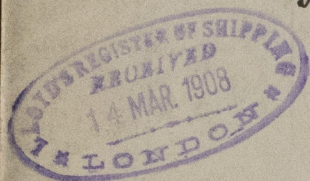No 24811.



RECEIVED

7



© 2021

Lloyd's Register
Foundation

W816-0168