


6/3/08
23/3/08

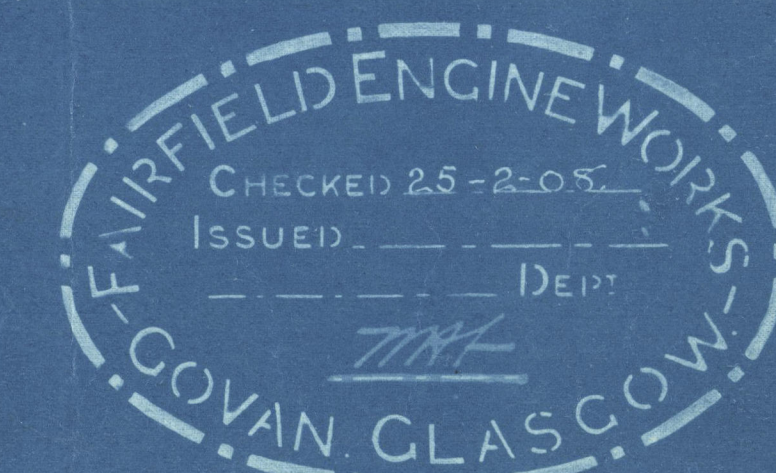


D.E. BOILERS N° 459


SCALE 1" = 1 FOOT

WORKING PRESSURE 215 LBS. PER. SQ. INCH.

RETURN
26

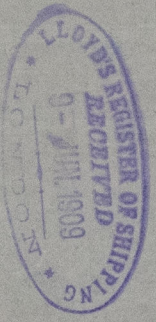

S.S. *Churay*
Glaagou Report
N^o 24871.

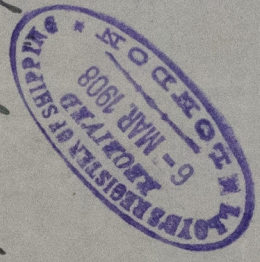

D.E. Boilers N^o 459
To Lloyd's for approval



S.S. D
Yla

D.E. Boiler

W816-0170

D.E. Boiler N° 459.
To Lloyds for approval.

FIELD
OFFICE
1908
ATTN: LLOYD
LONDON

LLOYD'S REGISTER OF SHIPPING
23 MAR 1908
LONDON

